


THIS DRAWING IS THE PROPERTY OF ISGEC YAMUNA NAGAR, IT MUST NOT BE COPIED, LOANED OR USED OTHERWISE THAN FOR THE ORIGINAL CONSTRUCTION OR INSTALLATION OF THE PLANT THERE IN.

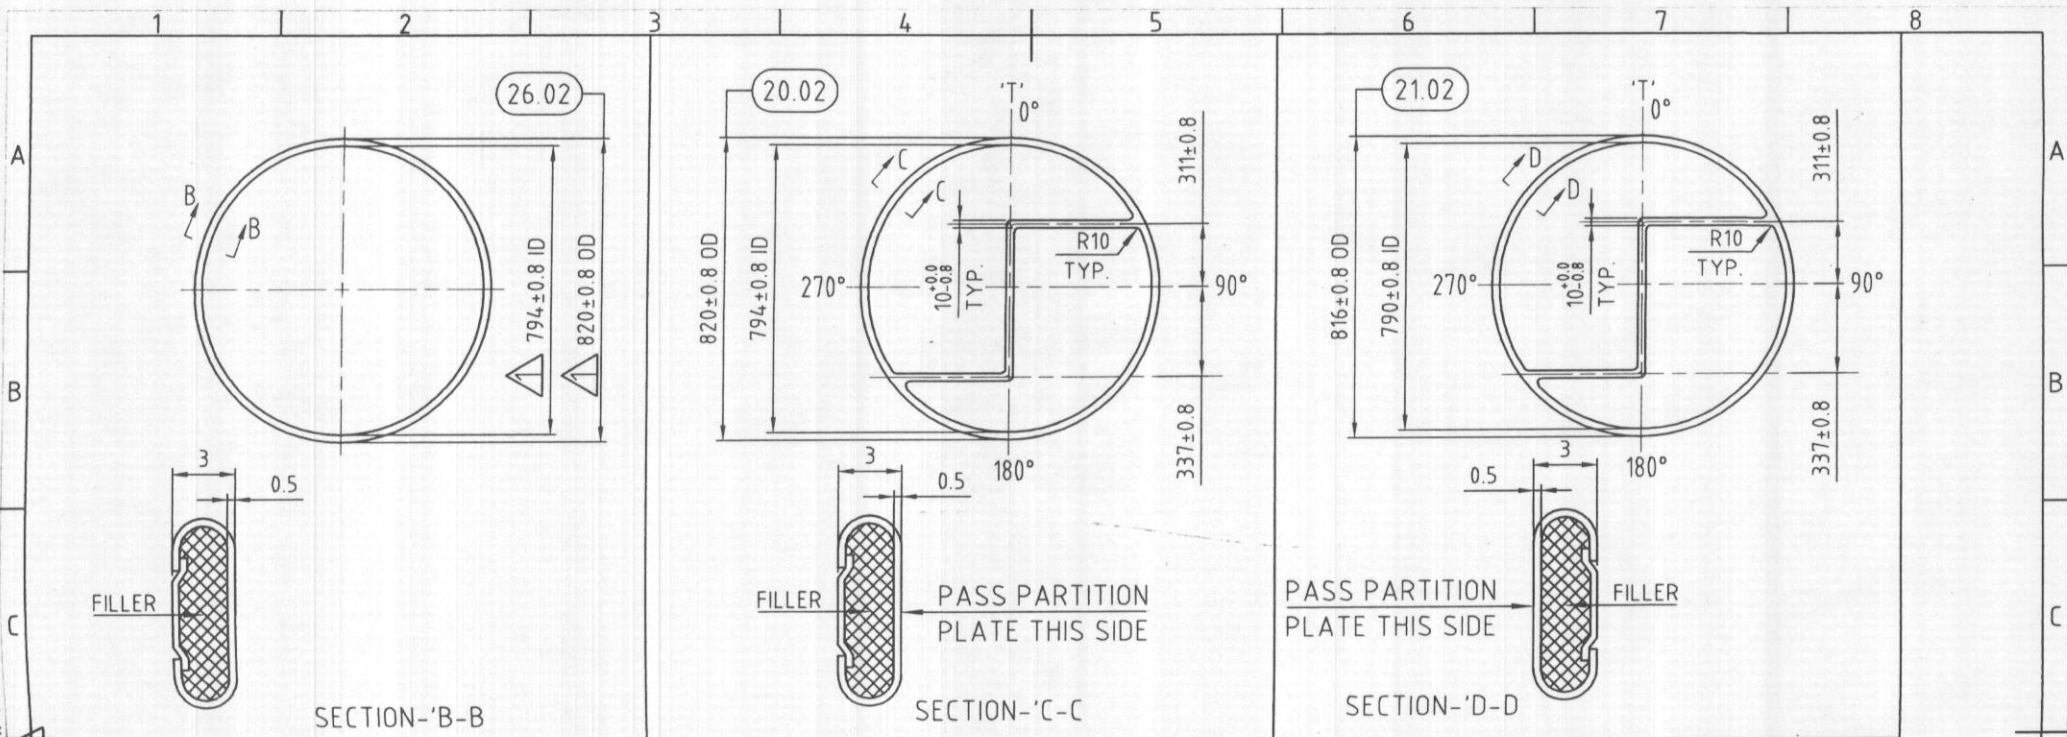

NOTES:

1. ALL DIMENSIONS ARE IN MM.
2. FILLER USED FOR METAL JACKETED GASKETS IS NOT TO BE OF COMPRESSED TYPE & SHALL BE ARAMIDE FIBRE
3. SPIRAL WOUND GASKET FOR NOZZLES SHALL BE SS316, 4.5THK WITH GRAFOIL FILLER AND 3.2 THK CS OUTER RING. DIMENSIONS AS PER ASME B16.20 (1998)

NO OF JOBS REQD. = 2

26.02		5	GASKET	AS PER DRG.	JJA	SAME	1+4	
21.02		5	GASKET	AS PER DRG.	JJA	SAME	1+4	
20.02		5	GASKET	AS PER DRG.	SJA	SAME	1+4	
PART NO.	SAP CODE	QTY.	DESCRIPTION	SIZES	WT. (KG)	MATERIAL	AS BUILT	REMARKS
BILL OF MATERIAL (FOR ONE JOB)								
BCPL BRAHMAPUTRA CRACKER AND POLYMER LIMITED (A Joint Venture Company of GAIL (India) Ltd., OIL, NRI & Govt. of Assam) इंजीनियर्स इंडिया लिमिटेड (भारत सरकार का उपक्रम) ENGINEERS INDIA LIMITED (A Govt. of India Undertaking)								
CERTIFIED Issued for pre-planning Issued for provision of material in shop This drawing supersedes drawing no. _____ Issued by _____ Issued date _____ ☐ For manufacture in shop ☐ For sub contracting / site work Rev. 1								
H.PAL EIL 1971-2010 INSPECTION AUTHORITY YAMUNANAGAR, HARYANA, INDIA								
				TITLE DESCRIPTION CUSTOMER PROJECT P.O. NO. ITEM NO. JOB NO. REGENERATOR REBOILER GASKET DETAILS EIL A/C BCPL BPCP, GSU-LEPETKATA 6907-111-EE-PR-6225/0041 REV 0 111-EE-102 A/B PE-1221-22				
2	25.11.10	VM	YPS	PZR				
1	04.05.10	YPN	YPS	PZR	PZS			
0	22.12.09	YPN	YPS	PZR	PZS			
Rev.	Date	Drawn	Checked	Verified	Approved	DRAWING NO.	2009-PE1221-S6	REV 02

AS BUILT	ZONE	DESCRIPTION	REV.	ZONE	DESCRIPTION
REV.	D/8	AS BUILT MATERIAL ADDED IN B.O.M.		A-B/3	ID & OD OF PT. NO 26.02 WERE 820 & 794
				D/1-3	NOTE NO 3 ADDED IN DRG.