


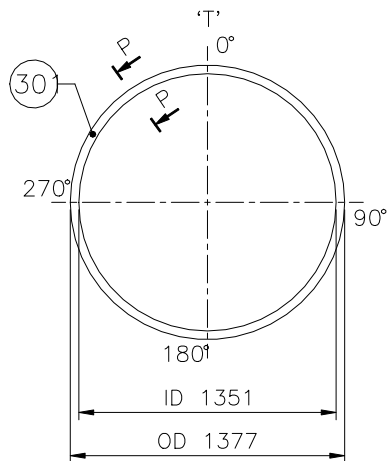
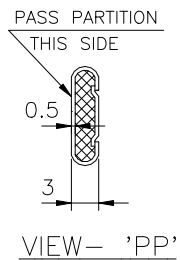
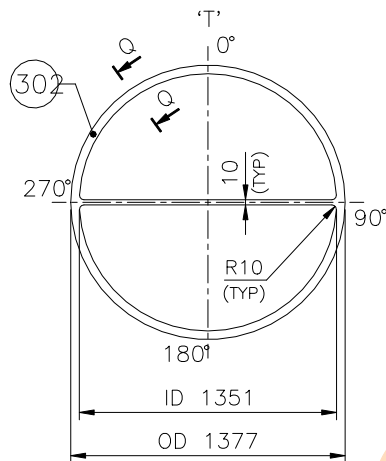


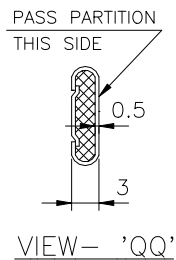

T/S - CH. FLG. GASKET
(L.H.S)

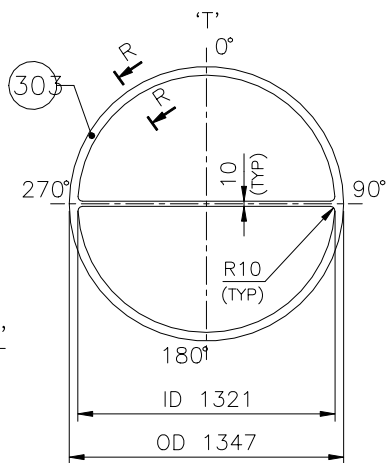

T/S - CH. FLG. GASKET
(R.H.S)

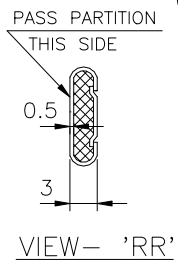

CH. COVER GASKET

303	CH. COVER GASKET	OD 1347 x ID 1321 x 3 THK.	IJA	01	-	
302	CH. FLG. GASKET - RHS	OD 1377 x ID 1351 x 3 THK.	IJA	01	-	
301	CH. FLG. GASKET - LHS	OD 1377 x ID 1351 x 3 THK.	IJA	01	-	
P.No.	DESCRIPTION	SIZE	MATERIAL	QTY.	Wt.,Kgs.	REMARKS

BILL OF MATERIALS

AS BUILT

2	26.08.10	AS BUILT DRAWING	HG	RS	HP
1	04.02.10	CLIENT COMMENTS ARE INCORPORATED	JM	RS	HP
0	15.11.09	FIRST ISSUE - FOR APPROVAL	JM	RS	HP
REV.	DATE	DESCRIPTION	ALT.	CHK.	APPD.

OWNER : BRAHMAPUTRA CRACKER & POLYMER LTD.,
LEPETKATA, ASSAM.


PROJECT : BRAHMAPUTRA PETROCHEMICAL COMPLEX PROJECT,
LEPETKATA, ASSAM.
(UNIT : C2+RECOVERY)

CONSULTANT :  M/s. ENGINEERS INDIA LIMITED,
NEW DELHI.

EIL JOB No. :
6907

MANUFACTURER :  PRECISION EQUIPMENTS (CHENNAI) PVT. LTD.,
CHENNAI, TAMIL NADU, INDIA.

W.O.No. :
1228/2

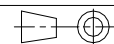DRAWN BY : JM
CHK. BY : RS
APP. BY : HP
PROJ. : 

TITLE : GASKET DETAILS FOR
LEAN GAS COMPRESSOR INTER COOLER
(ITEM No. : 112-EE-111)

PR No. :
6907-112-EE-PR-6275/
0048 REV-0
Dt. : 26.11.09

DRG No. : PE/1000/HE-112-EE-111/09
REV : 2

SHEET : 4 OF 5