

A

B

C

D

E

F


A

B


C

D


E

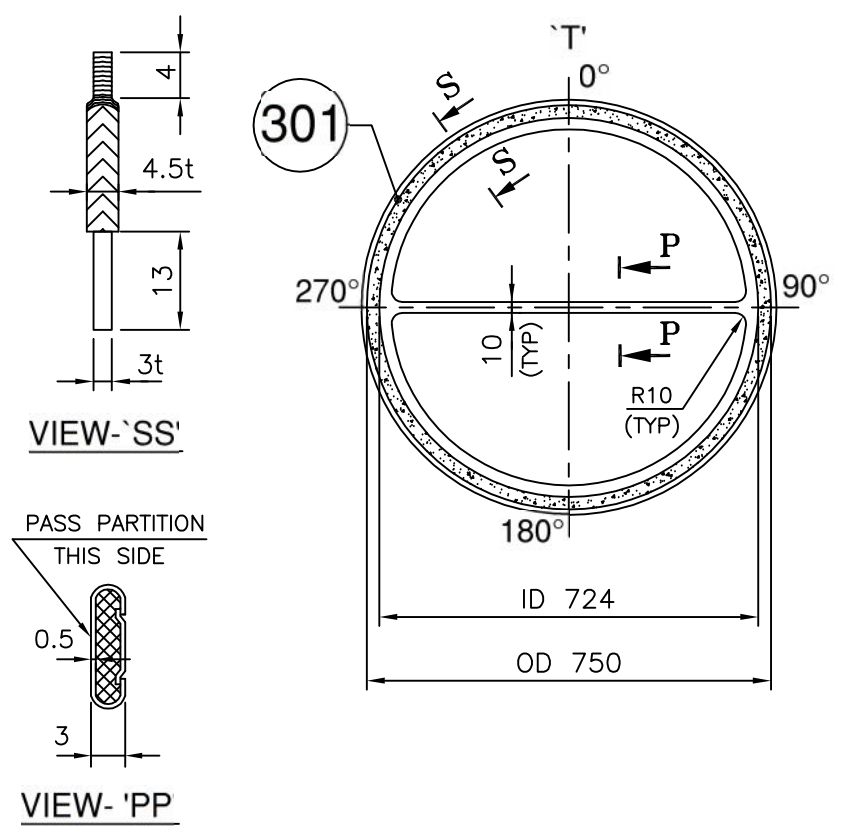

CHANNEL COVER GASKET

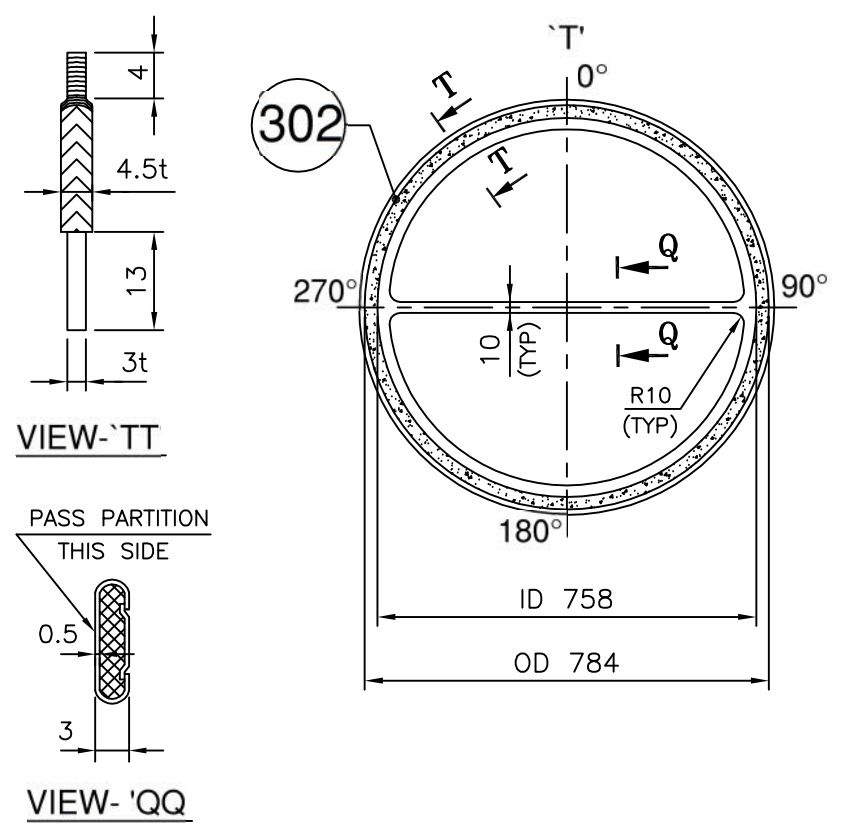

CH. FLG. GASKET(R.H.S)

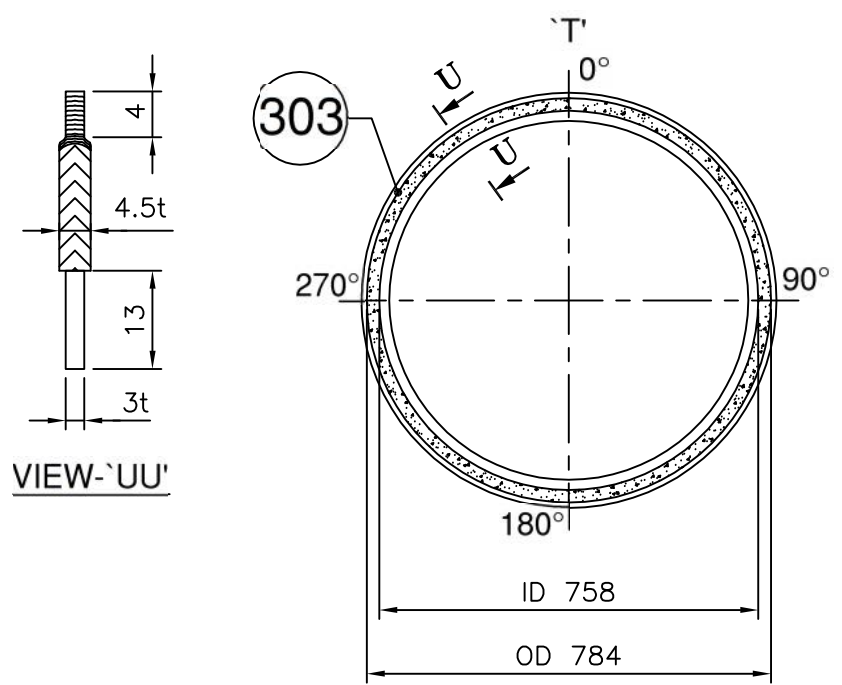


CH. FLG. GASKET(L.H.S)

* SS 321 SPWD WITH GRAFOIL FILLER WITH SS 321 INNER CENTERING RING AND SS 321 OUTER NOSE.

303	GASKET(CH.FLANGE LHS)	OD 784 x ID 758 x 4.5 THK.	*	1	-	
302	GASKET(CH.FLANGE RHS)	OD 784 x ID 758 x 4.5 THK.		1	-	
301	GASKET (CH. COVER)	OD 750 x ID 724 x 4.5 THK.		1	-	
P.No.	DESCRIPTION	SIZE	MATERIAL	QTY.	Wt.,Kgs.	REMARKS

BILL OF MATERIALS

AS BUILT

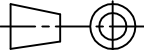2	26.08.10	AS BUILT DRAWING	HG	RS	HP
1	04.02.10	CLIENT COMMENTS ARE INCORPORATED	JM	RS	HP
0	15.11.09	FIRST ISSUE-FOR APPROVAL	PV	RS	HP
REV.	DATE	DESCRIPTION	DRAWN.	CHK.	APPD.
OWNER :		BRAHMAPUTRA CRACKER & POLYMER LTD., LEPETKATA, ASSAM.			
PROJECT :		BRAHMAPUTRA PETROCHEMICAL COMPLEX PROJECT, LEPETKATA, ASSAM. (UNIT : C2+RECOVERY)			
CONSULTANT :		M/s. ENGINEERS INDIA LIMITED, NEW DELHI		EIL JOB No. : 6907	
MANUFACTURER :		PRECISION EQUIPMENTS (CHENNAI) PVT. LTD., CHENNAI, TAMIL NADU, INDIA		W.O.No. : 1228/1	
DRAWN BY : PV		TITLE : GASKET DETAILS FOR RESIDUE GAS COMPRESSOR AFTER COOLER (ITEM No. : 112-EE-112)		PR No. : 6907-112-EE-PR-6275/ 0048 REV-0 Dt. : 26.11.09	
CHK. BY : RS					
APP. BY : HP					
PROJ. : 		DRG No. : PE/999/HE-112-EE-112/09		REV : 2	
SCALE:1:10/NTS		DATE : 15.11.09			
SHEET : 4 OF 5					