


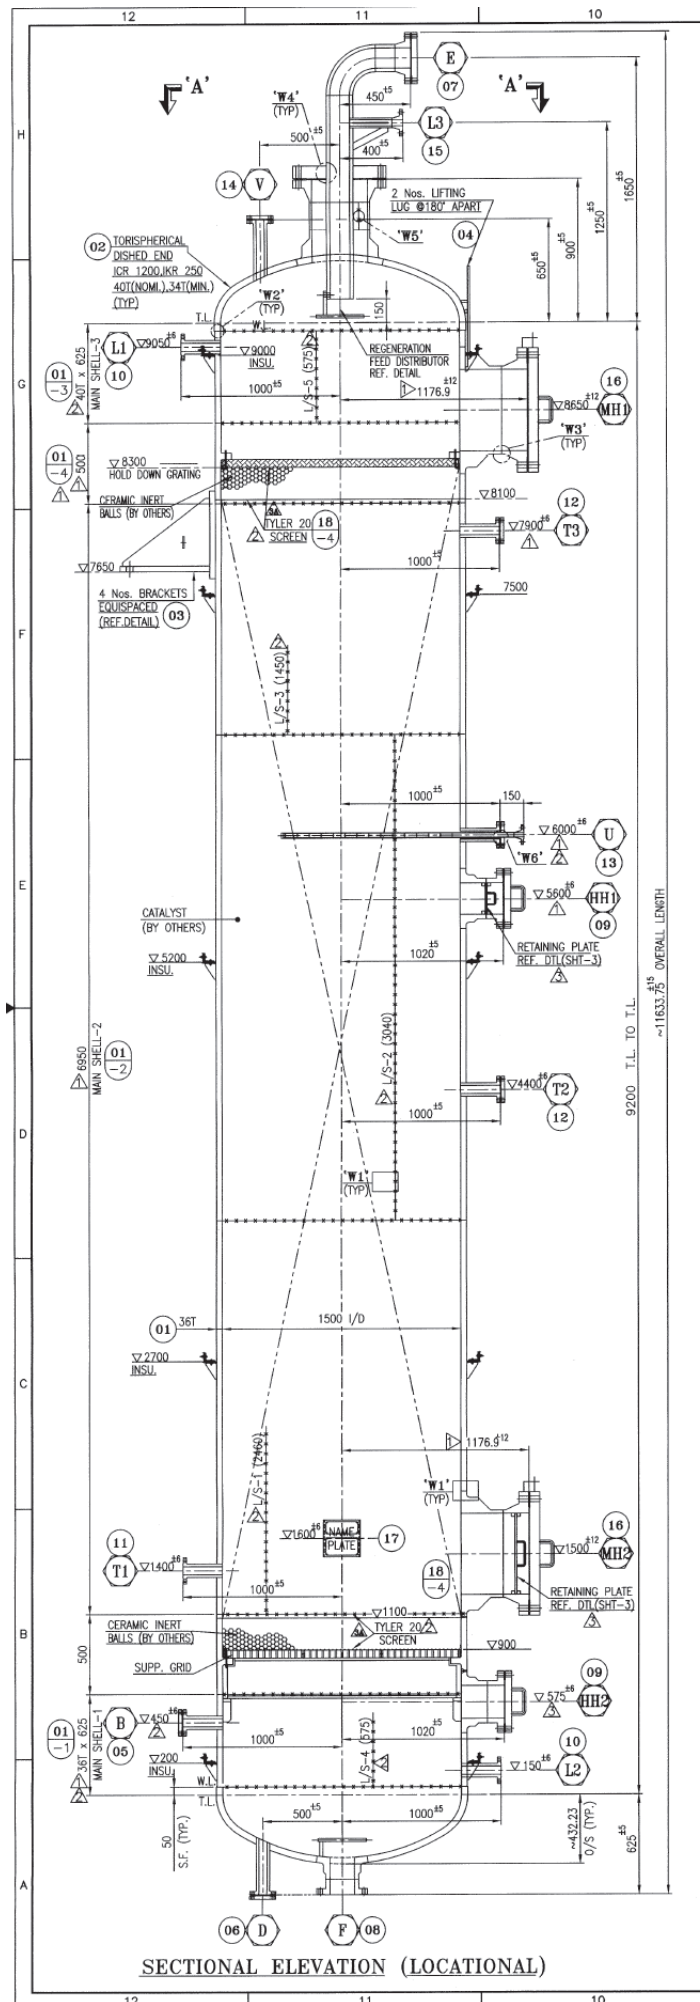

SECTIONAL ELEVATION (LOCATIONAL)

ANNEXURE-II

