

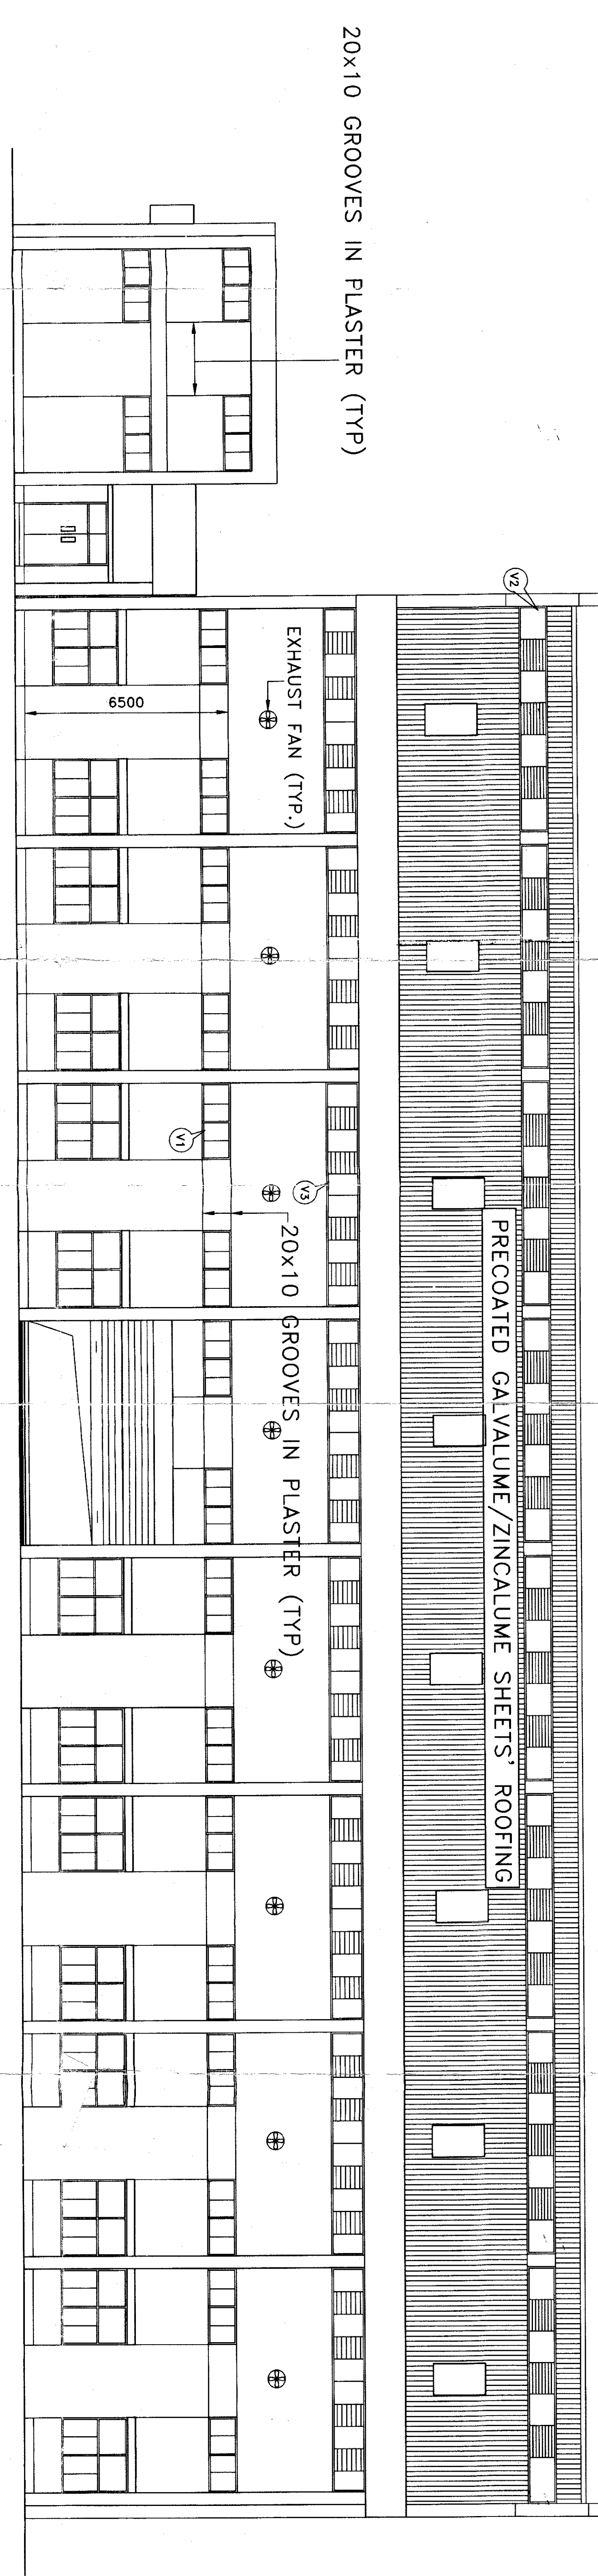


प्रस्तुत आरेख एवं इसमें विहित विवरण इंजीनियर्स इंडिया लिमिटेड की संपत्ति हैं। ये मात्र उधार दिए गए हैं और अपायकाल में यह स्वयं सम्भालना होगा कि यह न तो उन्हें पुनः प्रतिलिखित किया जाए, न काल को वापसी, न उधार दिए जायें, न प्रदर्शित किए जायें और न ही वितरित और किसी प्रकार के अन्वय प्रयोग को अन्वय प्रयोग होगा और वह प्रयोग उधार देने वाले द्वारा अपायकाल को लिखित रूप में ही नहीं सम्भाली से होगा।
The drawing, design and details given on this format are the property of ENGINEERS INDIA LIMITED. They are merely loaned on the borrower's express agreement that they will not be reproduced, copied, exhibited or used, except in the limited way permitted by a written consent given by the lender to the borrower for the intended use.


6907-010-16-48-0191

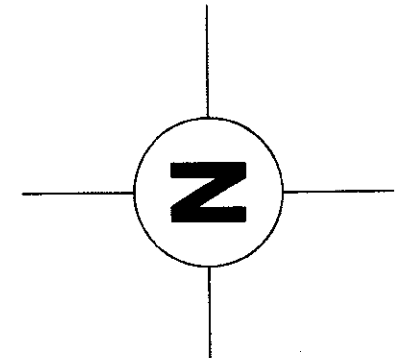

RIGHT SIDE ELEVATION

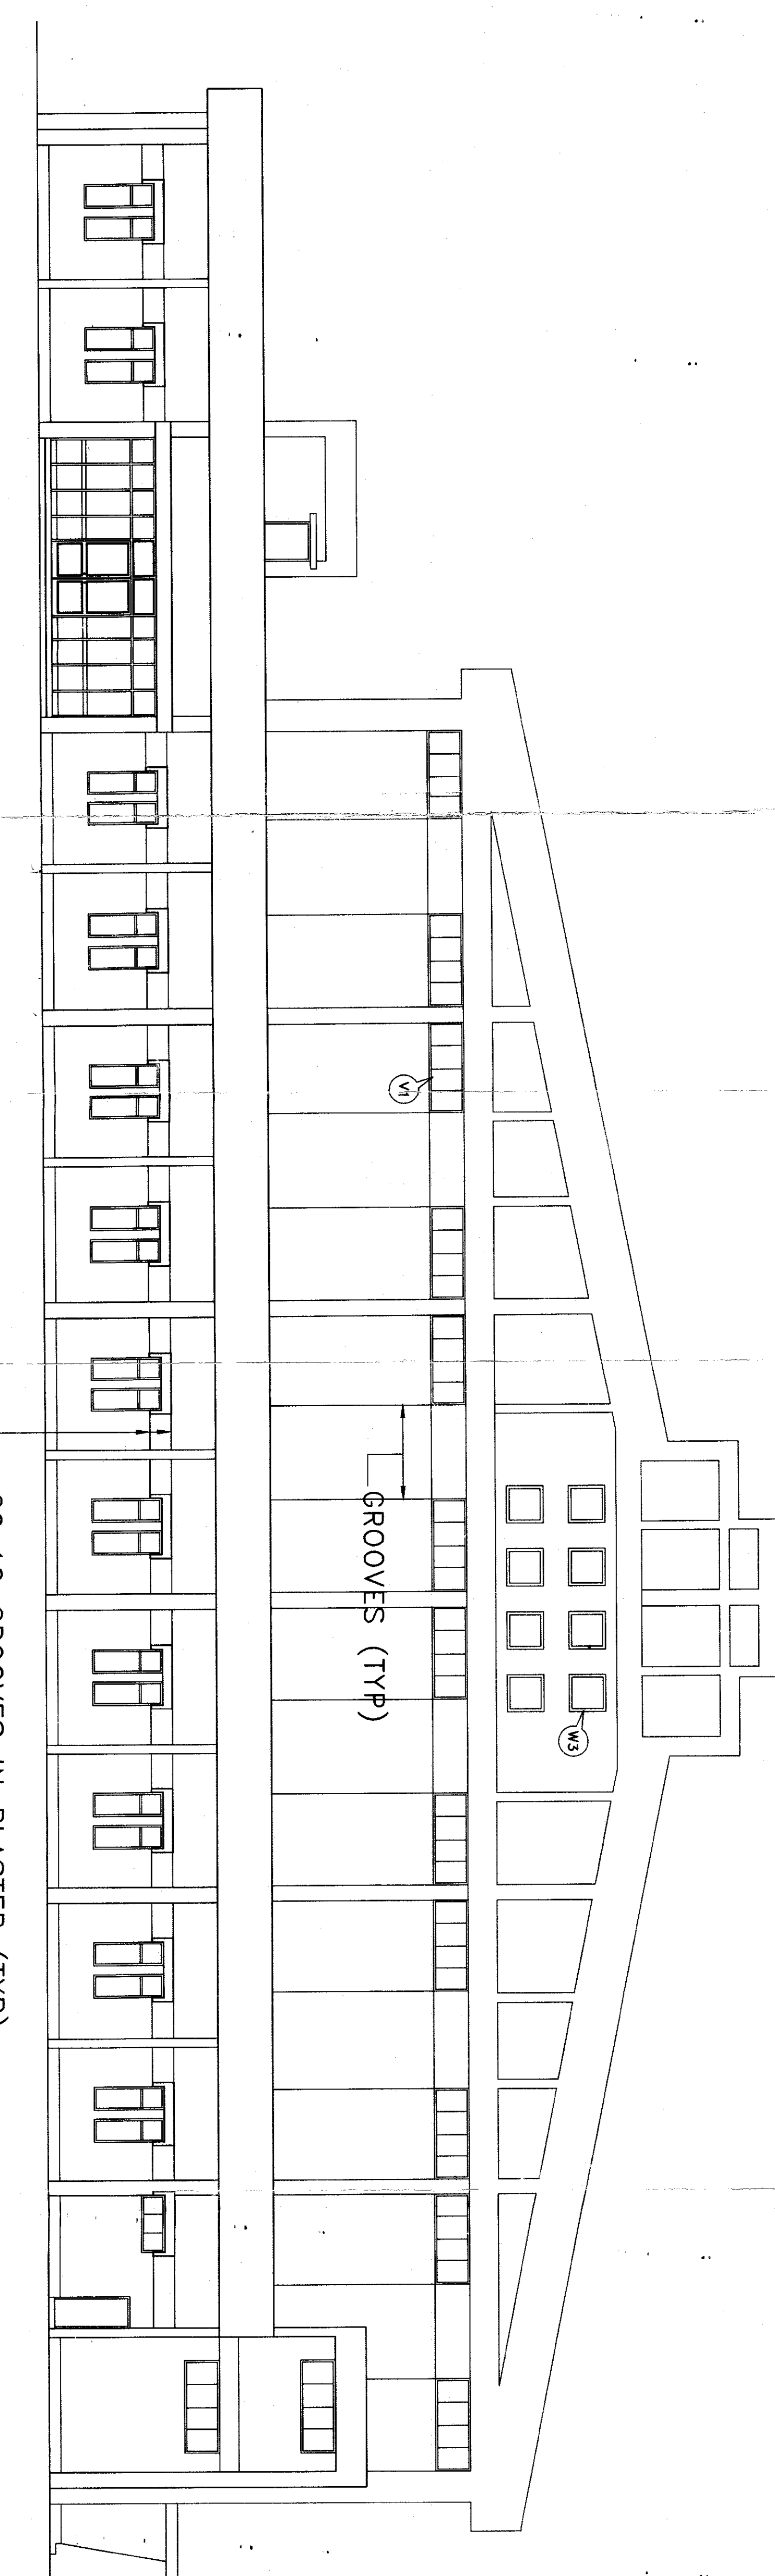

FRONT ELEVATION

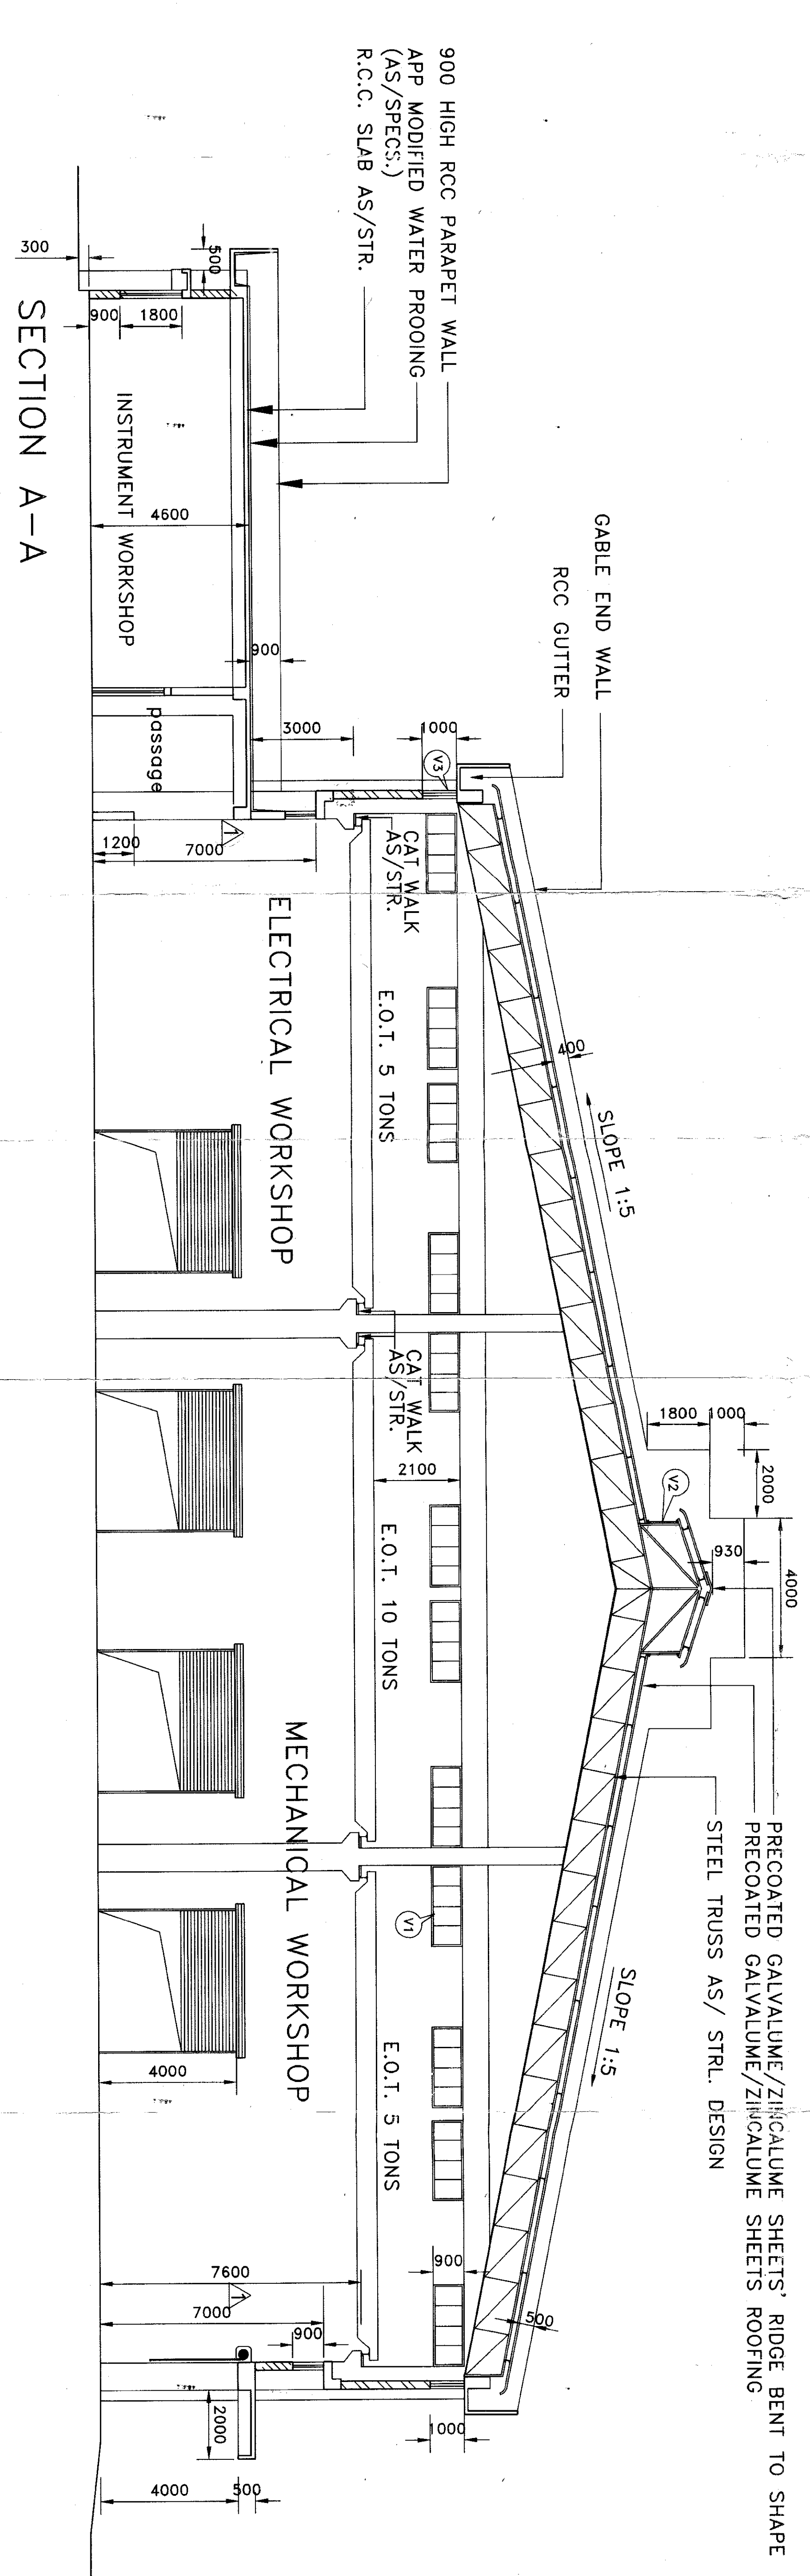

SECTION A-A

REF. DWG. NO.		REFERENCE DRAWING TITLE	
6907-010-16-48-0191	PLAN	GROUND FLOOR PLAN	
6907-010-16-48-0191	SECTION	SECTION A-A	
6907-010-16-48-0191	SECTION	SECTION B-B	
6907-010-16-48-0191	SECTION	SECTION C-C	
6907-010-16-48-0191	SECTION	SECTION D-D	
6907-010-16-48-0191	SECTION	SECTION E-E	
6907-010-16-48-0191	SECTION	SECTION F-F	
6907-010-16-48-0191	SECTION	SECTION G-G	
6907-010-16-48-0191	SECTION	SECTION H-H	
6907-010-16-48-0191	SECTION	SECTION I-I	
6907-010-16-48-0191	SECTION	SECTION J-J	
6907-010-16-48-0191	SECTION	SECTION K-K	
6907-010-16-48-0191	SECTION	SECTION L-L	
6907-010-16-48-0191	SECTION	SECTION M-M	
6907-010-16-48-0191	SECTION	SECTION N-N	
6907-010-16-48-0191	SECTION	SECTION O-O	
6907-010-16-48-0191	SECTION	SECTION P-P	
6907-010-16-48-0191	SECTION	SECTION Q-Q	
6907-010-16-48-0191	SECTION	SECTION R-R	
6907-010-16-48-0191	SECTION	SECTION S-S	
6907-010-16-48-0191	SECTION	SECTION T-T	
6907-010-16-48-0191	SECTION	SECTION U-U	
6907-010-16-48-0191	SECTION	SECTION V-V	
6907-010-16-48-0191	SECTION	SECTION W-W	
6907-010-16-48-0191	SECTION	SECTION X-X	
6907-010-16-48-0191	SECTION	SECTION Y-Y	
6907-010-16-48-0191	SECTION	SECTION Z-Z	

AS BUILT DWG

1	4.400	ROOF AS MARKED & BUILT FOR CONSTRUCTION	DATE	16/11/2007
2	4.400	ROOF AS MARKED & BUILT FOR CONSTRUCTION	DATE	16/11/2007
SCALE	1:200	JOB NO.	6907-010-16-48-0191	UNIT	MM	DWG. NO.	6907-010-16-48-0191	REV.	1
DATE	16/11/2007	BY	16/11/2007	CHECKED	16/11/2007	DATE	16/11/2007	BY	16/11/2007

16/11/2007