

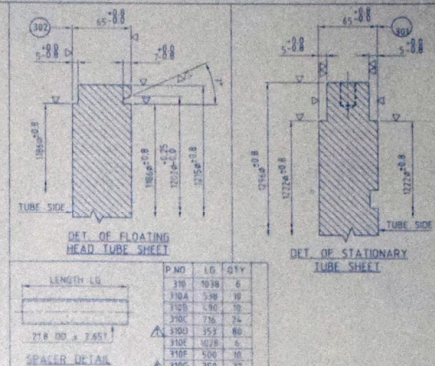
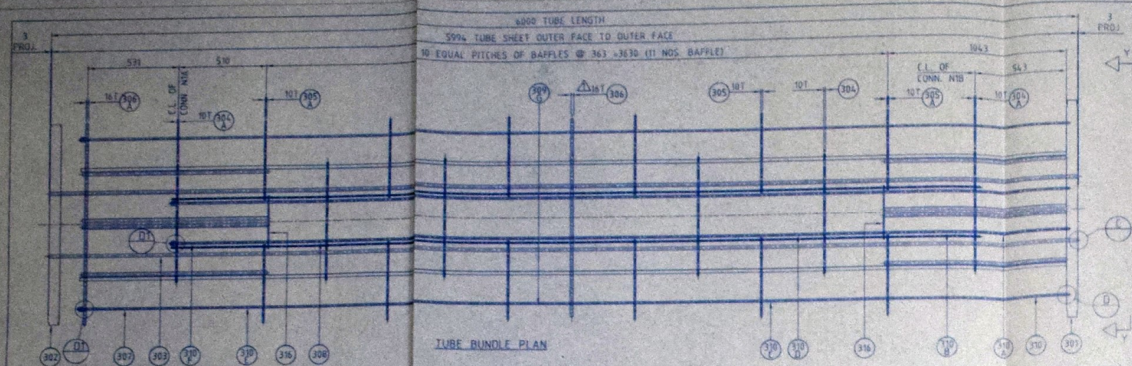
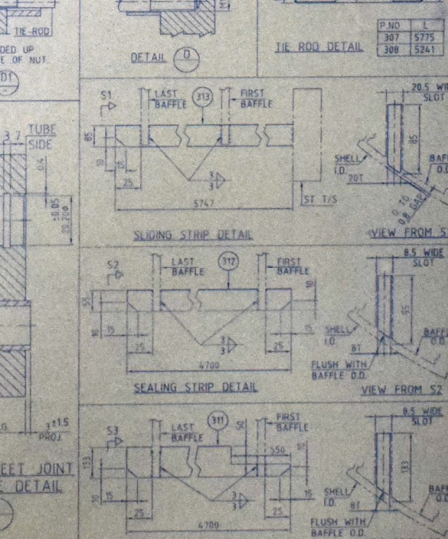
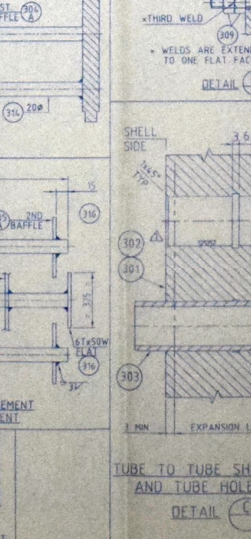
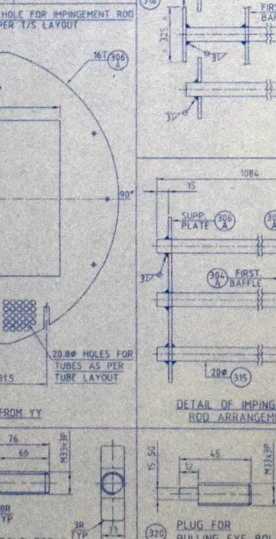
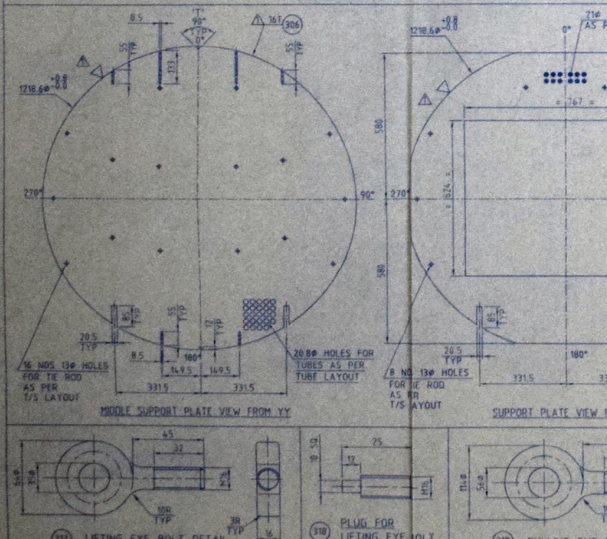
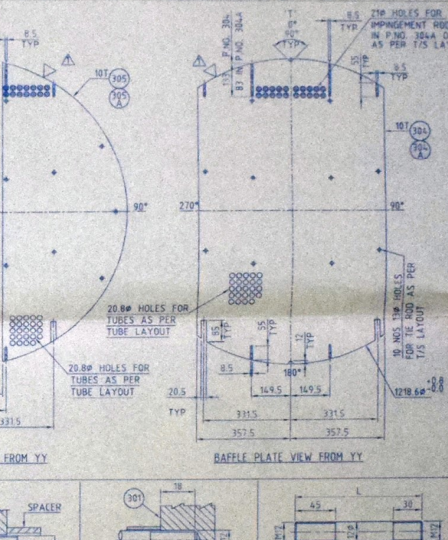
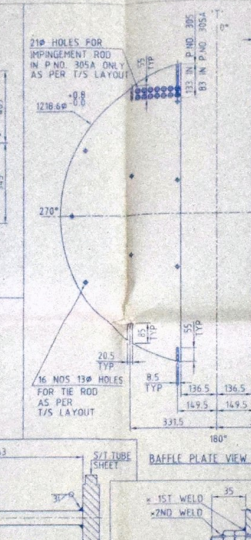


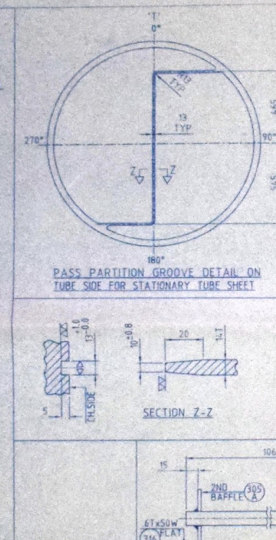

P.M.O.	L.G.	QTY
310	1010	6
310A	530	10
310B	140	20
310C	74	24
310D	153	80
310E	10/8	6
310F	100	10
310G	350	27

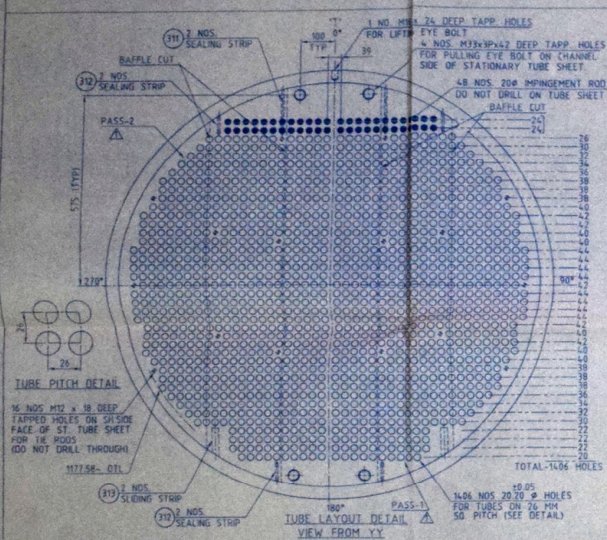

320	SOLEHEAD PLUG	4	SA 105	M33 x 100 DETAIL
330	PULLING EYE BOLT	4	SA 105	M33 x 100 DETAIL
330A	SOLEHEAD PLUG	1	SA 105	M16 x 100 DETAIL
331	LIFTING EYE BOLT	1	SA 105	M16 x 100 DETAIL
332	PLATE	4	IS 2062 GR B	157 x 350 x 100 LG
333	IMPINGEMENT ROD	18	IS 2062 GR B	204 x 100 LG
334	IMPINGEMENT ROD	48	IS 2062 GR B	204 x 100 LG
335	SLIDING STRIP	2	SA 516 GR 60	207 x 85 M x 5247 LG
336	SEALING STRIP	4	SA 516 GR 60	87 x 35 M x 4700 LG
337	SEALING STRIP	2	SA 516 GR 60	87 x 133 M x 4700 LG
338	SPACER	10	SA 194 GR 2H	218 OD x 245 THK x AS PER DETAIL
339	HEX NUT	32	SA 194 GR 2H	M12 STD.
340	TE ROD	8	IS 2062 GR B	100 x 100 DETAIL
341	TE ROD	8	IS 2062 GR B	100 x 100 DETAIL
342	MIDDLE SUPPORT PLATE	1	IS 2062 GR B	167 x 45 PER DETAIL
343	BAFFLE PLATE	2	IS 2062 GR B	167 x 45 PER DETAIL
344	BAFFLE PLATE	4	IS 2062 GR B	167 x 45 PER DETAIL
345	BAFFLE PLATE	2	IS 2062 GR B	167 x 45 PER DETAIL
346	TUBES	1408	SA 199	30 O.D. x 2.01 THK x 6000 LG
347	FLOATING HO. TUBE SHEET	1	SA 516 GR 60	857 x 1215 #
348	STATIONARY TUBE SHEET	1	SA 516 GR 60	651 x 1215 #
P.M.O.	DESCRIPTION	QTY	MATERIAL	SIZE

2	11/07/17	NO CHANGE AS BUILT DRG	SAGAR	DRG
1	12/12/17	DRAWING REVISE AS PER CLIENT COMMENT AS MARK	KANAKA	REV
1	12/12/17	REVISION	REV	BY
CLIENT	BRAHMAPUTRA CRACKER & POLYMER LIMITED			
CONSULTANT	SAGAR ENGINEERS INDIA LIMITED			
PROJECT NO.	6907-113-EE-PR-6515/0249 REV. 0			
PROJECT NO.	6907-113-EE-PR-6515/0249 REV. 0			
MANUFACTURE	PATEL AIRTEMP (INDIA) LTD.			
TITLE	PART DETAIL OF CHARGE GAS COMPRESSOR 2ND STAGE AFTERCOOLER			
ITEM NO.	10-EE-201	QTY	ONE	SHEET NO
REVISED BY	MR. S. SINGH	SCALE	N.T.S	4 OF 6 PHE 25410-01