


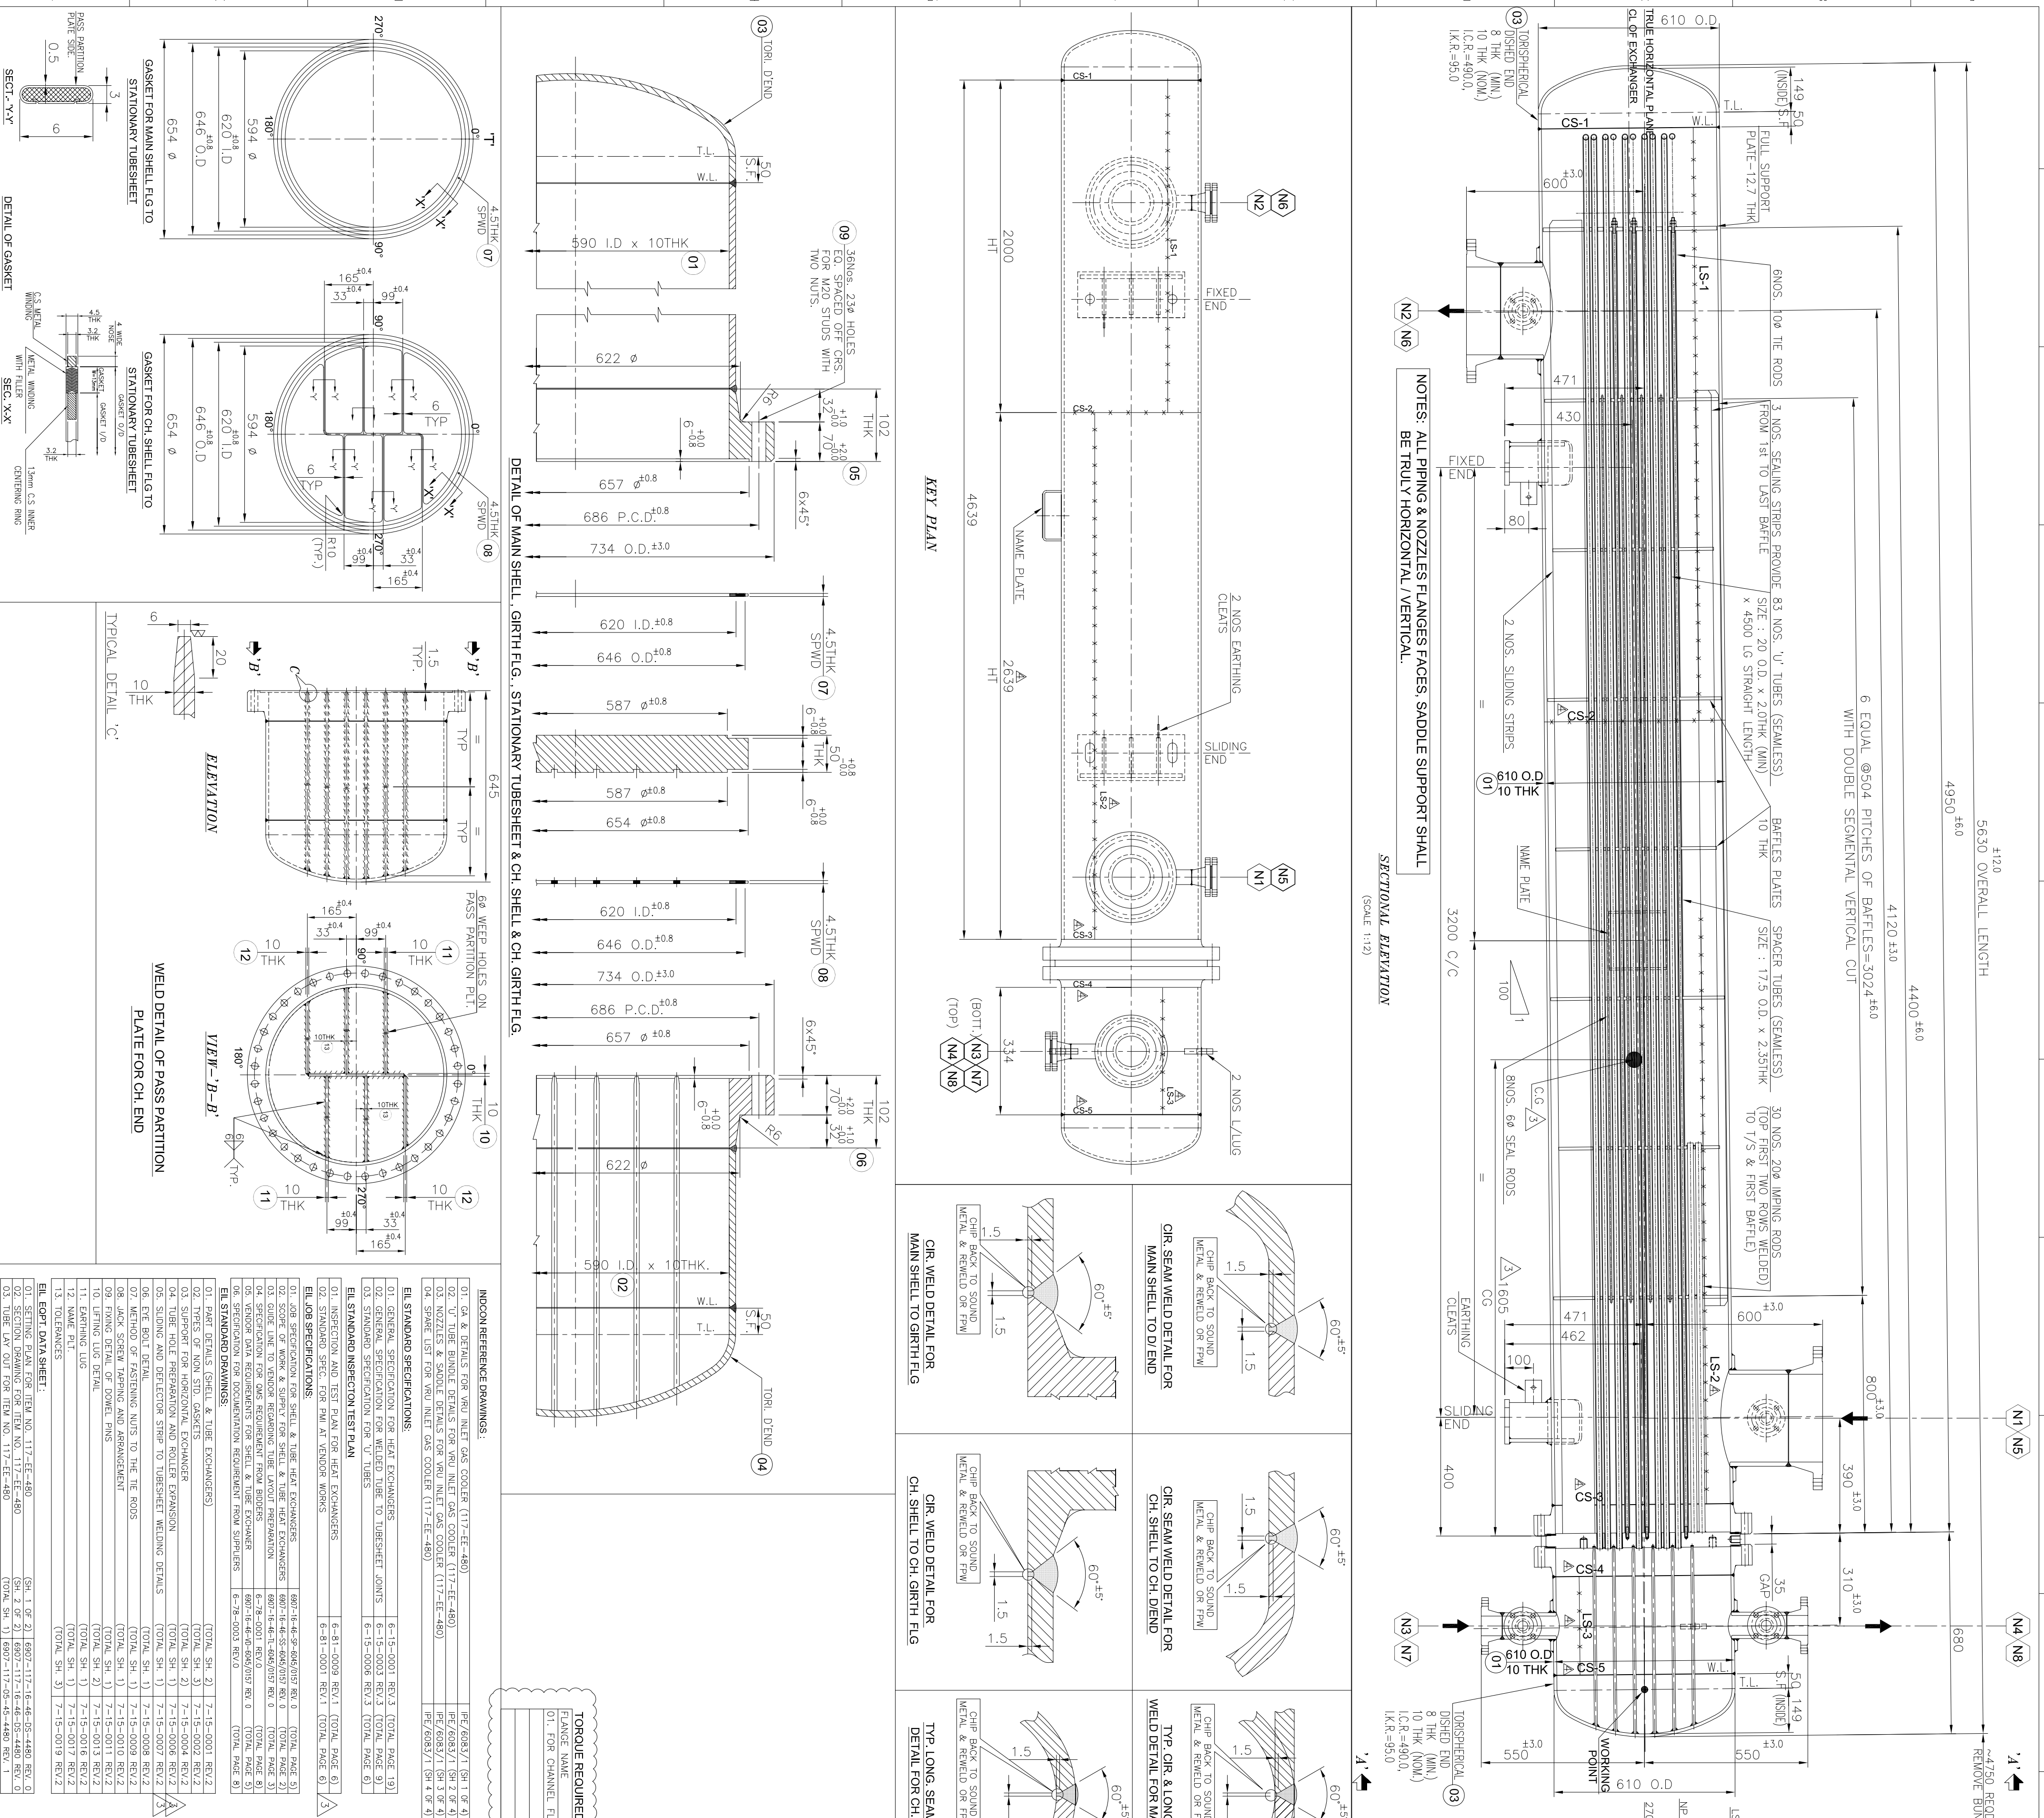

FOR FLANGES

FOR FLANGE (PART NO.08) AND SHELL FLANGE (PART NO.05)

NO.	DESCRIPTION	QTY.	SIZE
01	MAIN SHELL	1	1885 GR x 10 THK x 4530 LG
02	CHANNEL SHELL	1	SA 516 GR 60 x 10 THK x 334 LG
03	DISHED END	1	SA 516 GR 60
04	CHA. FOSHER END	1	SA 516 GR 60
05	SHELL FLANGE CHANNEL SIDE	2	SA 266 CL 4
06	FLANGE CHANNEL SIDE	2	SA 266 CL 4
07	GASKET	1	114.4 4.5 THK AS PER DETAIL
08	GASKET	1	114.4 4.5 THK AS PER DETAIL
09	STUDS & TWO NUTS	36x8	W20 x 235 LG.
10	PARTITION PLATE (FOR CH.)	2	289 x 630 x 10 THK
11	PARTITION PLATE (FOR CH.)	2	273 x 623 x 10 THK
12	PARTITION PLATE (FOR CH.)	2	330 x 631 x 10 THK
13	PARTITION PLATE (FOR CH.)	2	289 x 630 x 10 THK

FOR CHANNEL COVER

FOR CHANNEL COVER (PART NO.09)

NO.	DESCRIPTION	QTY.	SIZE
01	MAIN SHELL	1	1885 GR x 10 THK x 4530 LG
02	CHANNEL SHELL	1	SA 516 GR 60 x 10 THK x 334 LG
03	DISHED END	1	SA 516 GR 60
04	CHA. FOSHER END	1	SA 516 GR 60
05	SHELL FLANGE CHANNEL SIDE	2	SA 266 CL 4
06	FLANGE CHANNEL SIDE	2	SA 266 CL 4
07	GASKET	1	114.4 4.5 THK AS PER DETAIL
08	GASKET	1	114.4 4.5 THK AS PER DETAIL
09	STUDS & TWO NUTS	36x8	W20 x 235 LG.
10	PARTITION PLATE (FOR CH.)	2	289 x 630 x 10 THK
11	PARTITION PLATE (FOR CH.)	2	273 x 623 x 10 THK
12	PARTITION PLATE (FOR CH.)	2	330 x 631 x 10 THK
13	PARTITION PLATE (FOR CH.)	2	289 x 630 x 10 THK

NOZZLE ORIENTATION (VIEW-A-1)

NOZZLE ORIENTATION (VIEW-A-2)

FOR FLANGES

FOR FLANGE (PART NO.08) AND SHELL FLANGE (PART NO.05)

NO.	DESCRIPTION	QTY.	SIZE
01	MAIN SHELL	1	1885 GR x 10 THK x 4530 LG
02	CHANNEL SHELL	1	SA 516 GR 60 x 10 THK x 334 LG
03	DISHED END	1	SA 516 GR 60
04	CHA. FOSHER END	1	SA 516 GR 60
05	SHELL FLANGE CHANNEL SIDE	2	SA 266 CL 4
06	FLANGE CHANNEL SIDE	2	SA 266 CL 4
07	GASKET	1	114.4 4.5 THK AS PER DETAIL
08	GASKET	1	114.4 4.5 THK AS PER DETAIL
09	STUDS & TWO NUTS	36x8	W20 x 235 LG.
10	PARTITION PLATE (FOR CH.)	2	289 x 630 x 10 THK
11	PARTITION PLATE (FOR CH.)	2	273 x 623 x 10 THK
12	PARTITION PLATE (FOR CH.)	2	330 x 631 x 10 THK
13	PARTITION PLATE (FOR CH.)	2	289 x 630 x 10 THK

FOR CHANNEL COVER

FOR CHANNEL COVER (PART NO.09)

NO.	DESCRIPTION	QTY.	SIZE
01	MAIN SHELL	1	1885 GR x 10 THK x 4530 LG
02	CHANNEL SHELL	1	SA 516 GR 60 x 10 THK x 334 LG
03	DISHED END	1	SA 516 GR 60
04	CHA. FOSHER END	1	SA 516 GR 60
05	SHELL FLANGE CHANNEL SIDE	2	SA 266 CL 4
06	FLANGE CHANNEL SIDE	2	SA 266 CL 4
07	GASKET	1	114.4 4.5 THK AS PER DETAIL
08	GASKET	1	114.4 4.5 THK AS PER DETAIL
09	STUDS & TWO NUTS	36x8	W20 x 235 LG.
10	PARTITION PLATE (FOR CH.)	2	289 x 630 x 10 THK
11	PARTITION PLATE (FOR CH.)	2	273 x 623 x 10 THK
12	PARTITION PLATE (FOR CH.)	2	330 x 631 x 10 THK
13	PARTITION PLATE (FOR CH.)	2	289 x 630 x 10 THK

[illegible]

