
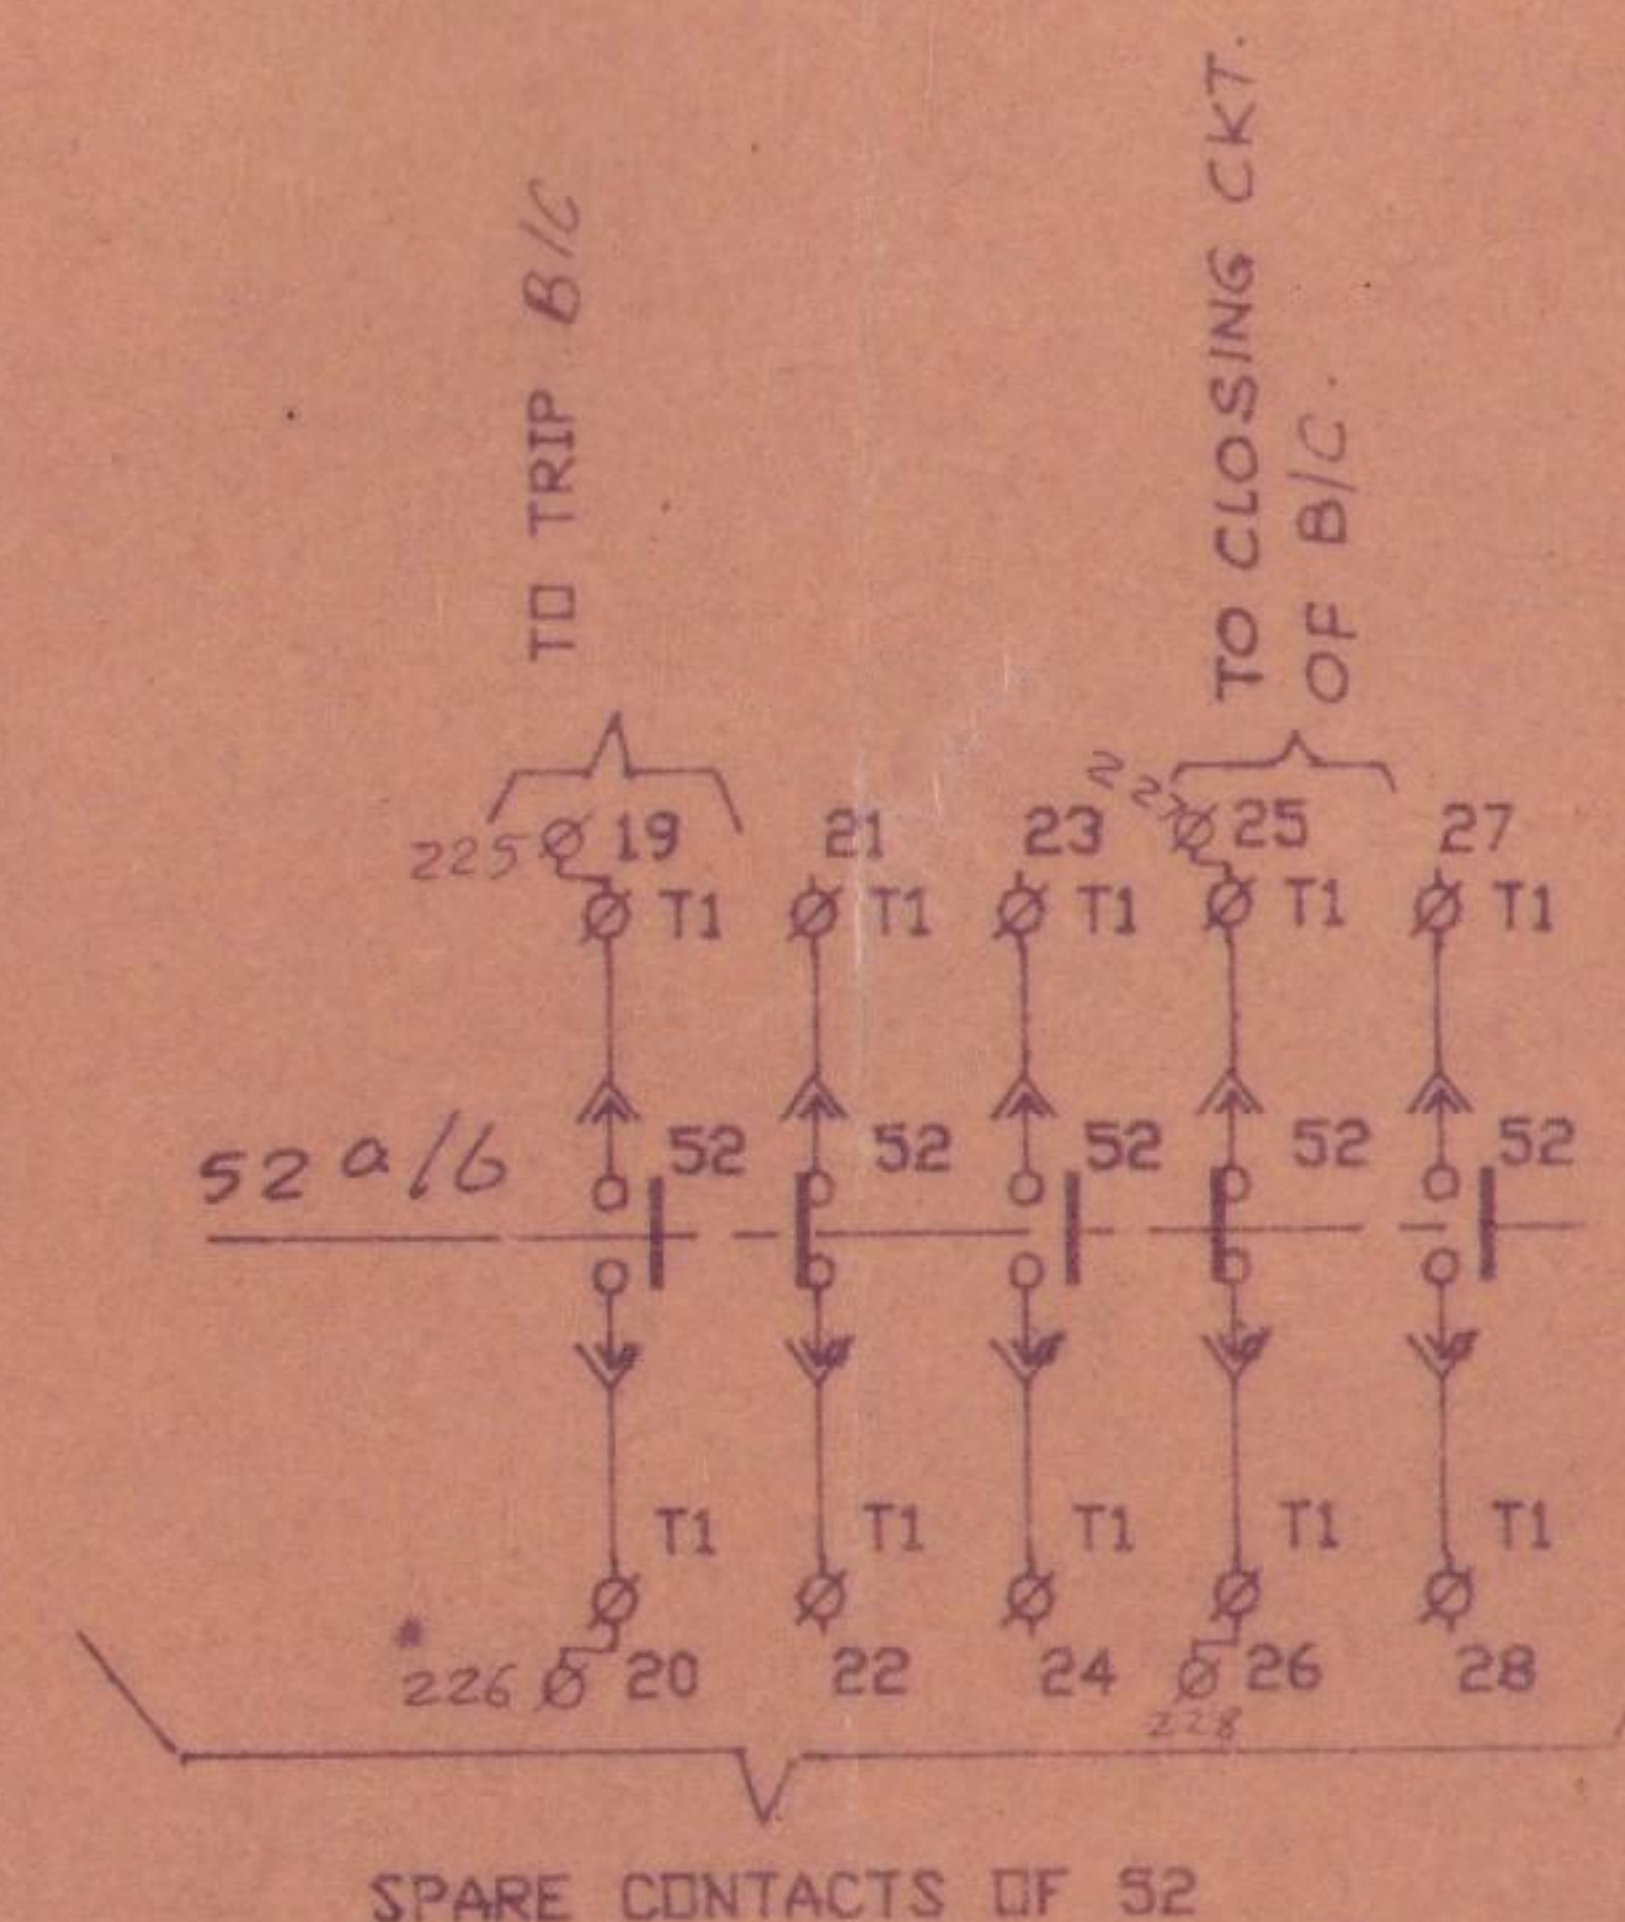


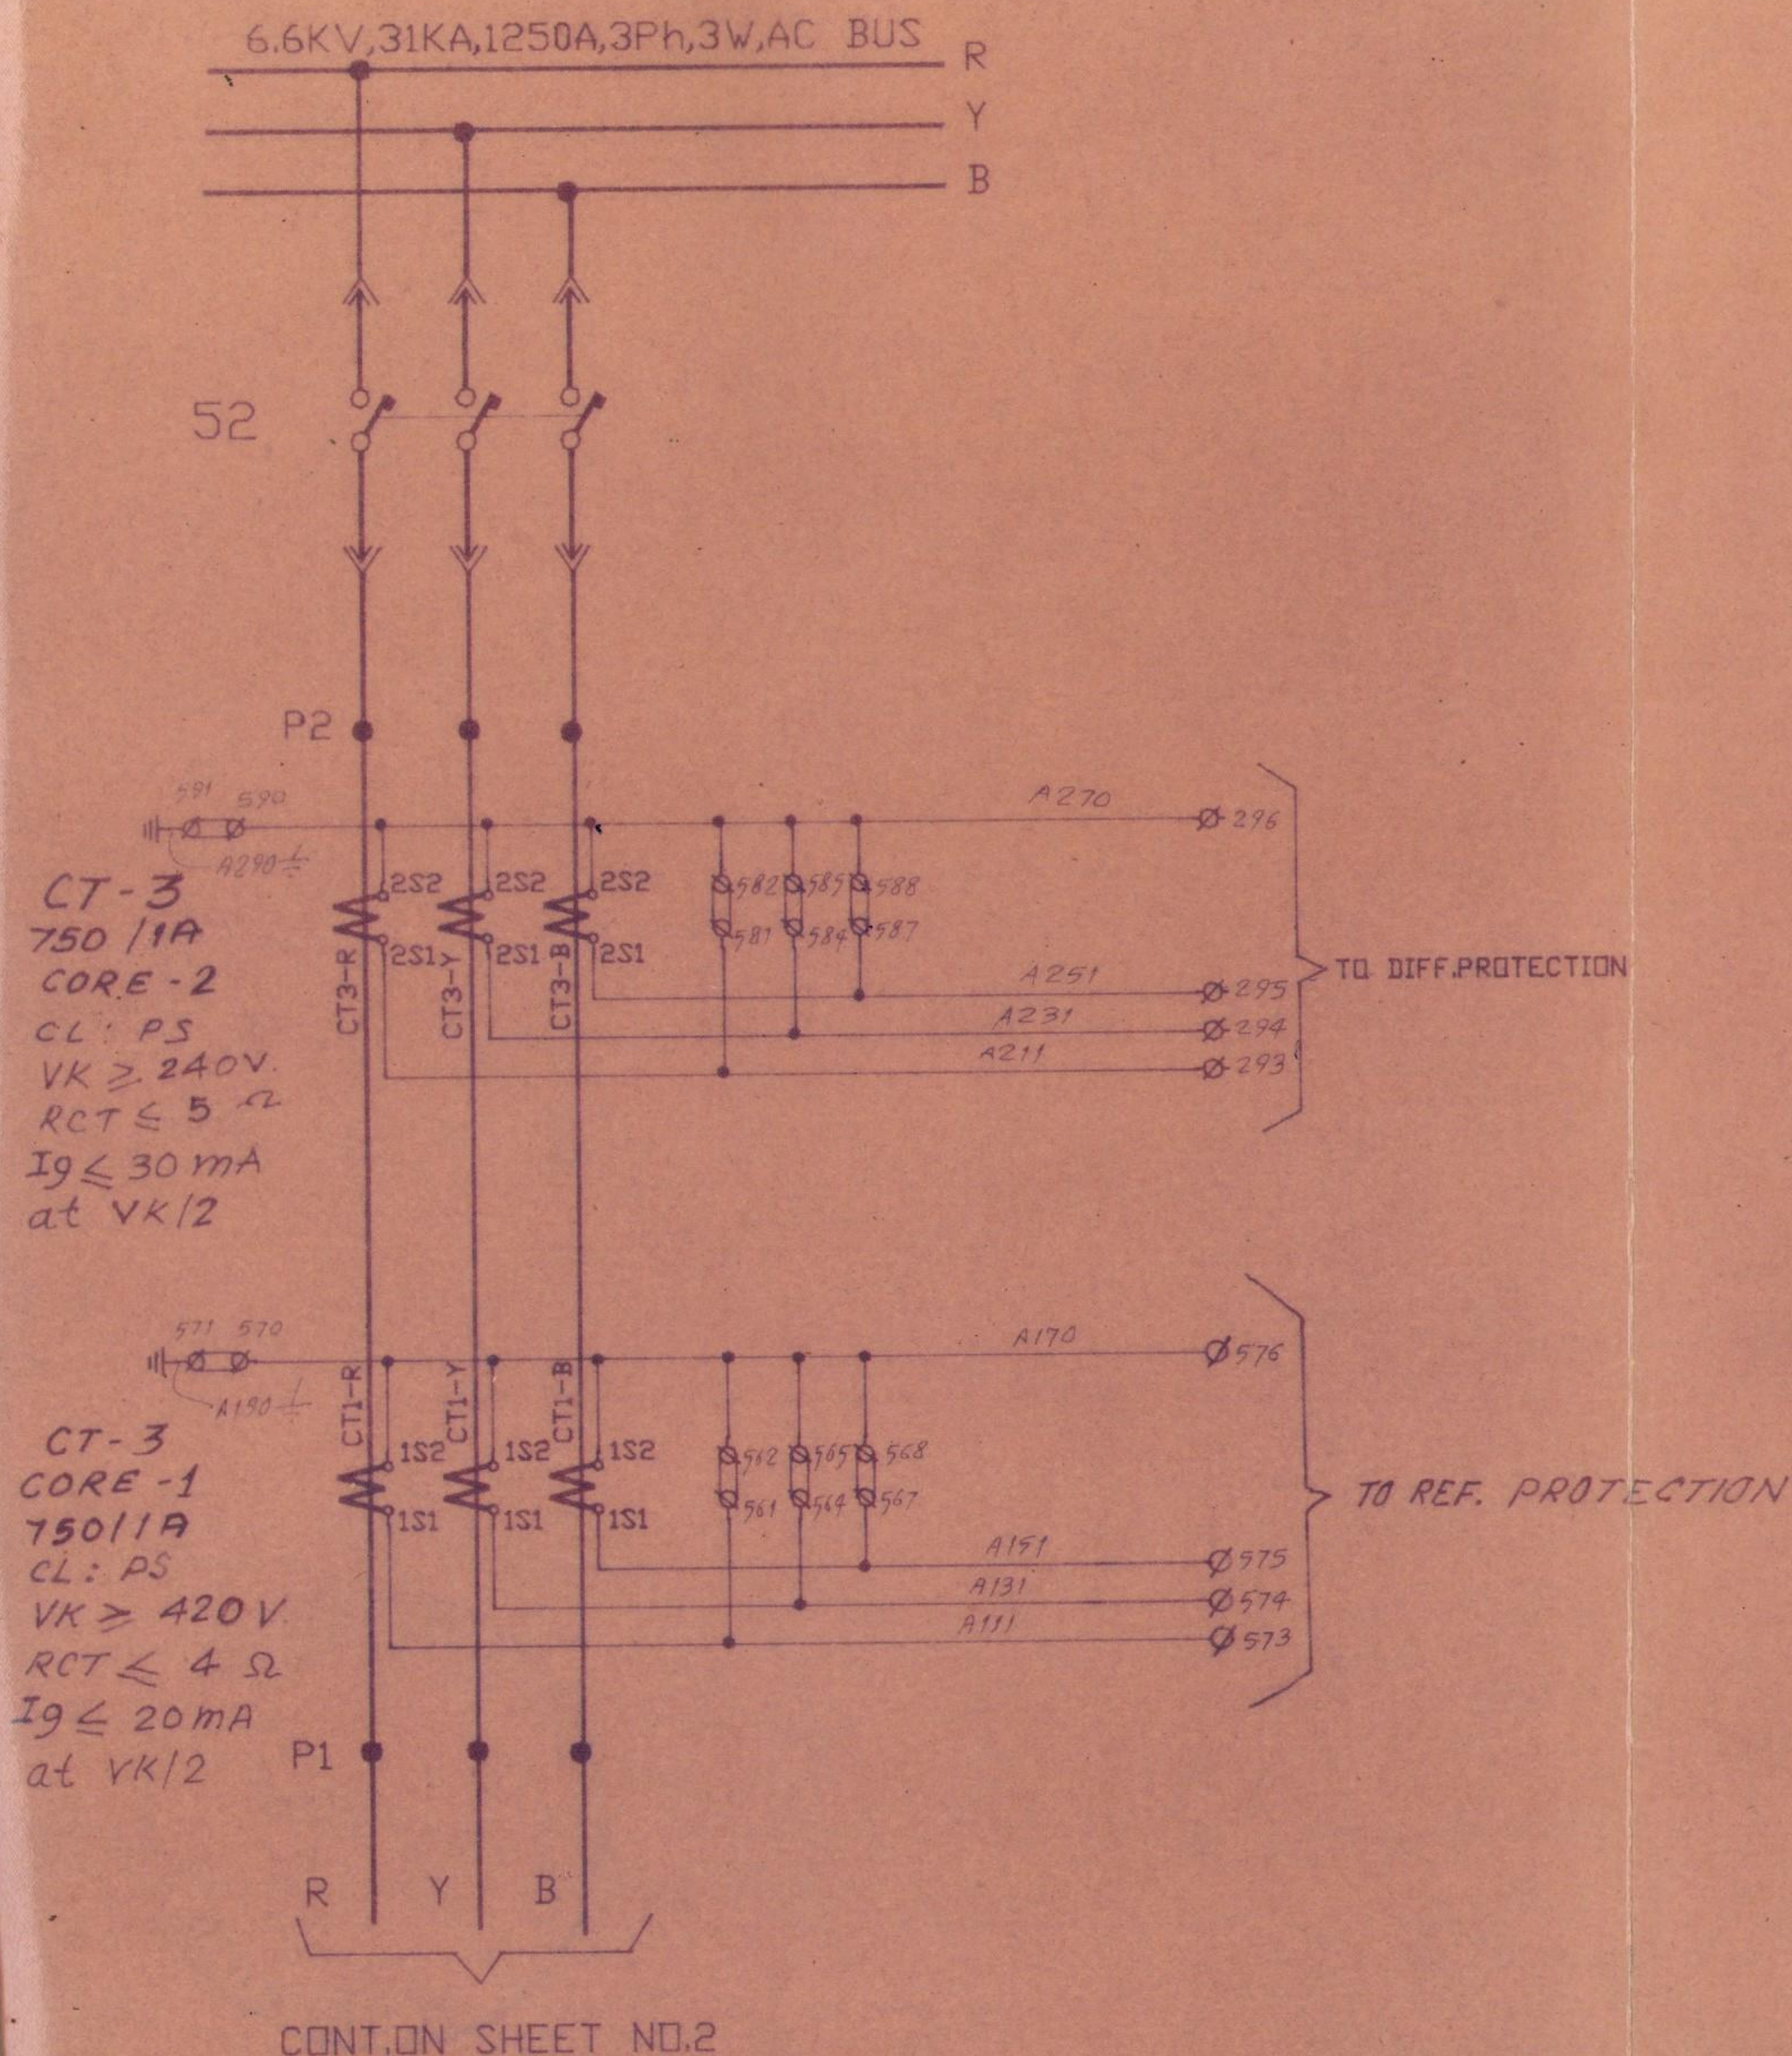

REF. DRGS.


- 1) G.A.DRG.NO.-----H4312656G
- 2) LEGEND & NOTES---H4392034L

AS BUILT

7/4/95	SPARE CONT. PSXQ CHANGED TO 'FOR REM. ANN.'; Ter. No. 834 changed, Range of Amm. added	NRP.
29.12.94	WIRE NOS. & TERM NOS. ADDED	
3/10/94	REVISED AS PER CLIENT'S COMMENTS Dt. 11/7/94.	NRP.
2-6-94	REVISED AS PER CLIENT'S COMMENTS Dt. 13-4-94.	

EIL A/C GAIL, LAKWA
I.O.NO.-4249
SCHEME DIAGRAM FOR I/C FROM TRAFO.
OF 6.6KV, 31KA, 1250A, 24 PANEL SWBD.
VOLTAS SWITCHGEAR LTD.
THANE


SCALE	DRN.	KSHIRSAGAR	25.2.94
	CHKD.		
	APPD.		
	FILE NAME:	GL1C1	
DRAWING NUMBER			
H4302417C1			
SHEET 1	OF 4	REV. 24	

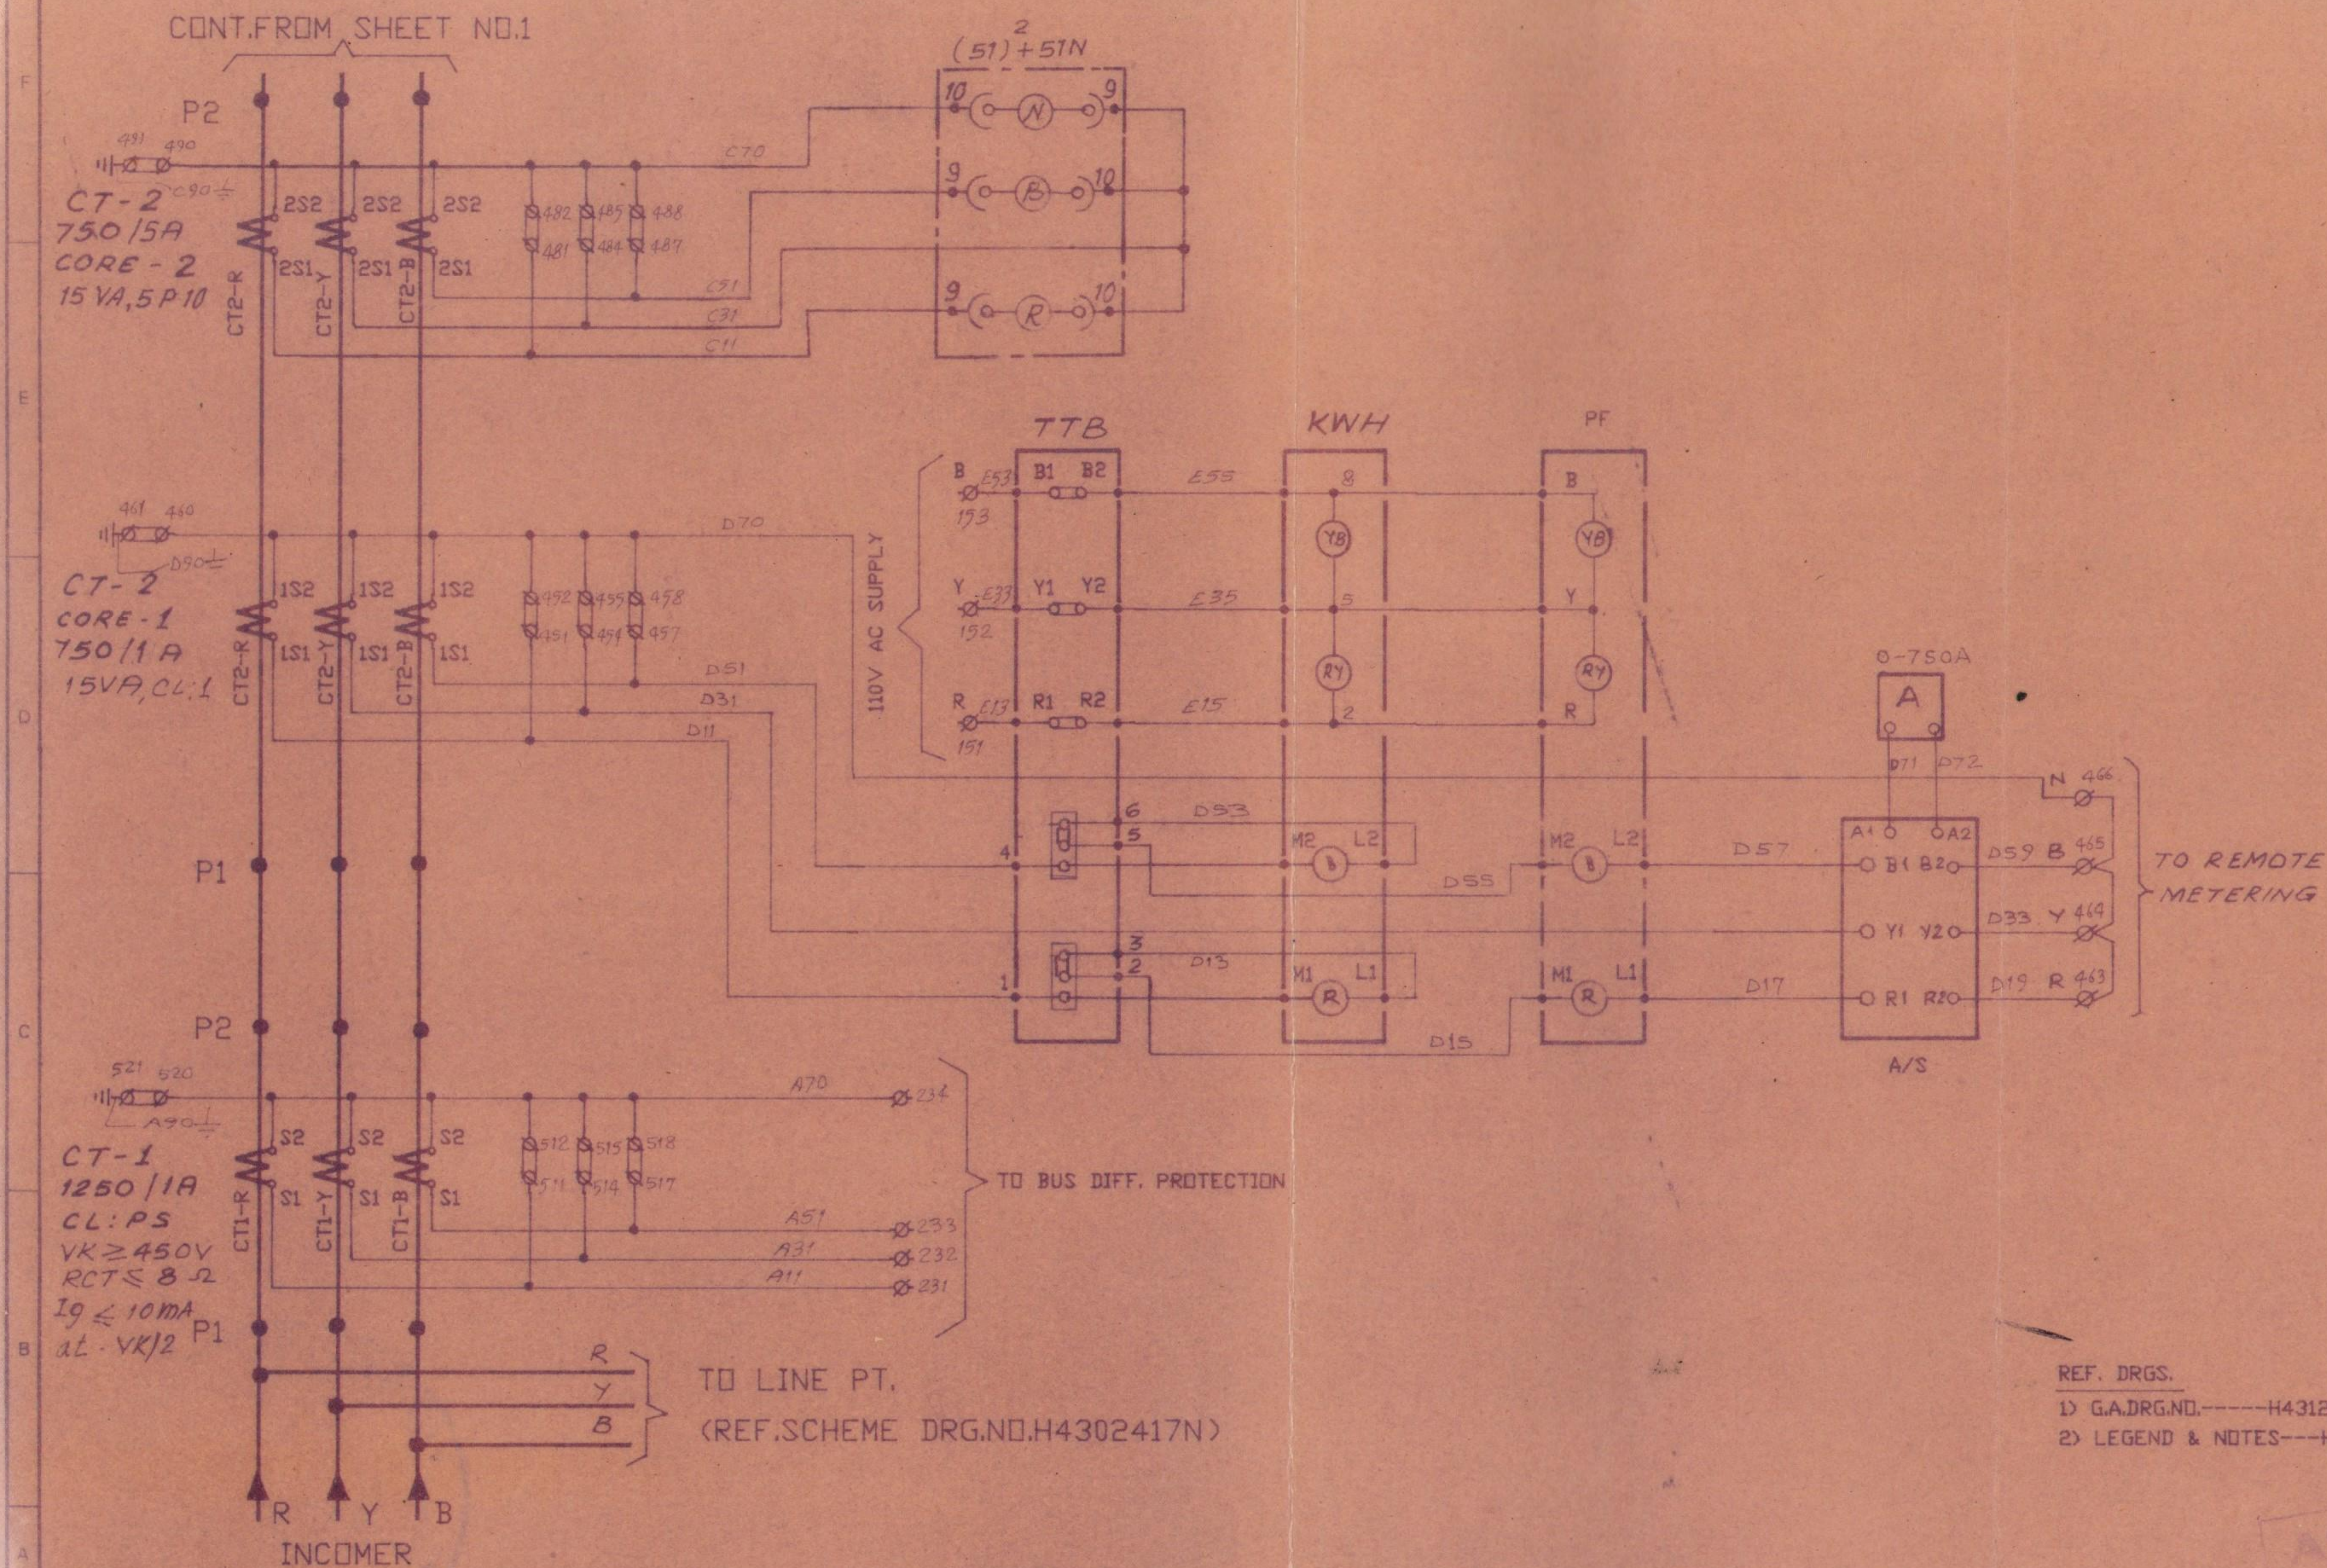


REF. DRGS.

1) G.A. DRG. NO. ---H4312656G

2) LEGEND & NOTES ---H4392034L


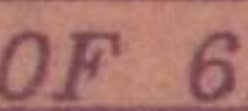
R. NO.	DATE	REVISION	INITIALS	TITLE	EIL A/C GAIL, LAKWA	SCALE	DRN.	KSHIRSAGAR	25-2-94		
					I.O.NO.-4249	CHKD.					
					SCHEME DIAGRAM FOR I/C FROM TRAFO.	APPD.					
					OF 6.6KV, 31KA, 1250A, 24 PANEL SWBD.	FILE NAME:	GL 2C1				
					 VOLTAS SWITCHGEAR LTD.	DRAWING NUMBER	H4302417C1				
					THANE	SHEET	2	OF	4	REV.	24

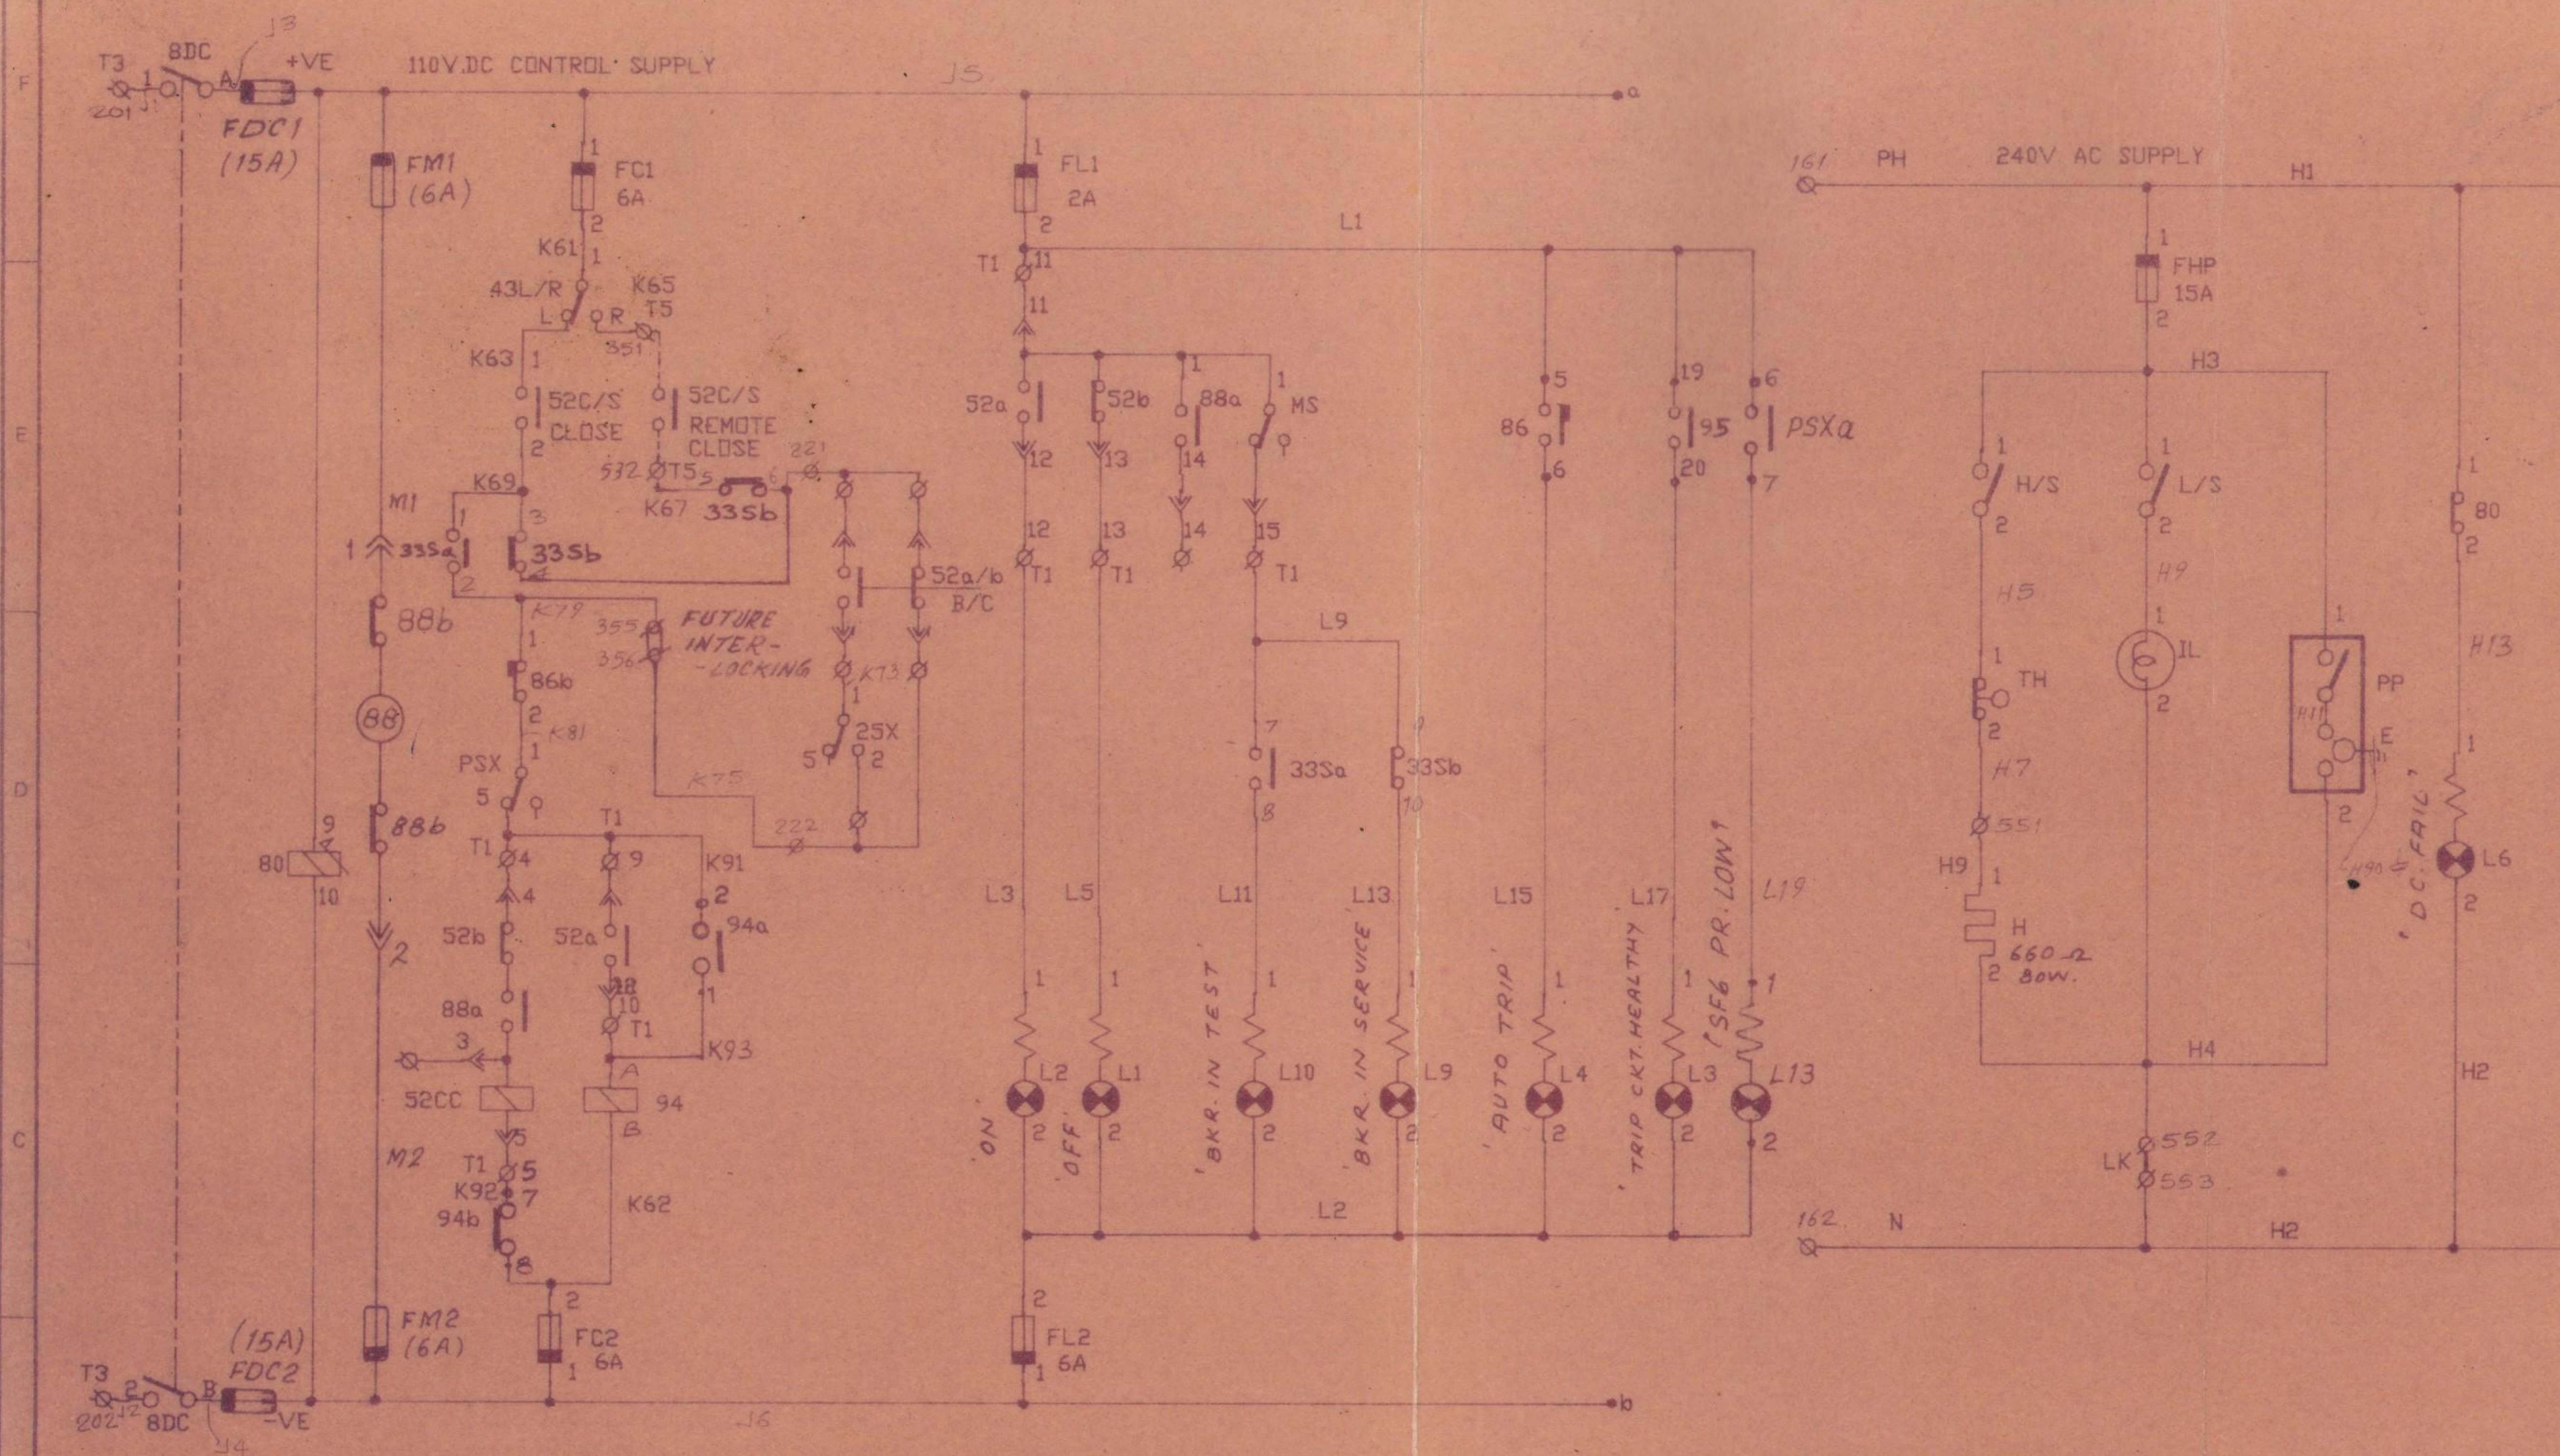

AS BUILT

R NO. DATE VOLTAS-STD-A3CS	REVISION INITIALS	TITLE EIL A/C GAIL, LAKWA I.O.NO.-4249 SCHEME DIAGRAM FOR I/C FROM TRAF OF 6.6KV, 31KA, 1250A, 24 PANEL SWBD. VOLTAS SWITCHGEAR LTD. THANE	SCALE DRN KSHIRSAGAR 22-2-94 CHKD. APPD. FILE NAME GL 3C1 DRAWING NUMBER H4302417C1 SHEET 3 OF 4 REV. 24
-------------------------------	----------------------	--	---

110V.DC.CONTROL SUPPLY

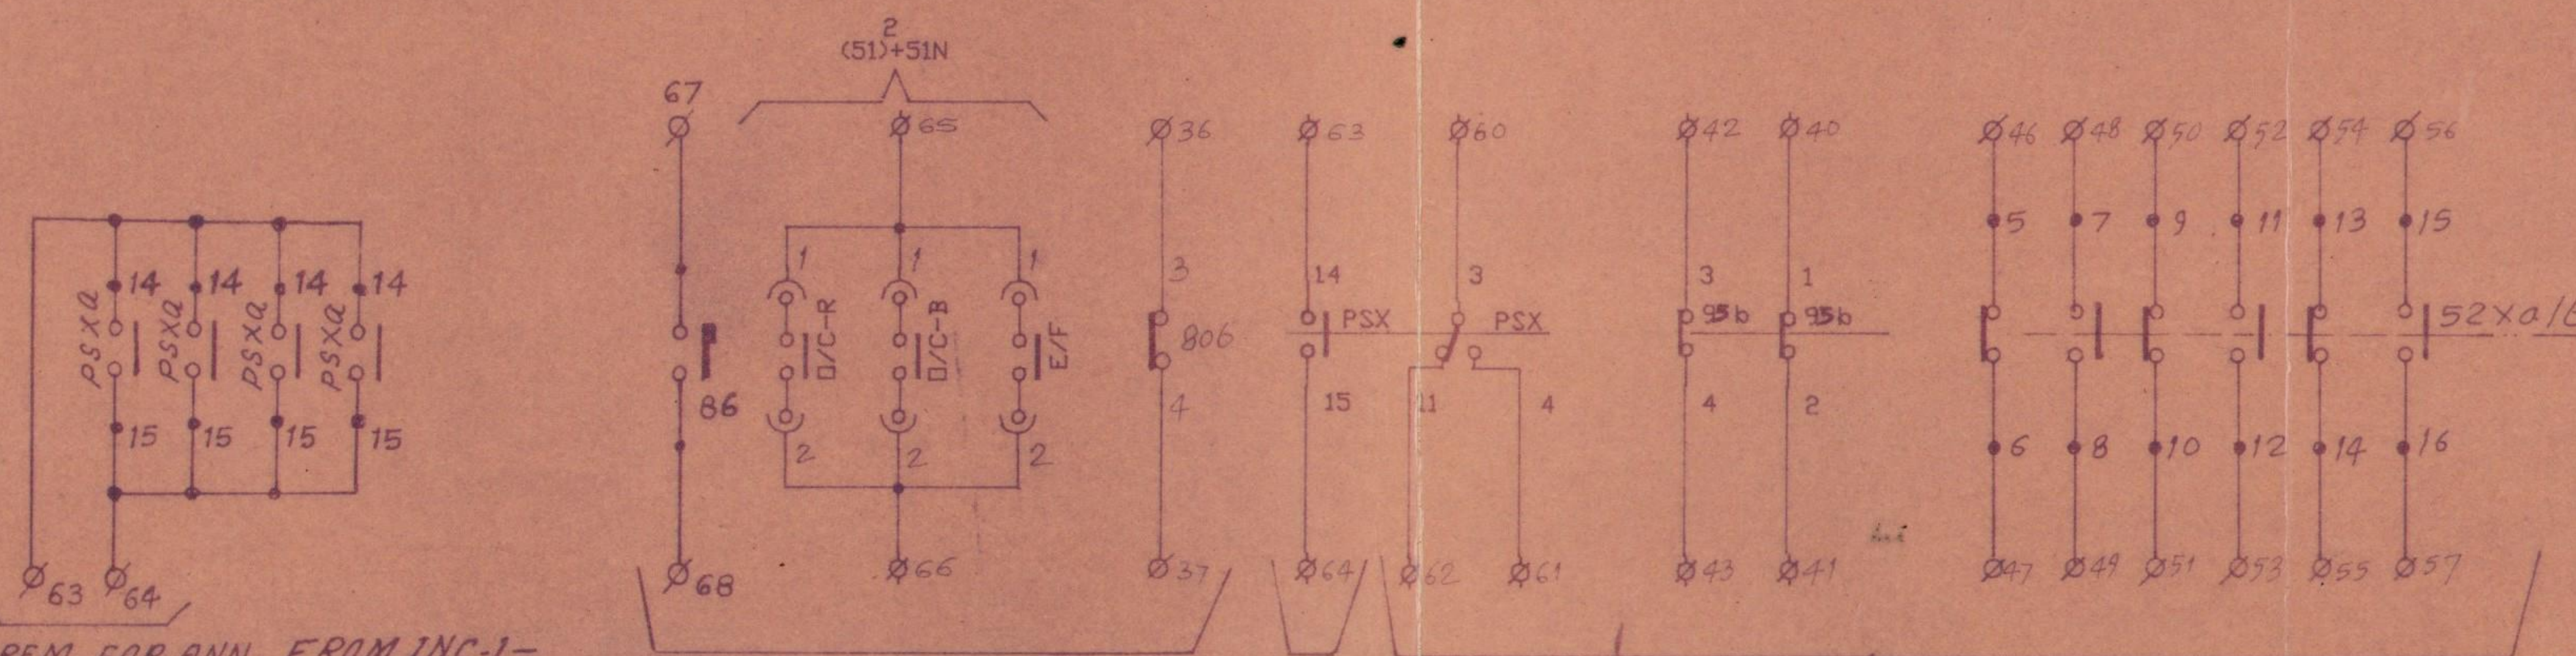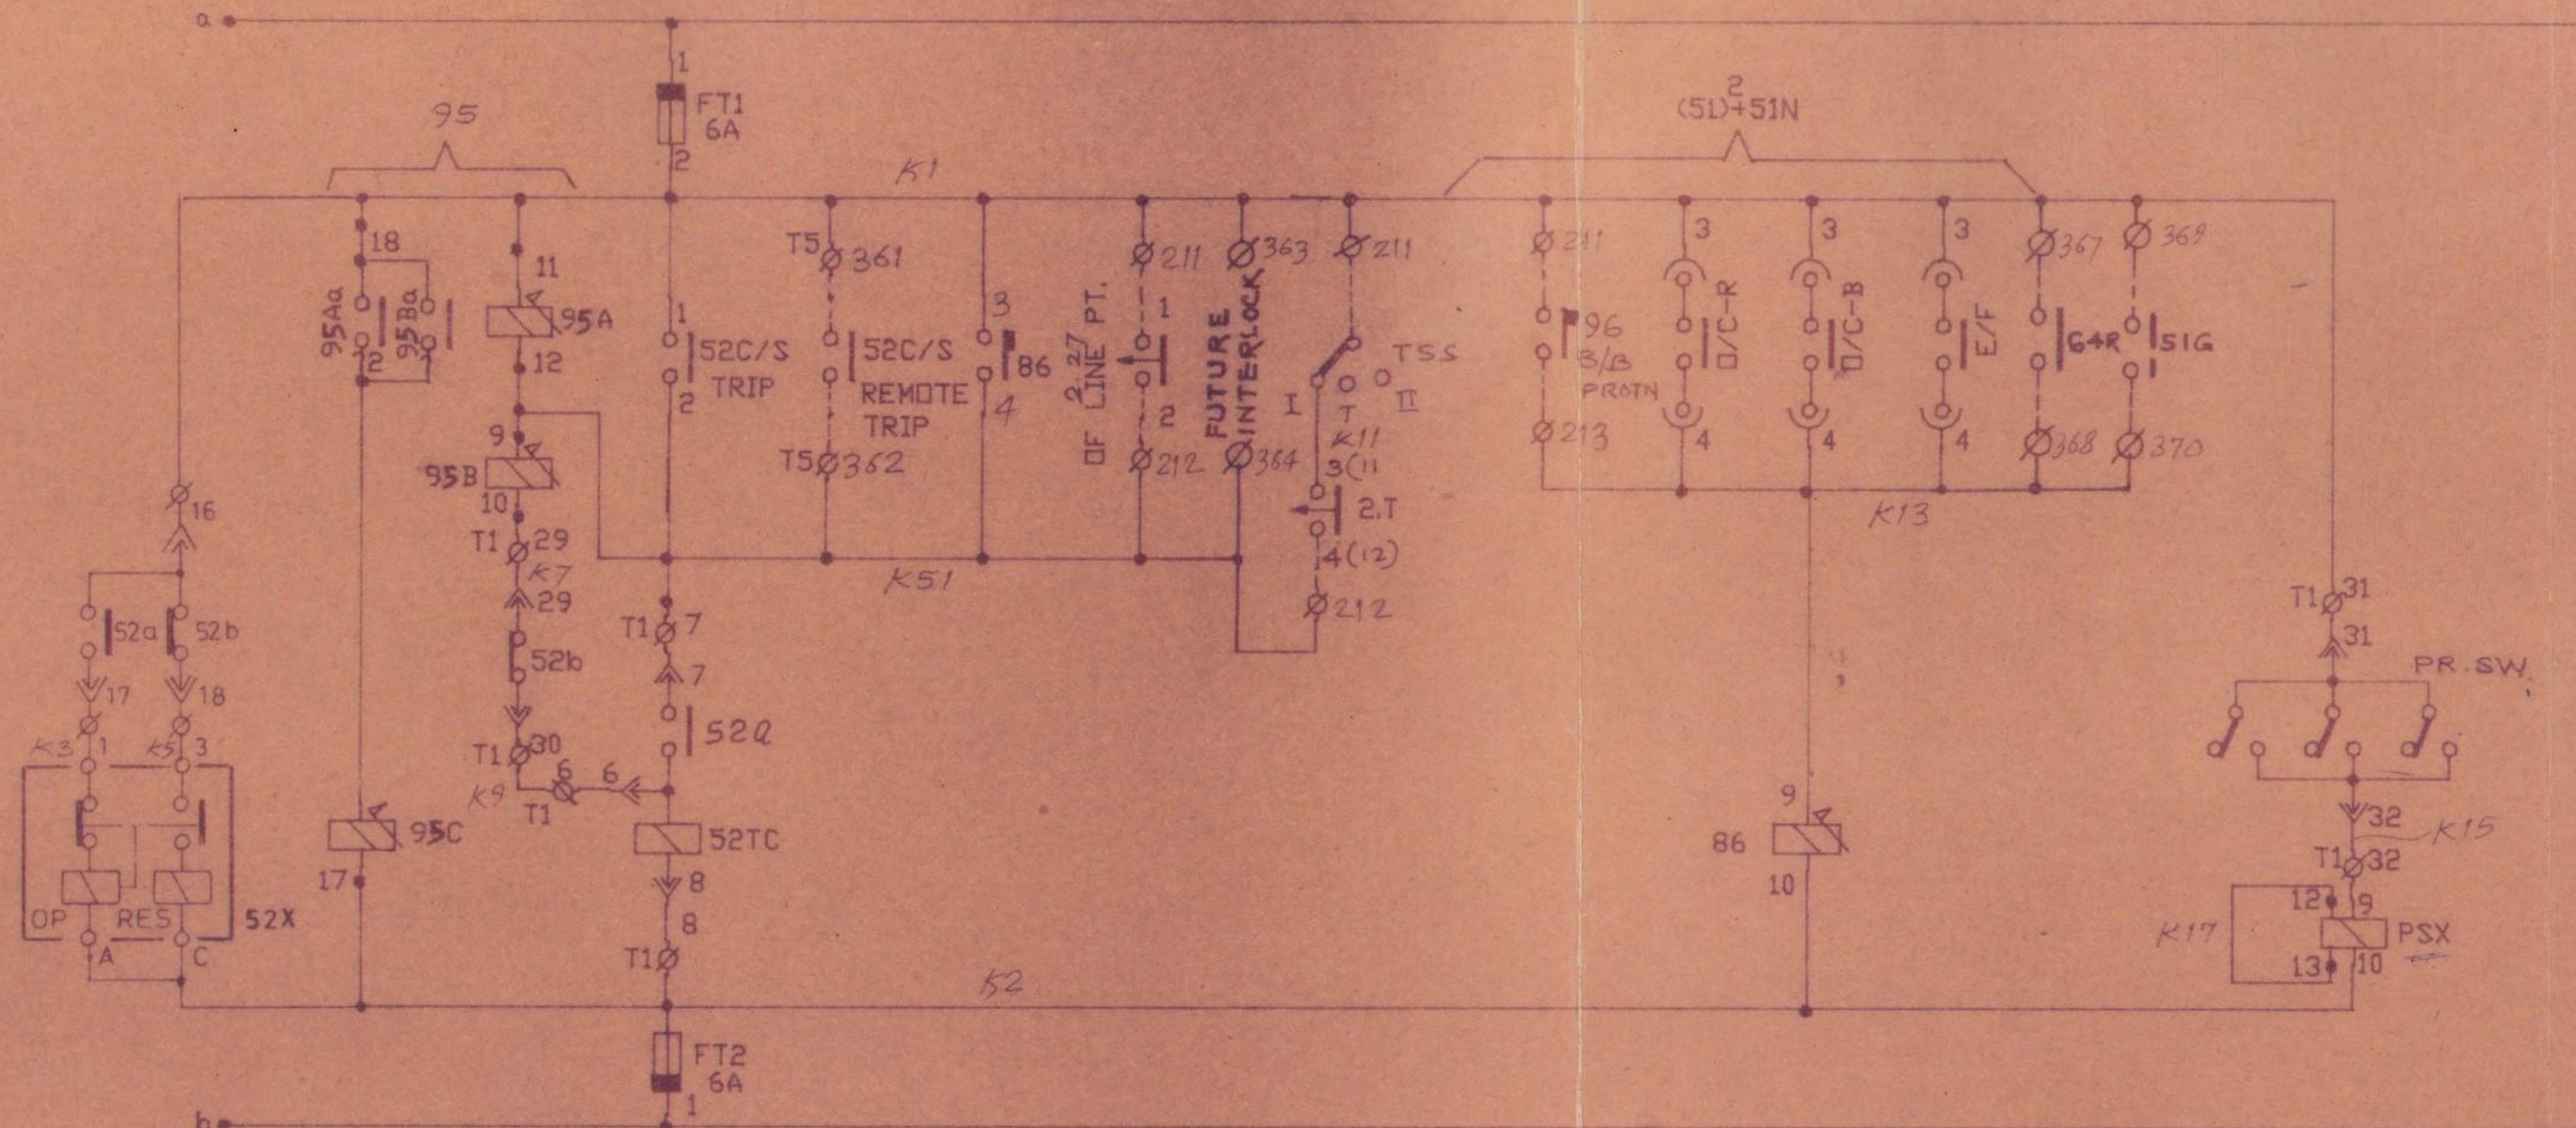

TO REM. FOR ANN. FROM INC-1-
-PSXQ OF ALL FDRS ON BUS SECN-1
& PSXQ OF B/C.
FROM INC-2-PSXQ OF ALL FDRS ON BUS SECN-2

TO BE
PARALLELED WITH
PSXQ OF ALL FDRS
OF BUS SECTN.-1 OR 2

AS BUILT

R NO. DATE VOL-TAS-STD-A3CS	REVISION INITIALS	TITLE EIL A/C GAIL, LAKWA I.O.NO.-4249 SCHEME DIAGRAM FOR I/C FROM TRAFO. OF 6.6KV,31KA,1250A,24 PANEL SWBD. VOLTAS SWITCHGEAR LTD. THANE	SCALE DRN. KSHIRSAGAR 28.2.94 CHKD. APPD. FILE NAME GL4C1 DRAWING NUMBER H4302417C1 SHEET 4 OF 4 REV. 4
--------------------------------	----------------------	---	--