


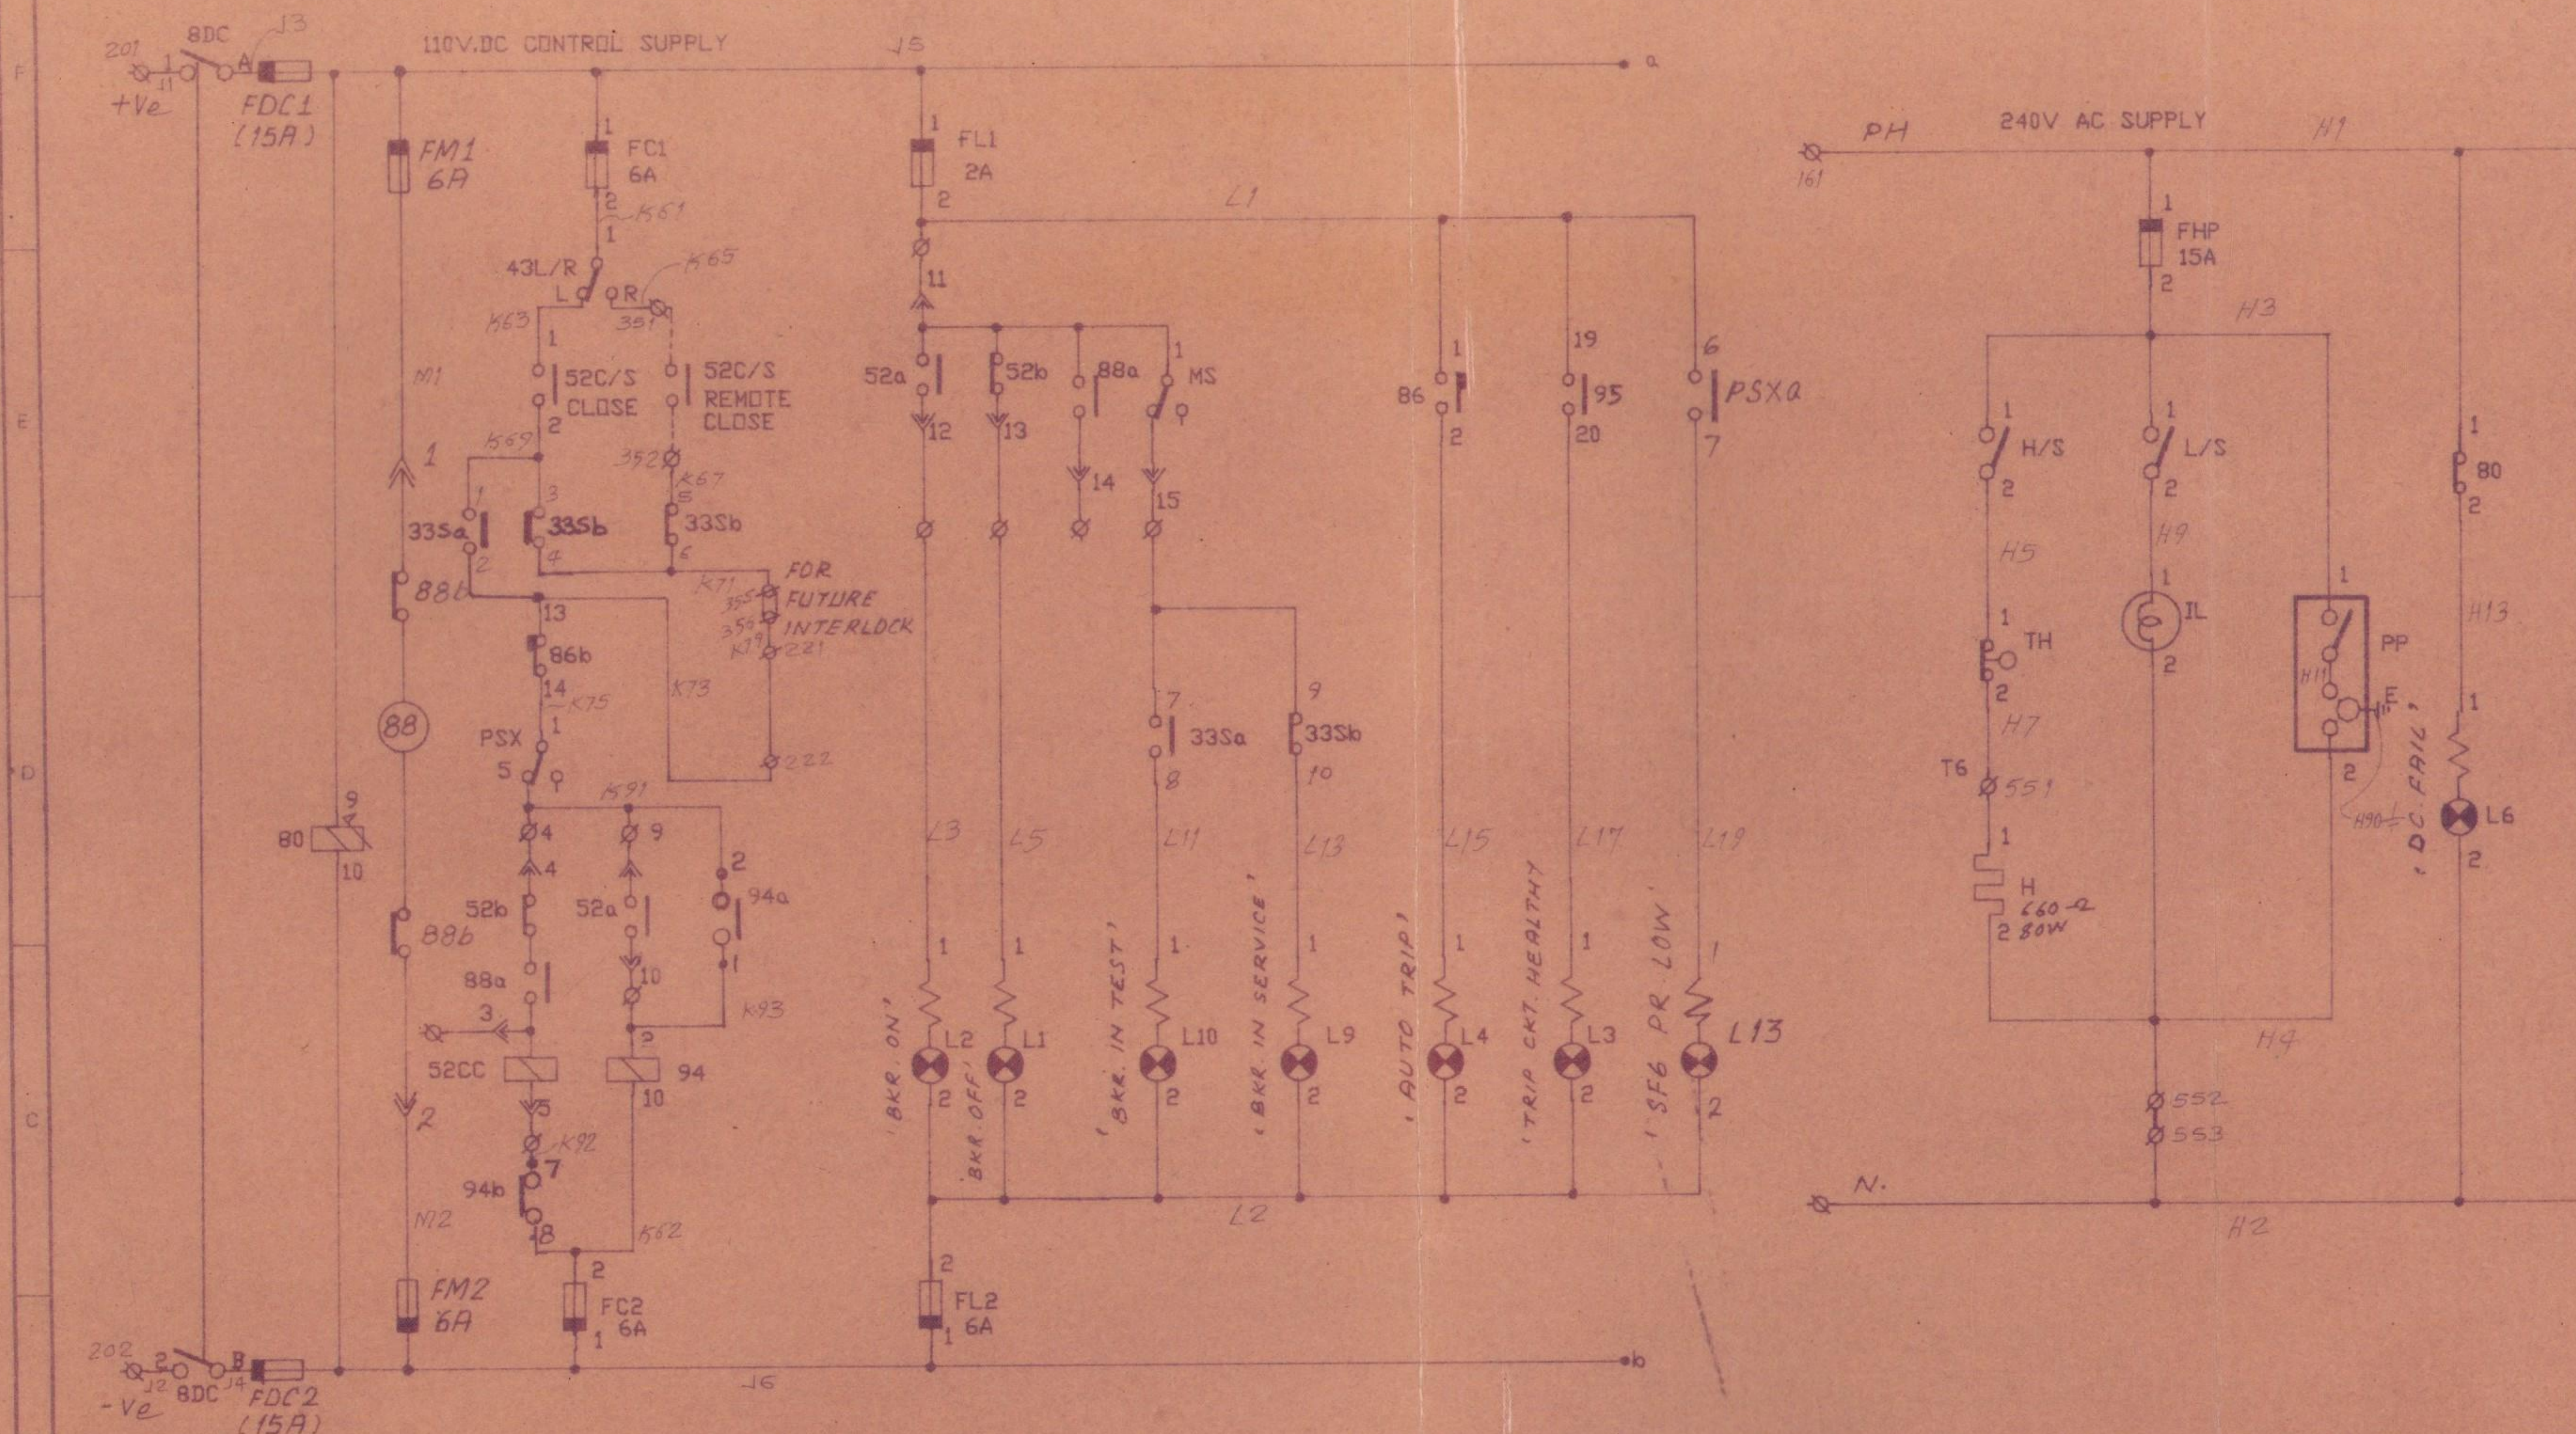



AS BUILT

EIL A/C GAIL, LAKWA
 I.O.NO.-4249
 SCHEME DIAGRAM FOR I/C FROM GEN.
 OF 6.6KV, 31KA, 1250A, 24 PANEL SWBD.
 VOLTAS SWITCHGEAR LTD.
 THANE

SCALE	DRN	KSHIRSAGAR	13.94
CHKD.	APPD.	FILE NAME:	GL2C2
DRAWING NUMBER	H4302417C2	SHEET	2 OF 4
REV	43		





R NO.	DATE	REVISION	INITIALS
-------	------	----------	----------

110V.DC.CONTROL SUPPLY

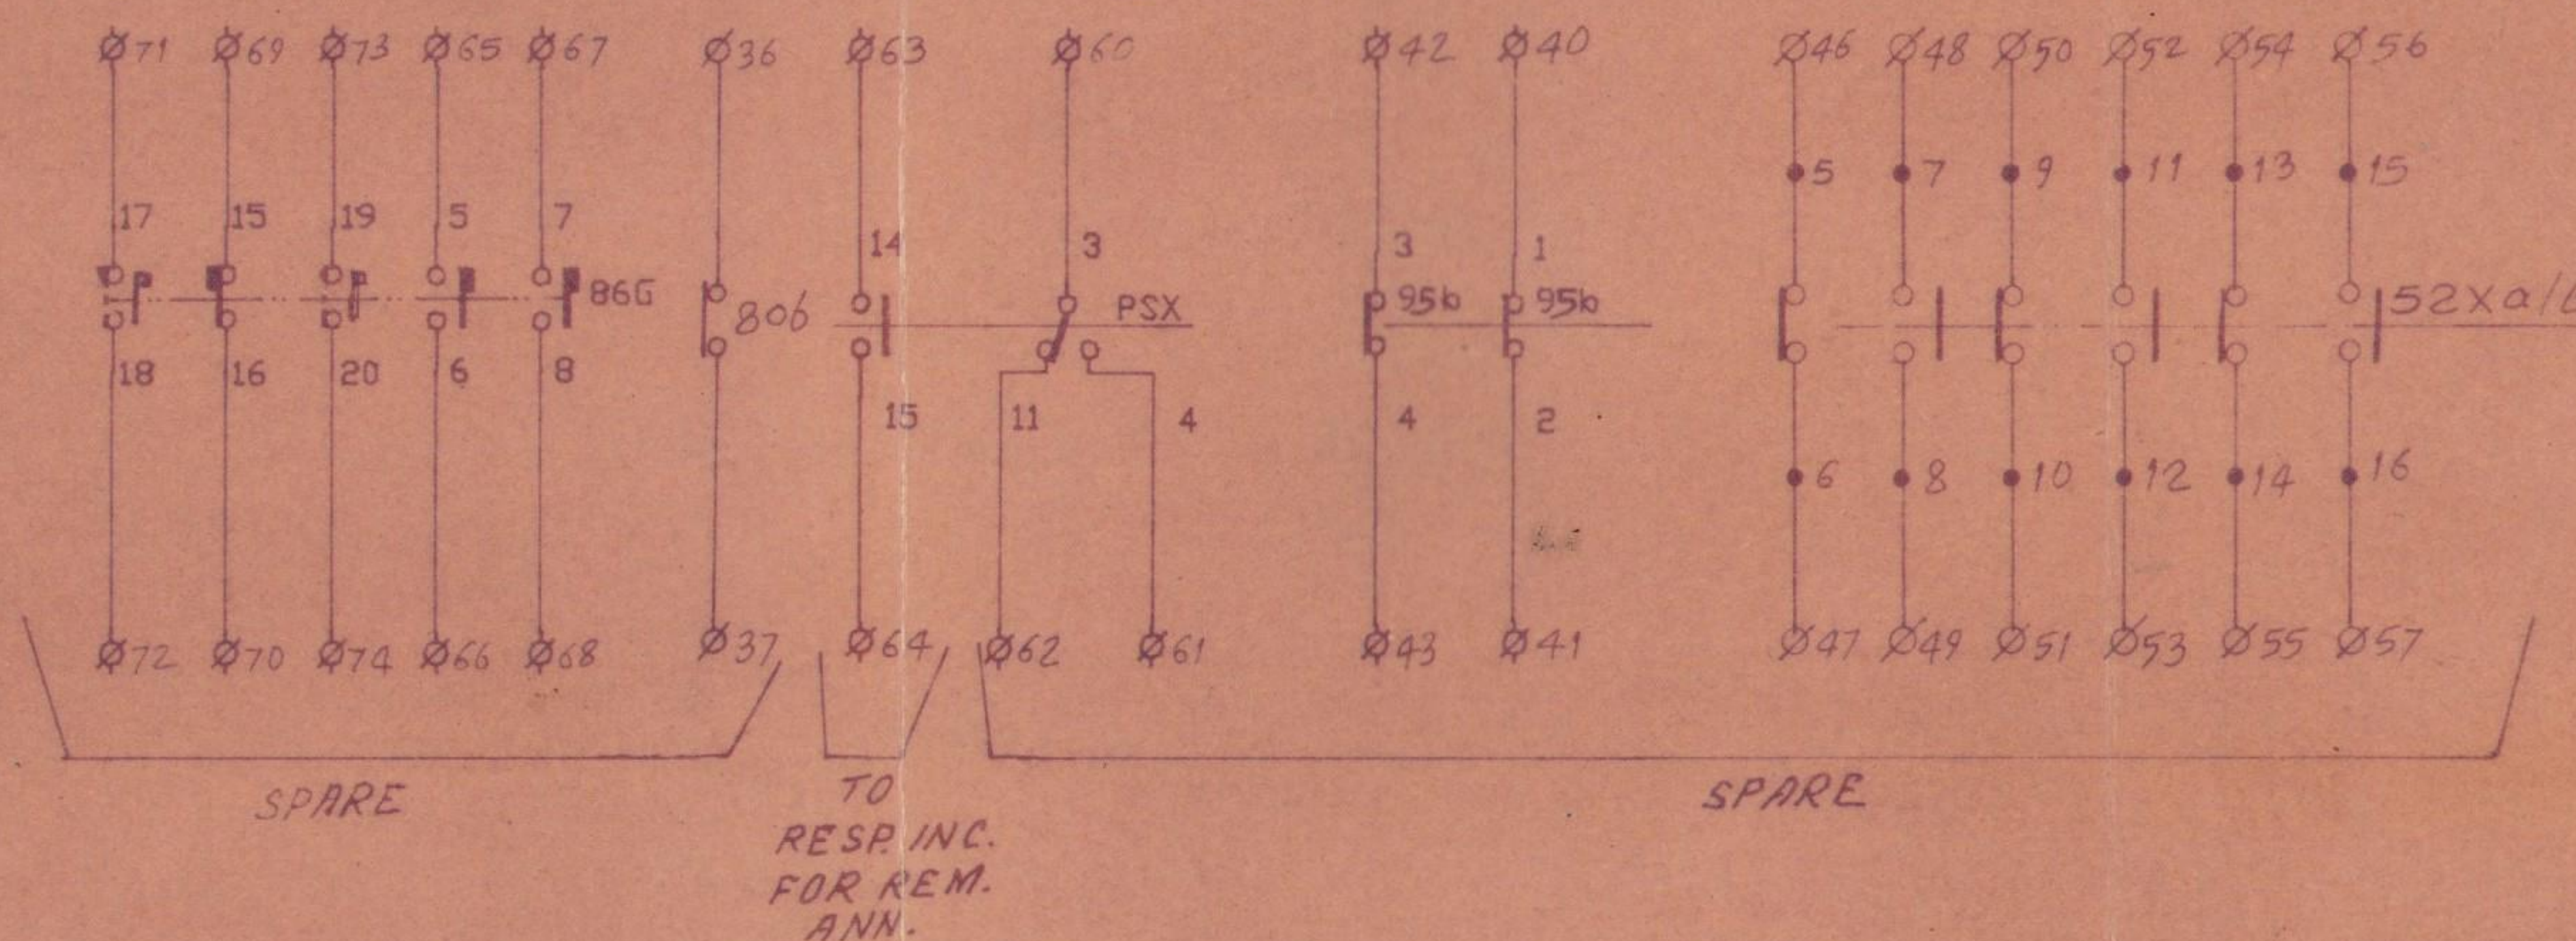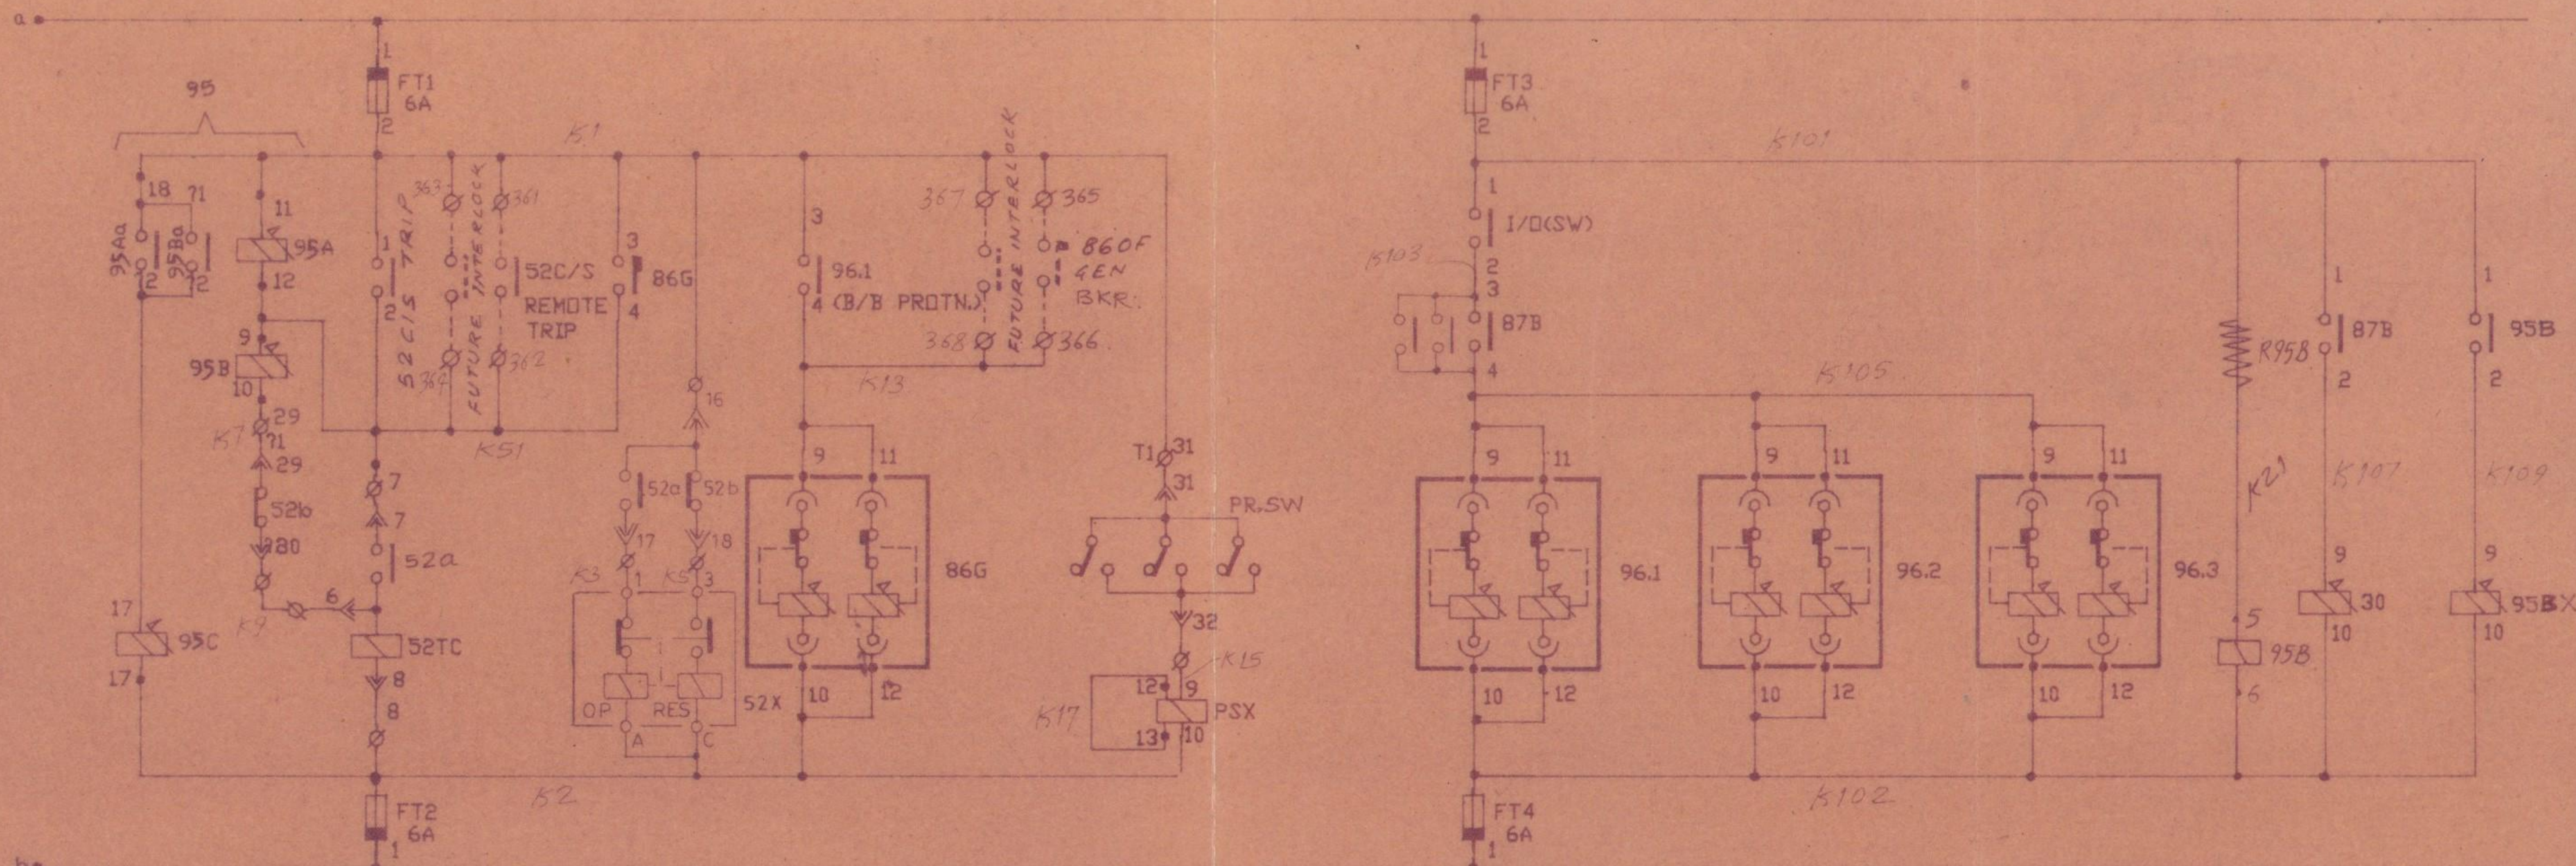

AS BUILT

R. NO.	DATE	REVISION	INITIALS	TITLE EIL A/C GAIL, LAKWA I.O.NO:-4249 SCHEME DIAGRAM FOR I/C FROM GEN. OF 6.6KV,31KA,1250A,24 PANEL SWBD. VOLTAS SWITCHGEAR LTD. THANE	SCALE DRN. KSHIRSAGAR CHKD. L3.94 APPD. FILE NAME DRAWING NUMBER H4302417C2 SHEET 3 OF 4 REV. 43
--------	------	----------	----------	---	---

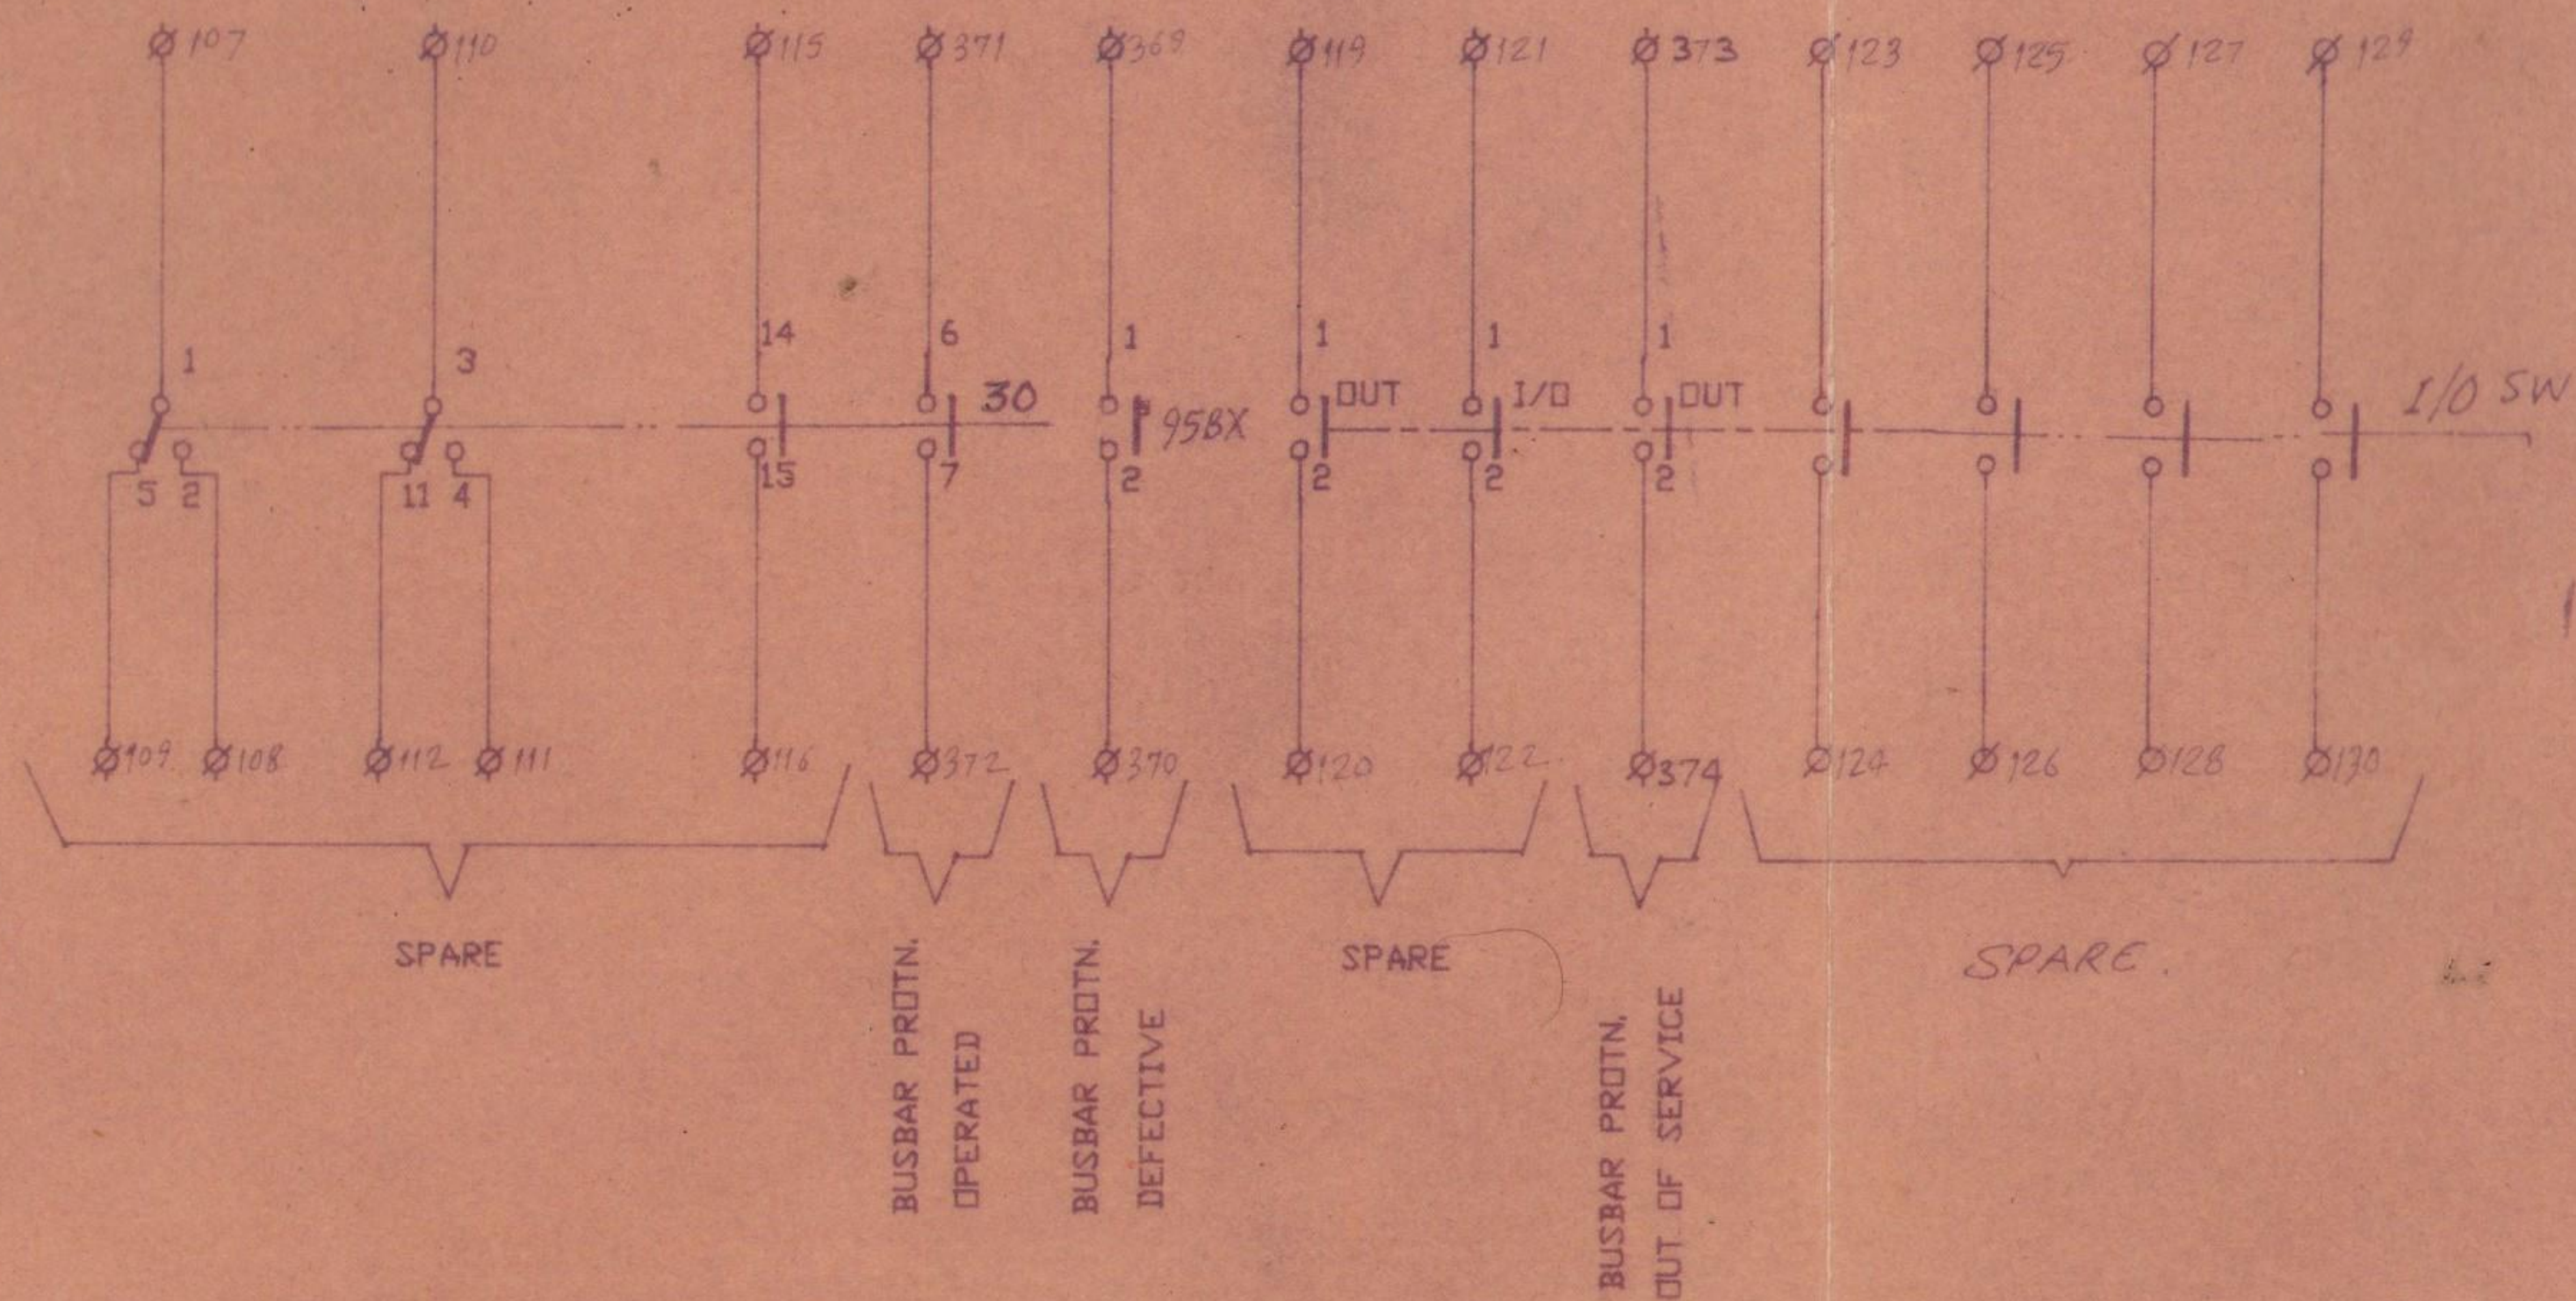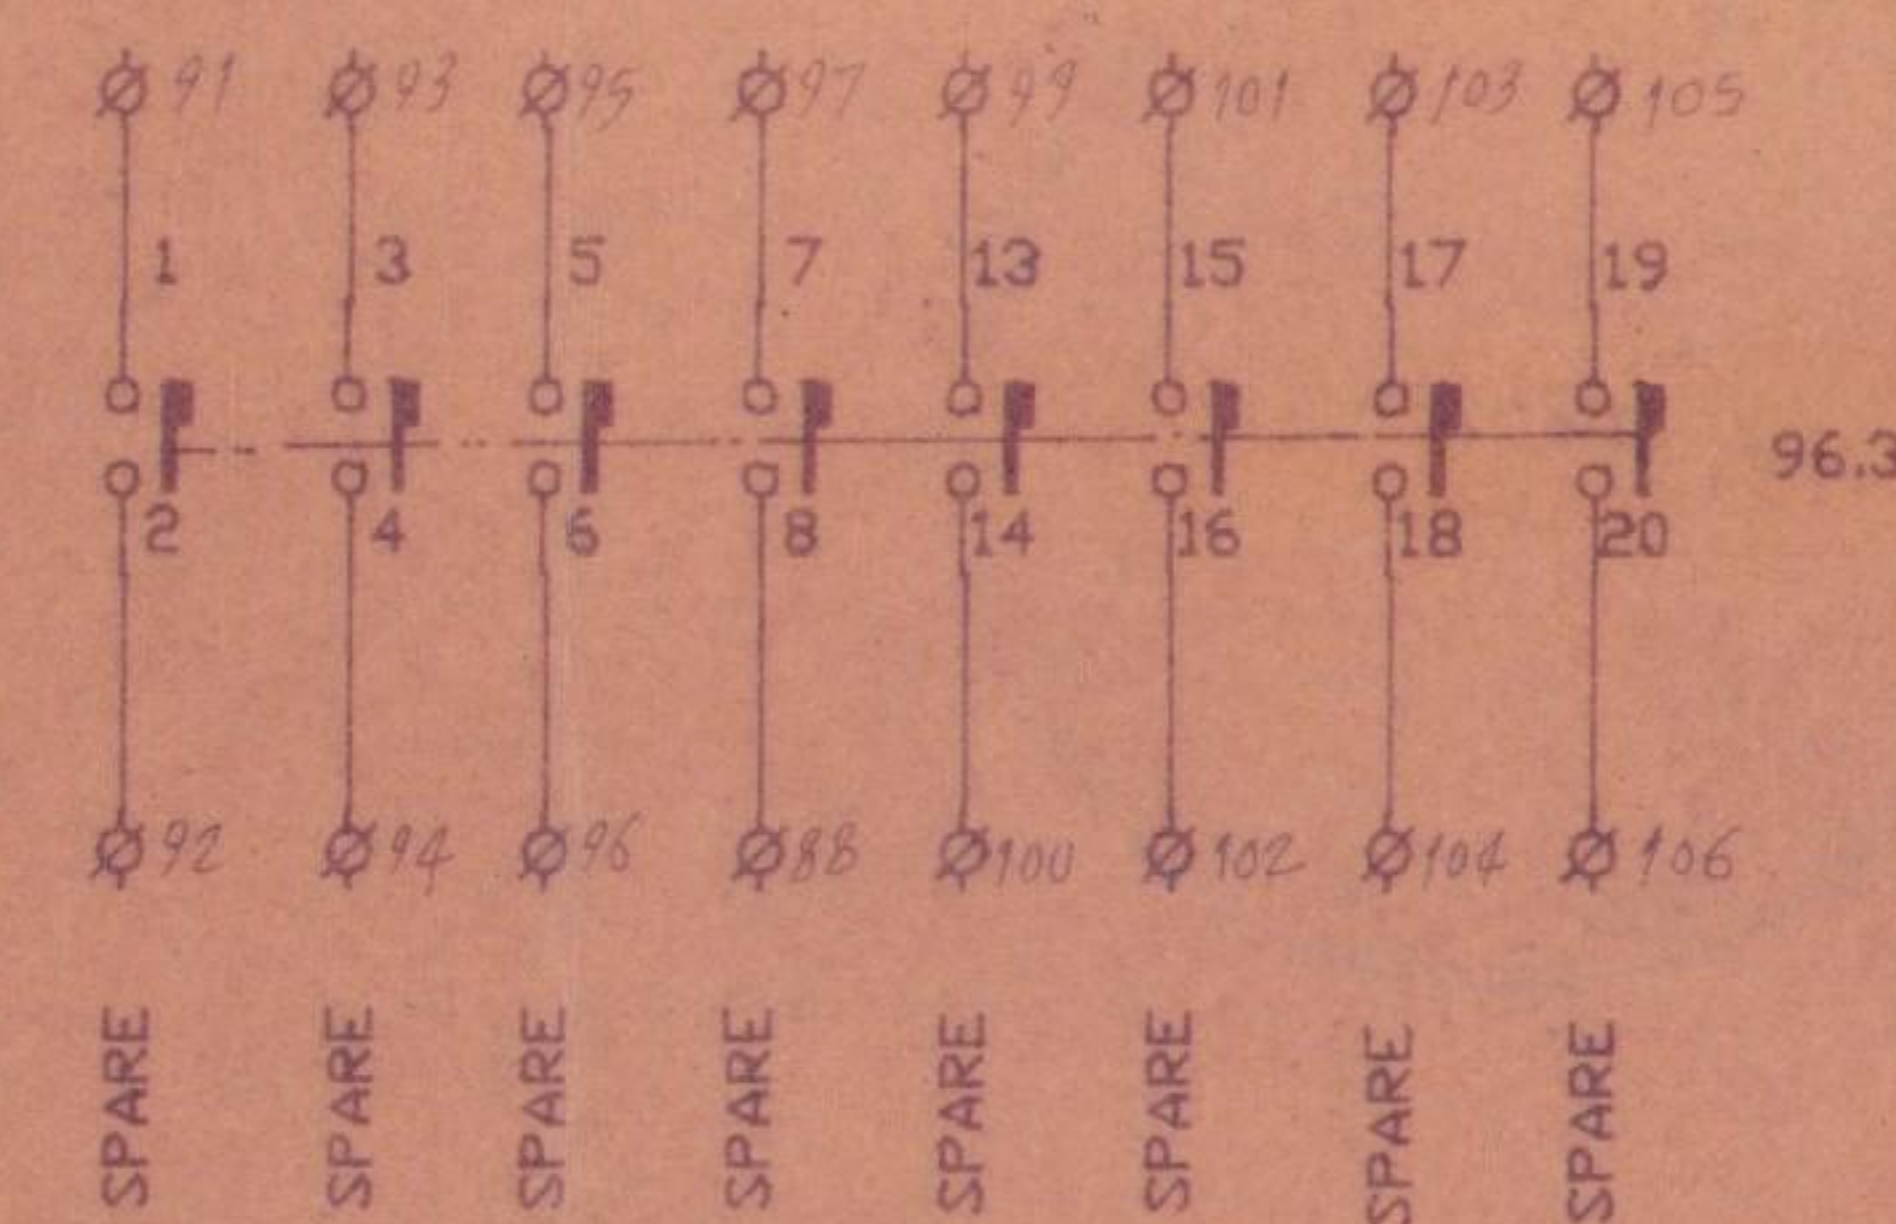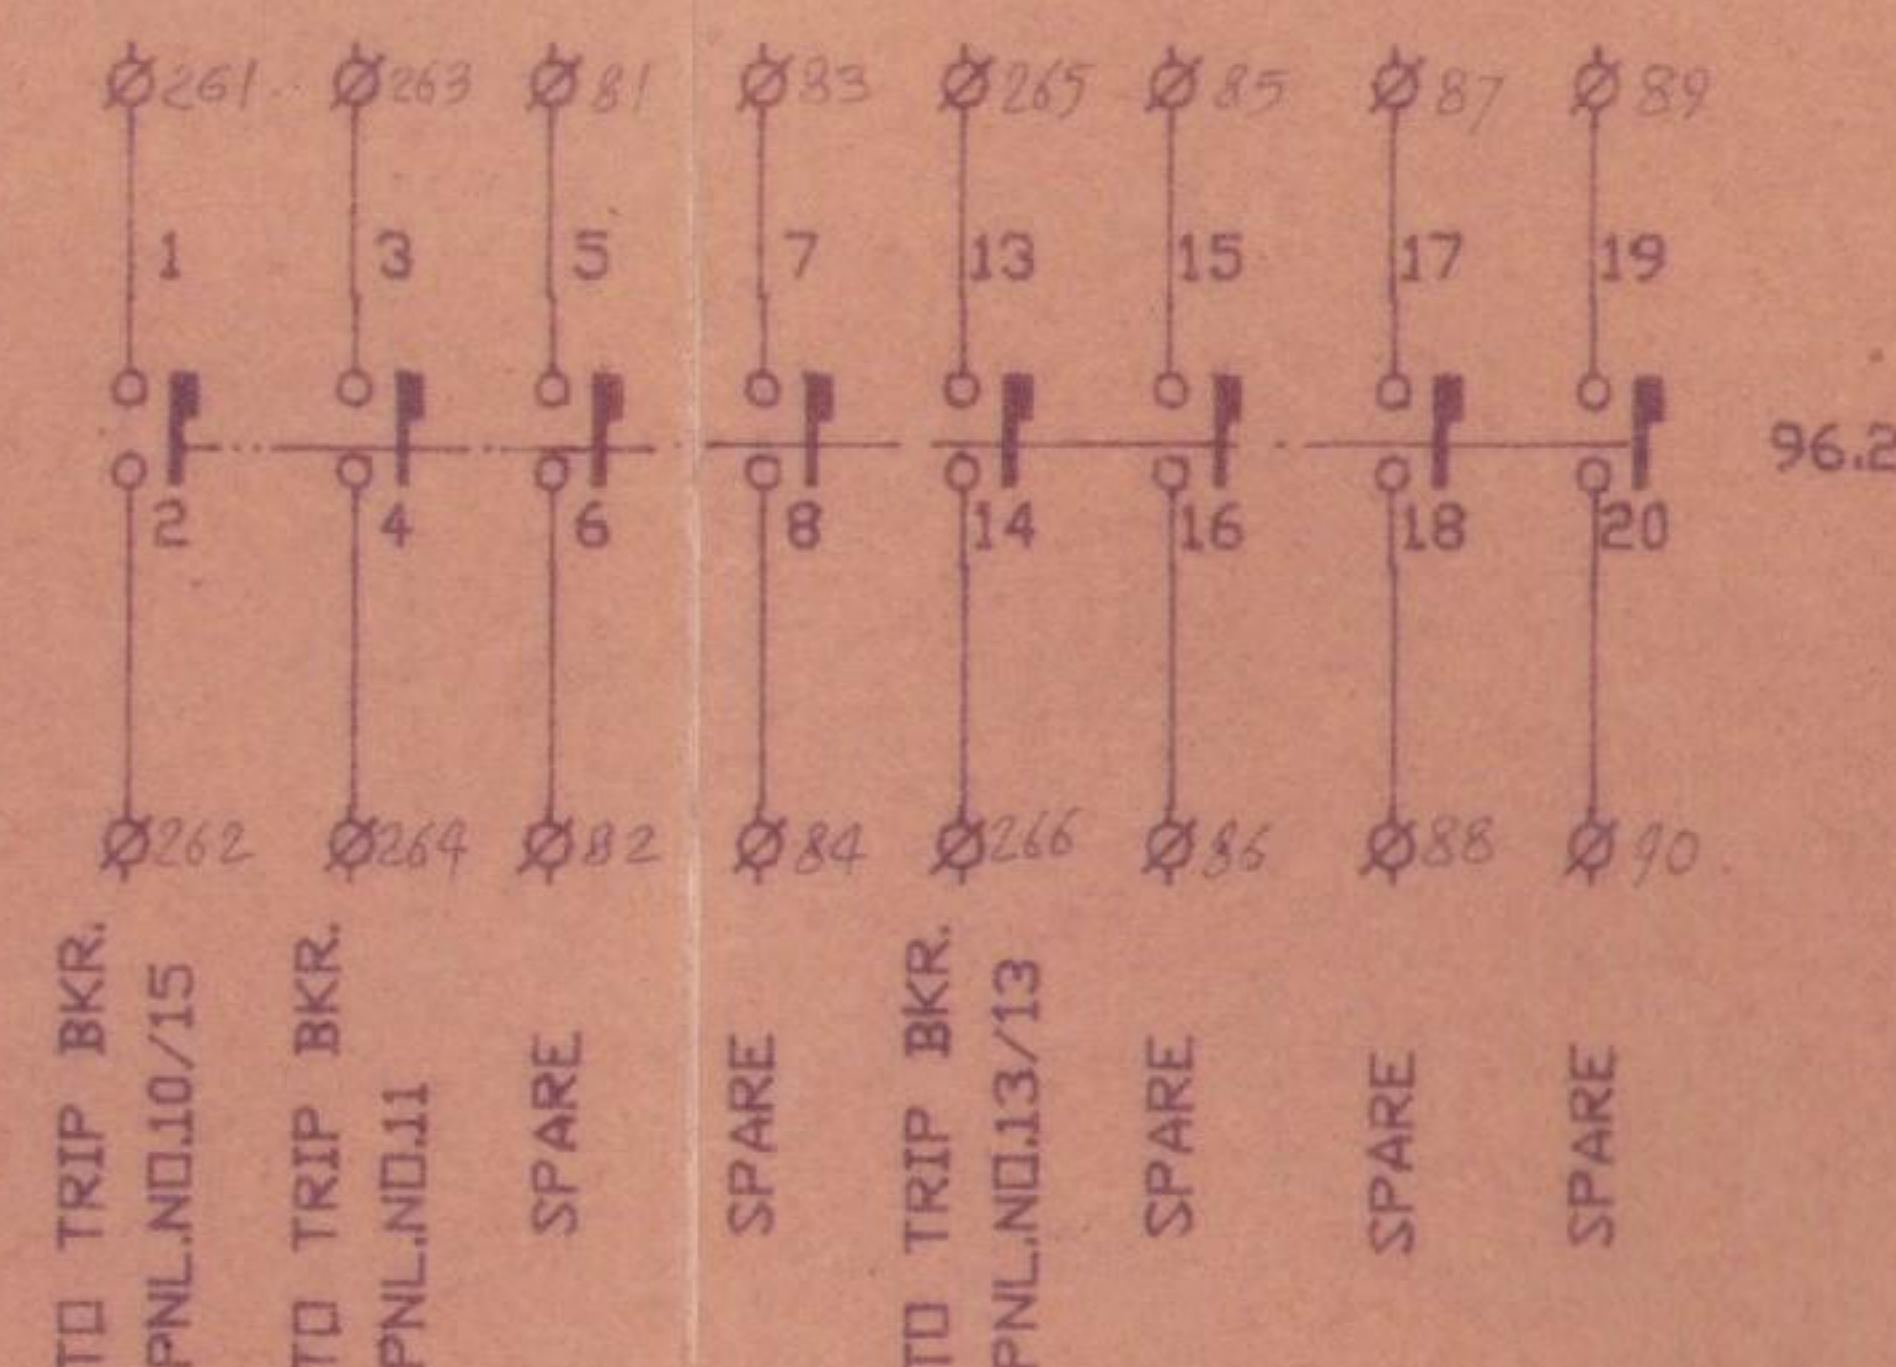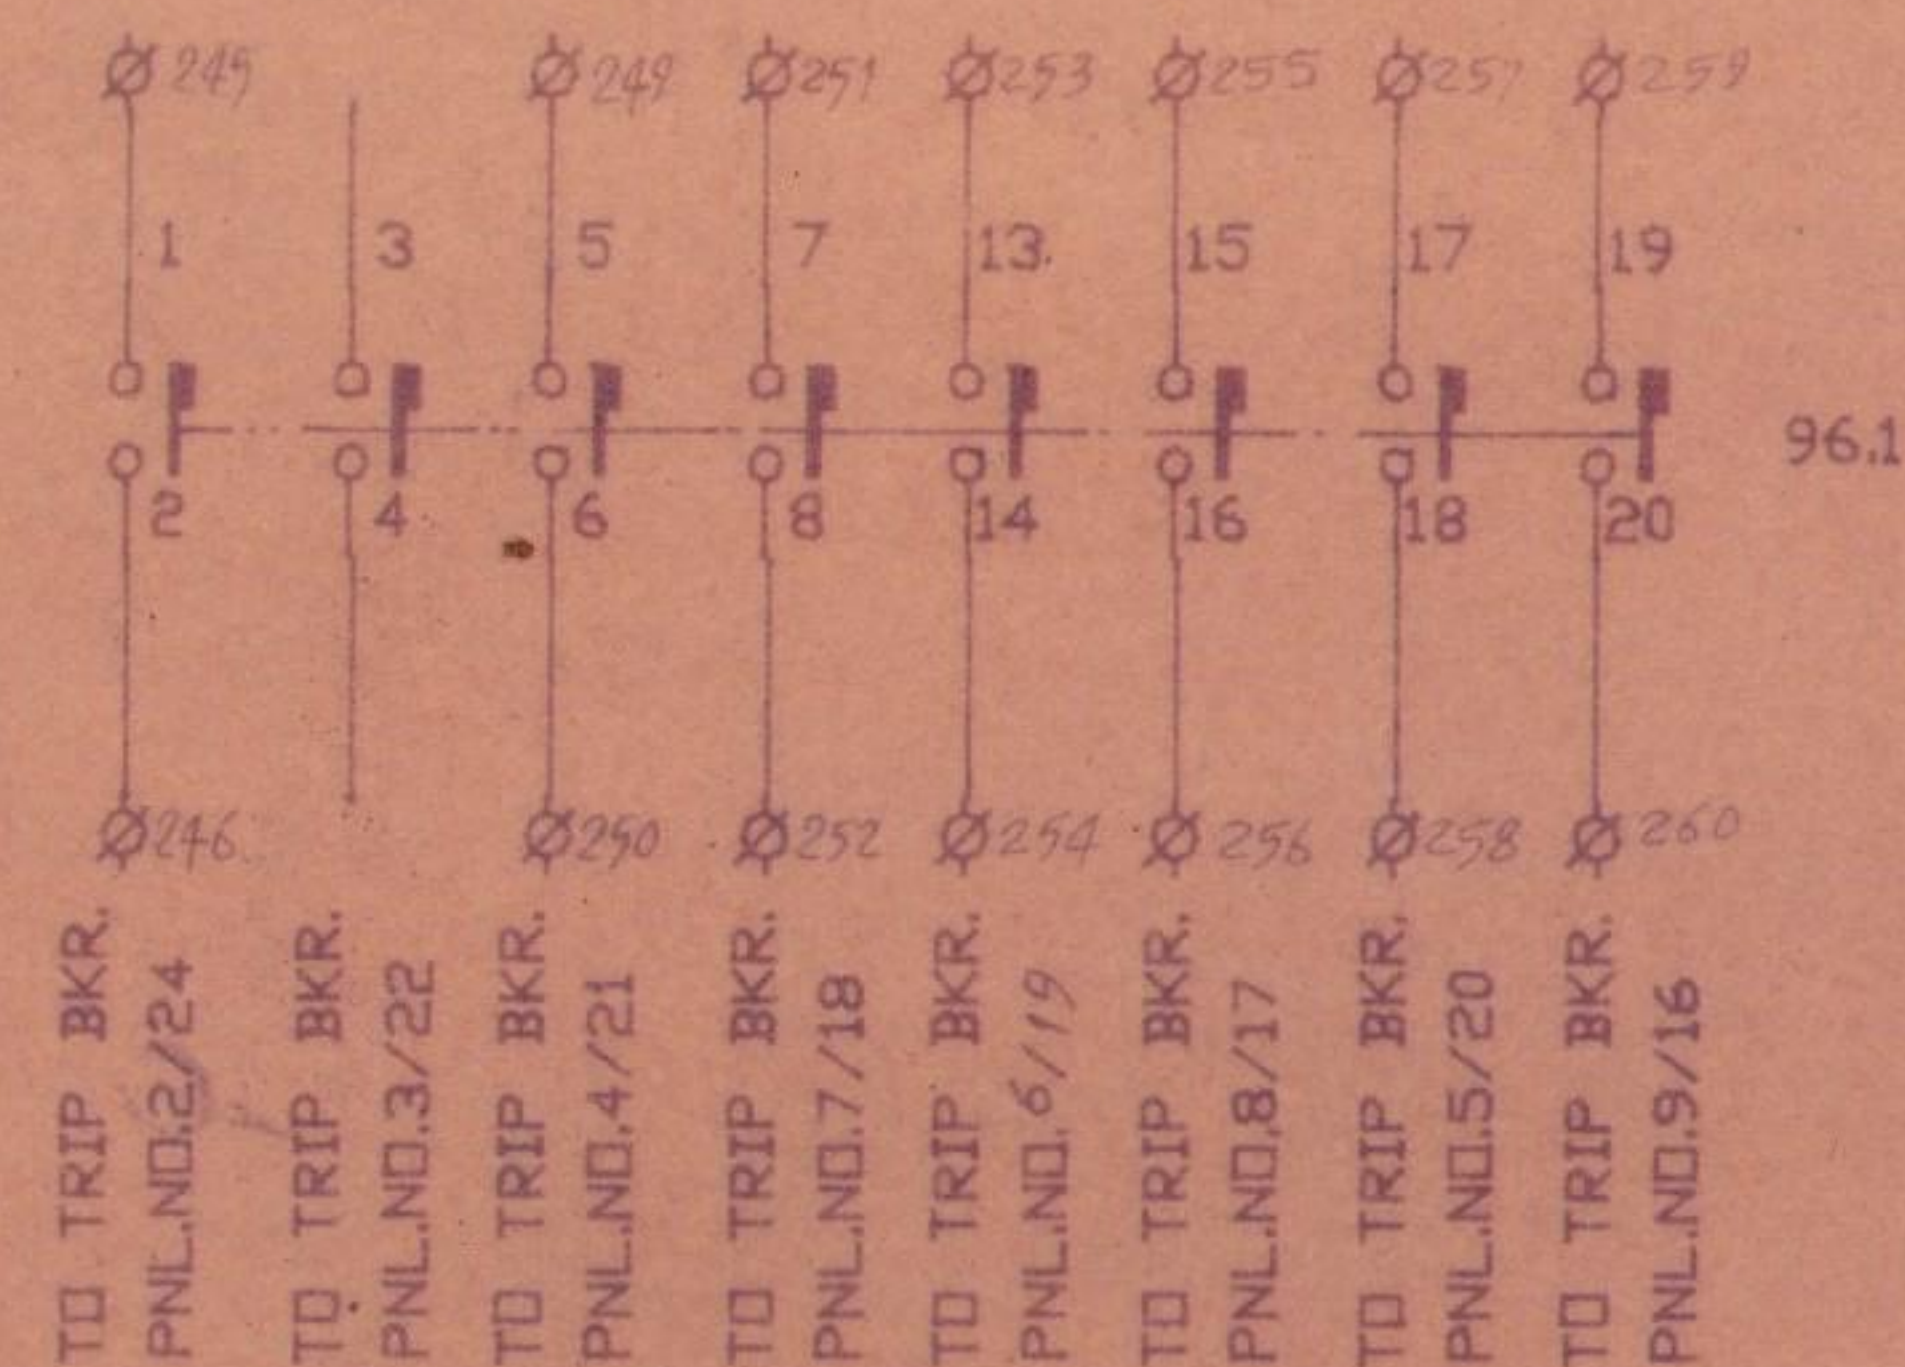

AS BUILT