



PRODUCED BY AN AUTODESK EDUCATIONAL PRODUCT

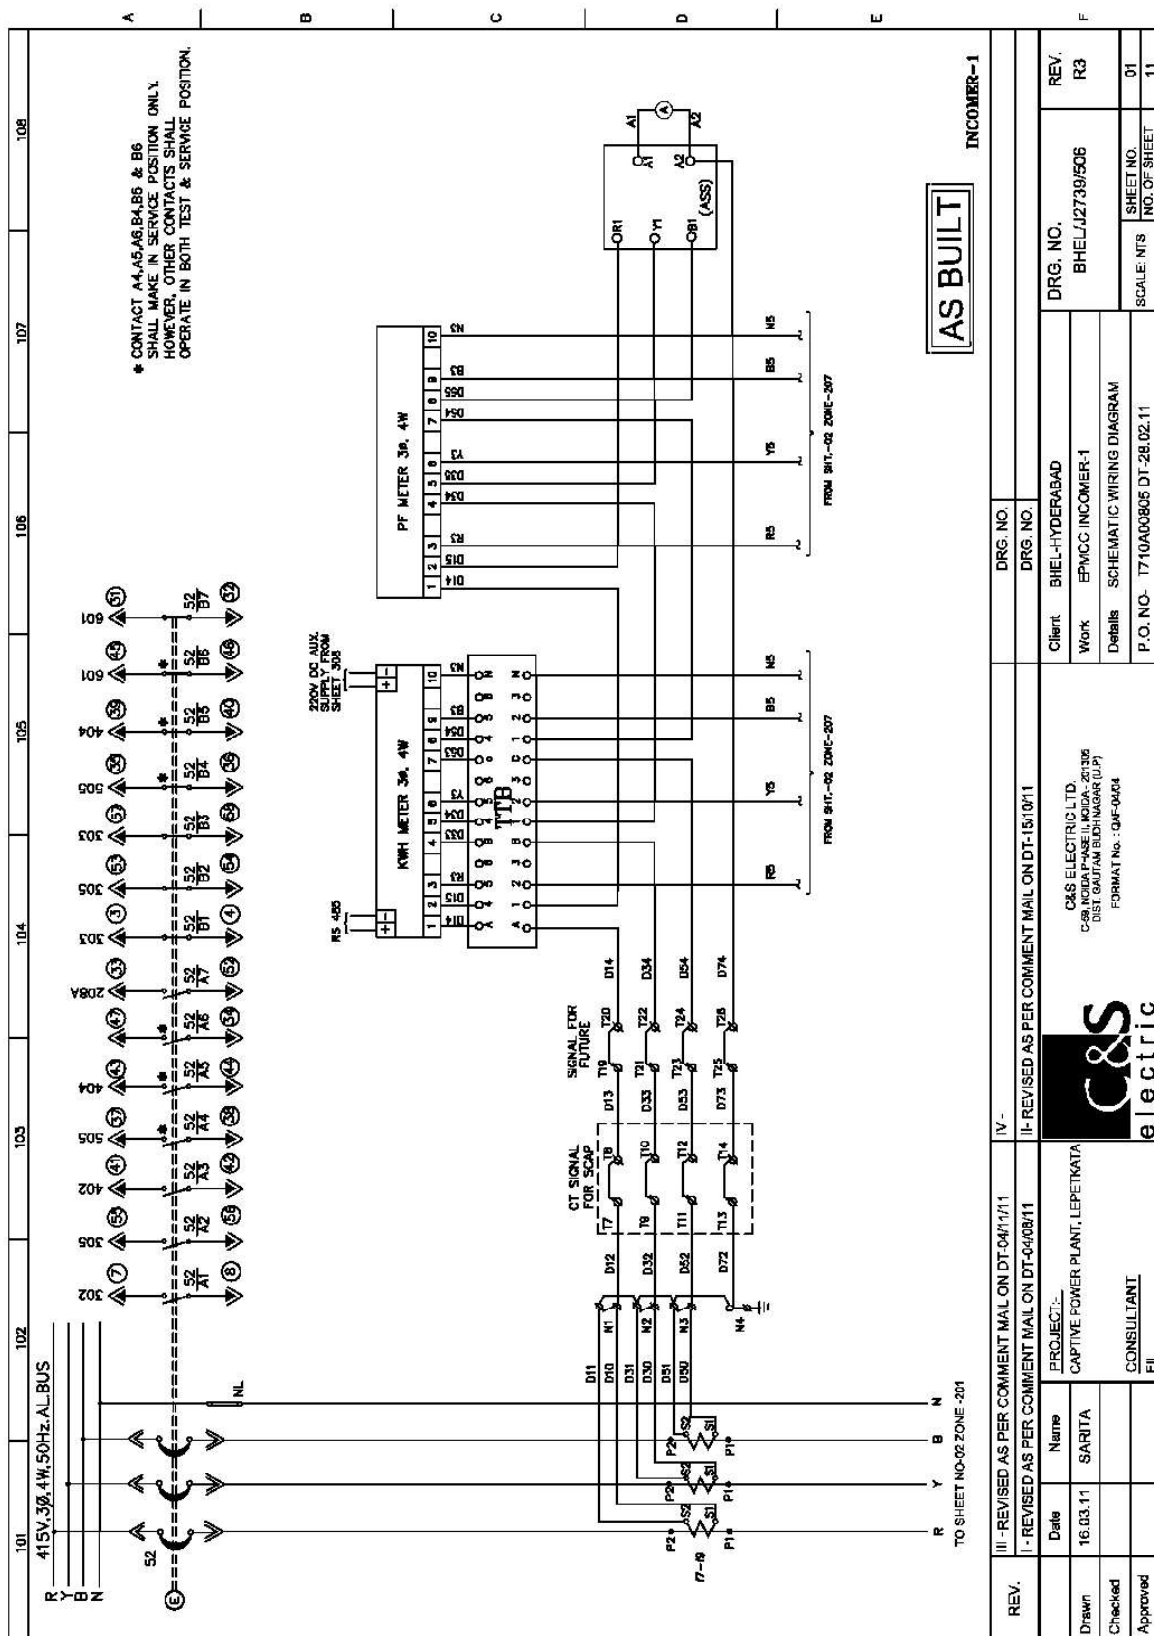


The contents of this Drawing are the sole property of C&S ELECTRIC LTD. and they should neither be copied nor given to a third person without the prior permission of Company

PRODUCED BY AN AUTODESK EDUCATIONAL PRODUCT

PRODUCED BY AN AUTODESK EDUCATIONAL PRODUCT

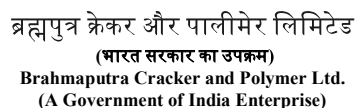

PRODUCED BY AN AUTODESK EDUCATIONAL PRODUCT

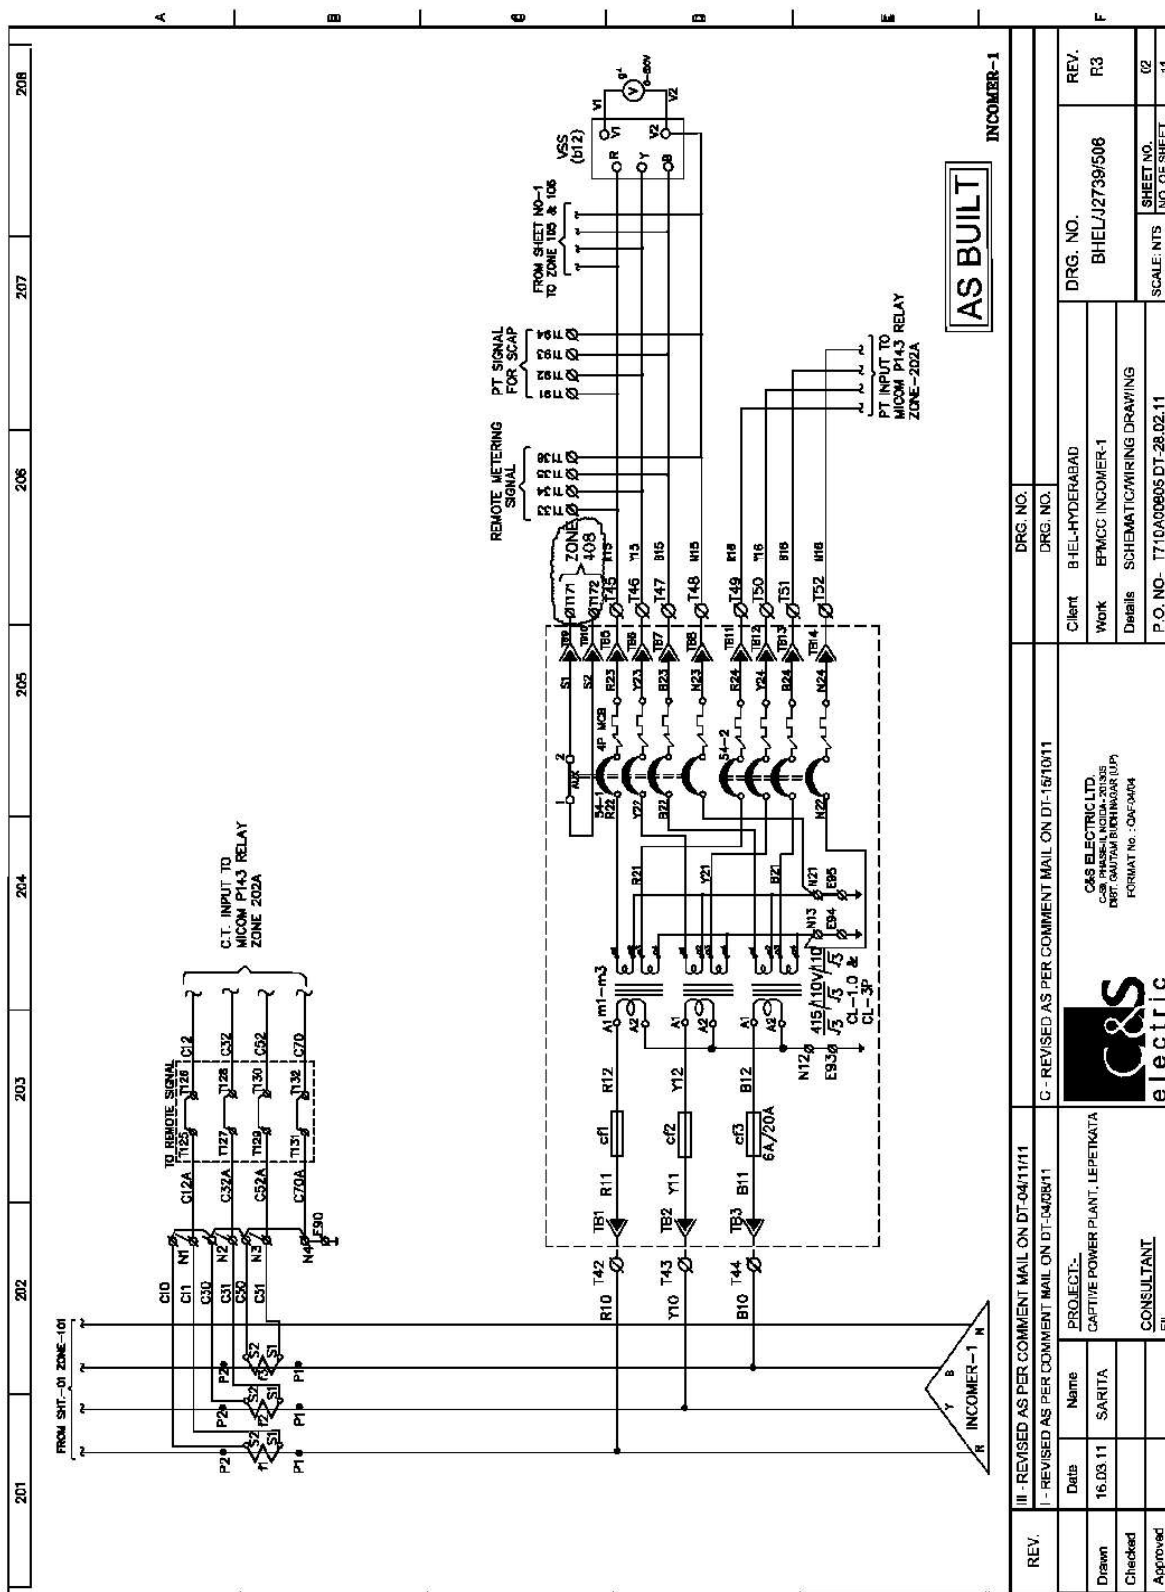

The contents of this Drawing are the sole property of
CONTROLS & SWITCHGEAR COMPANY LTD.
and they should neither be copied nor given to a third
person without the prior permission of Company


PRODUCED BY AN AUTODESK EDUCATIONAL PRODUCT

PRODUCED BY AN AUTODESK EDUCATIONAL PRODUCT



PRODUCED BY AN AUTODESK EDUCATIONAL PRODUCT


The contents of this Drawing are the sole property of C&S ELECTRIC LTD.
and they should neither be copied nor given to a third person without the prior permission of Company

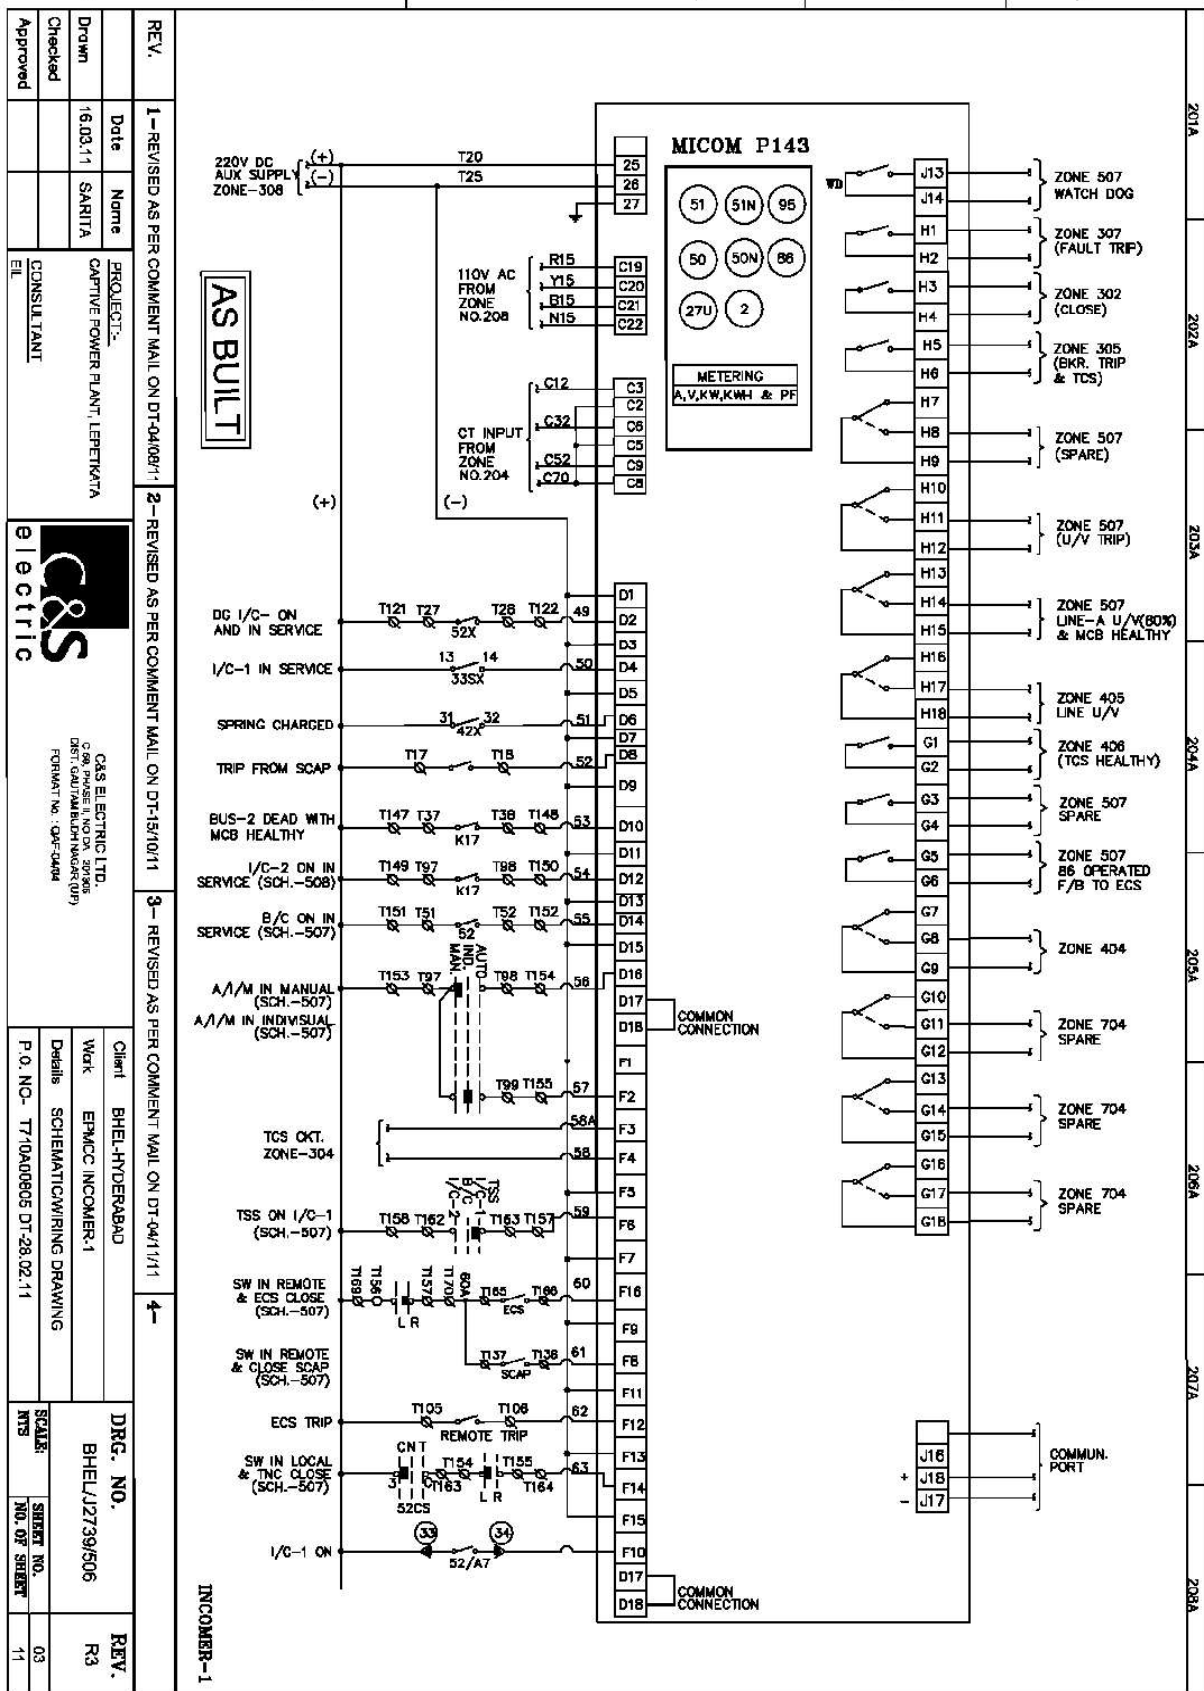

PRODUCED BY AN AUTODESK EDUCATIONAL PRODUCT

PRODUCED BY AN AUTODESK EDUCATIONAL PRODUCT

The contents of this Drawing are the sole property of C&S ELECTRIC LTD.
and they should neither be copied nor given to a third person without the prior permission of Company

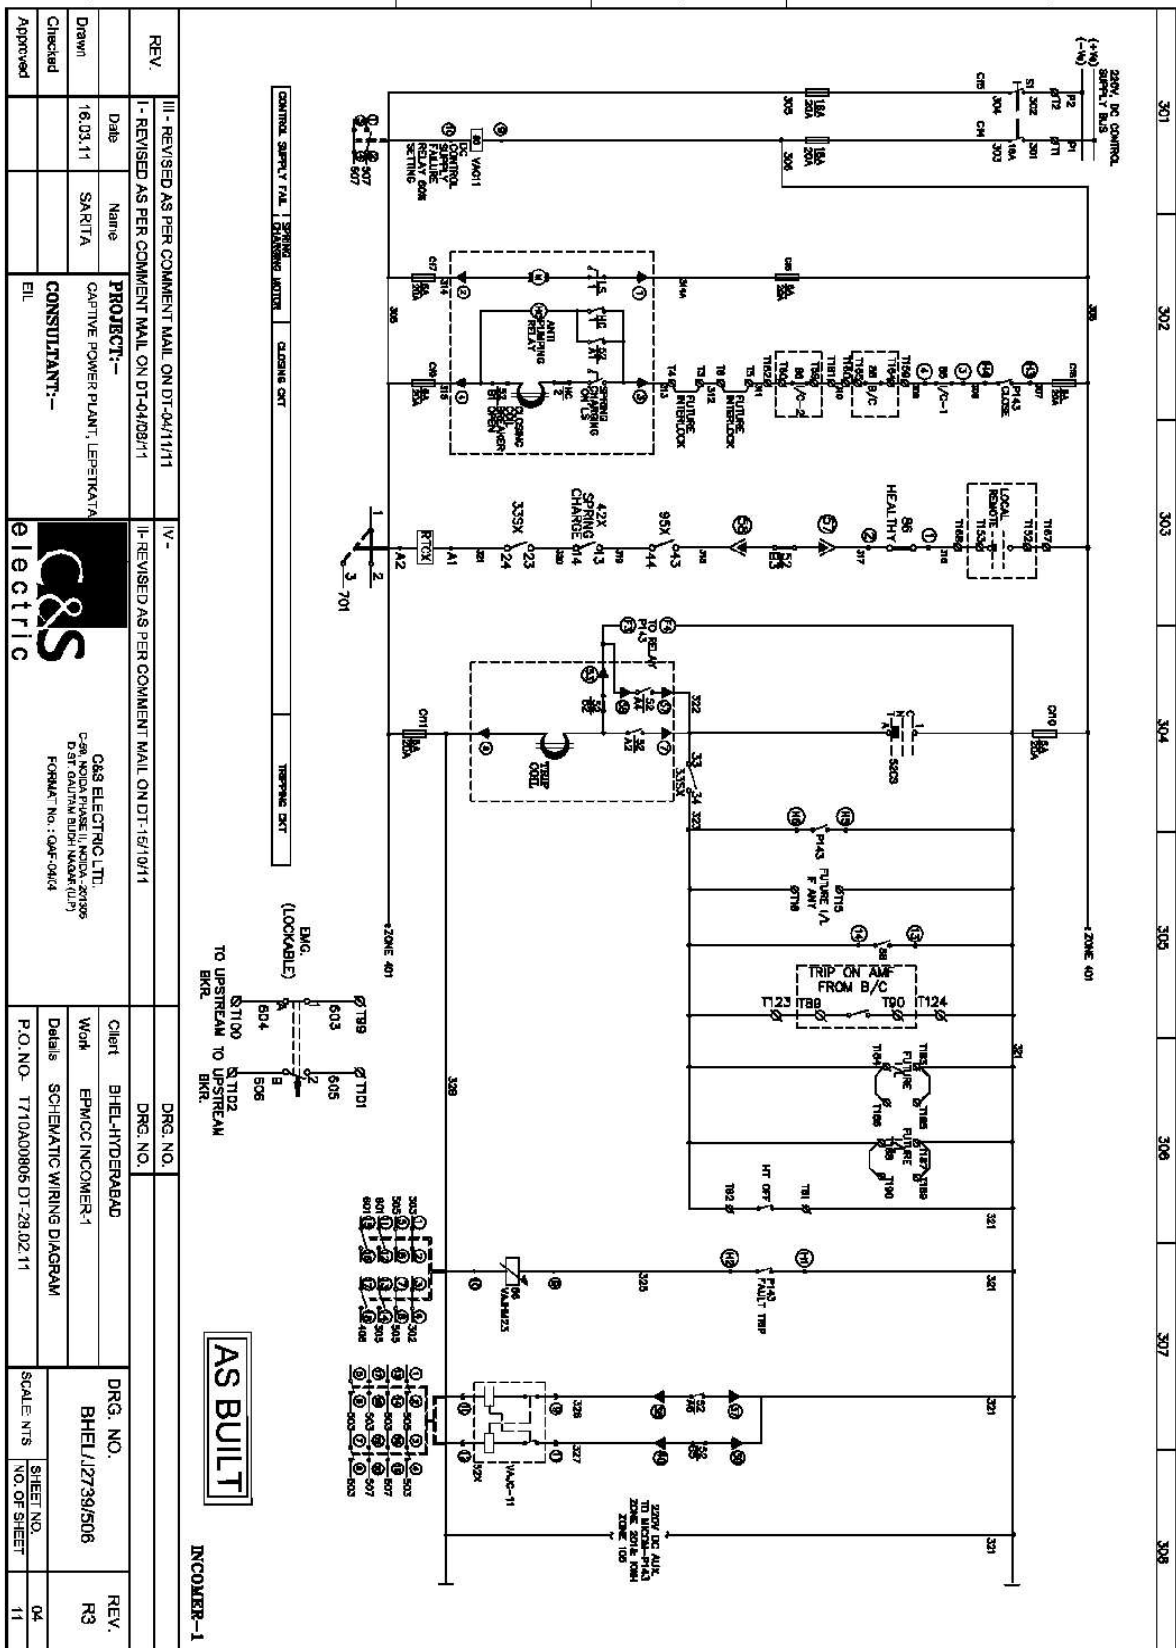


PRODUCED BY AN AUTODESK EDUCATIONAL PRODUCT



PRODUCED BY AN AUTODESK EDUCATIONAL PRODUCT

PRODUCED BY AN AUTODESK EDUCATIONAL PRODUCT

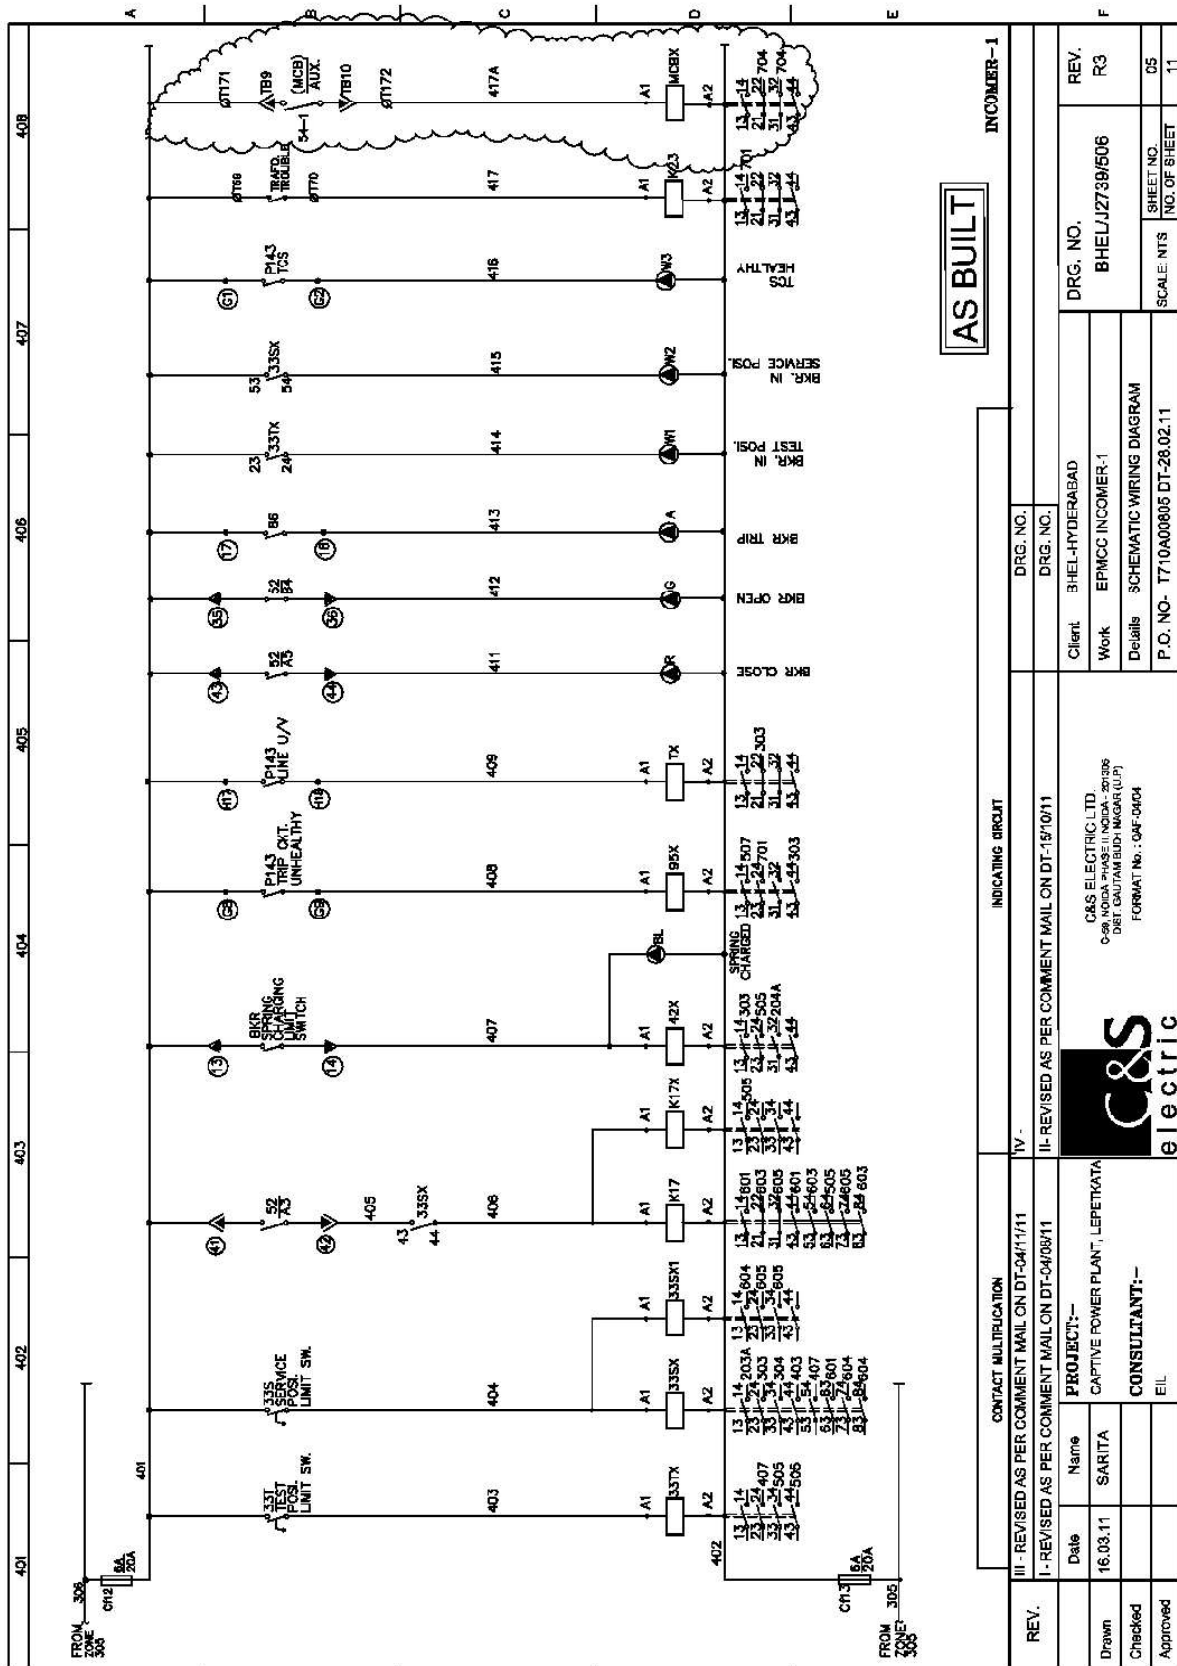

PRODUCED BY AN AUTODESK EDUCATIONAL PRODUCT


The contents of this Drawing are the sole property of C&S ELECTRIC LTD. and they should neither be copied nor given to a third person without the prior permission of Company.

PRODUCED BY AN AUTODESK EDUCATIONAL PRODUCT




PRODUCED BY AN AUTODESK EDUCATIONAL PRODUCT

PRODUCED BY AN AUTODESK EDUCATIONAL PRODUCT

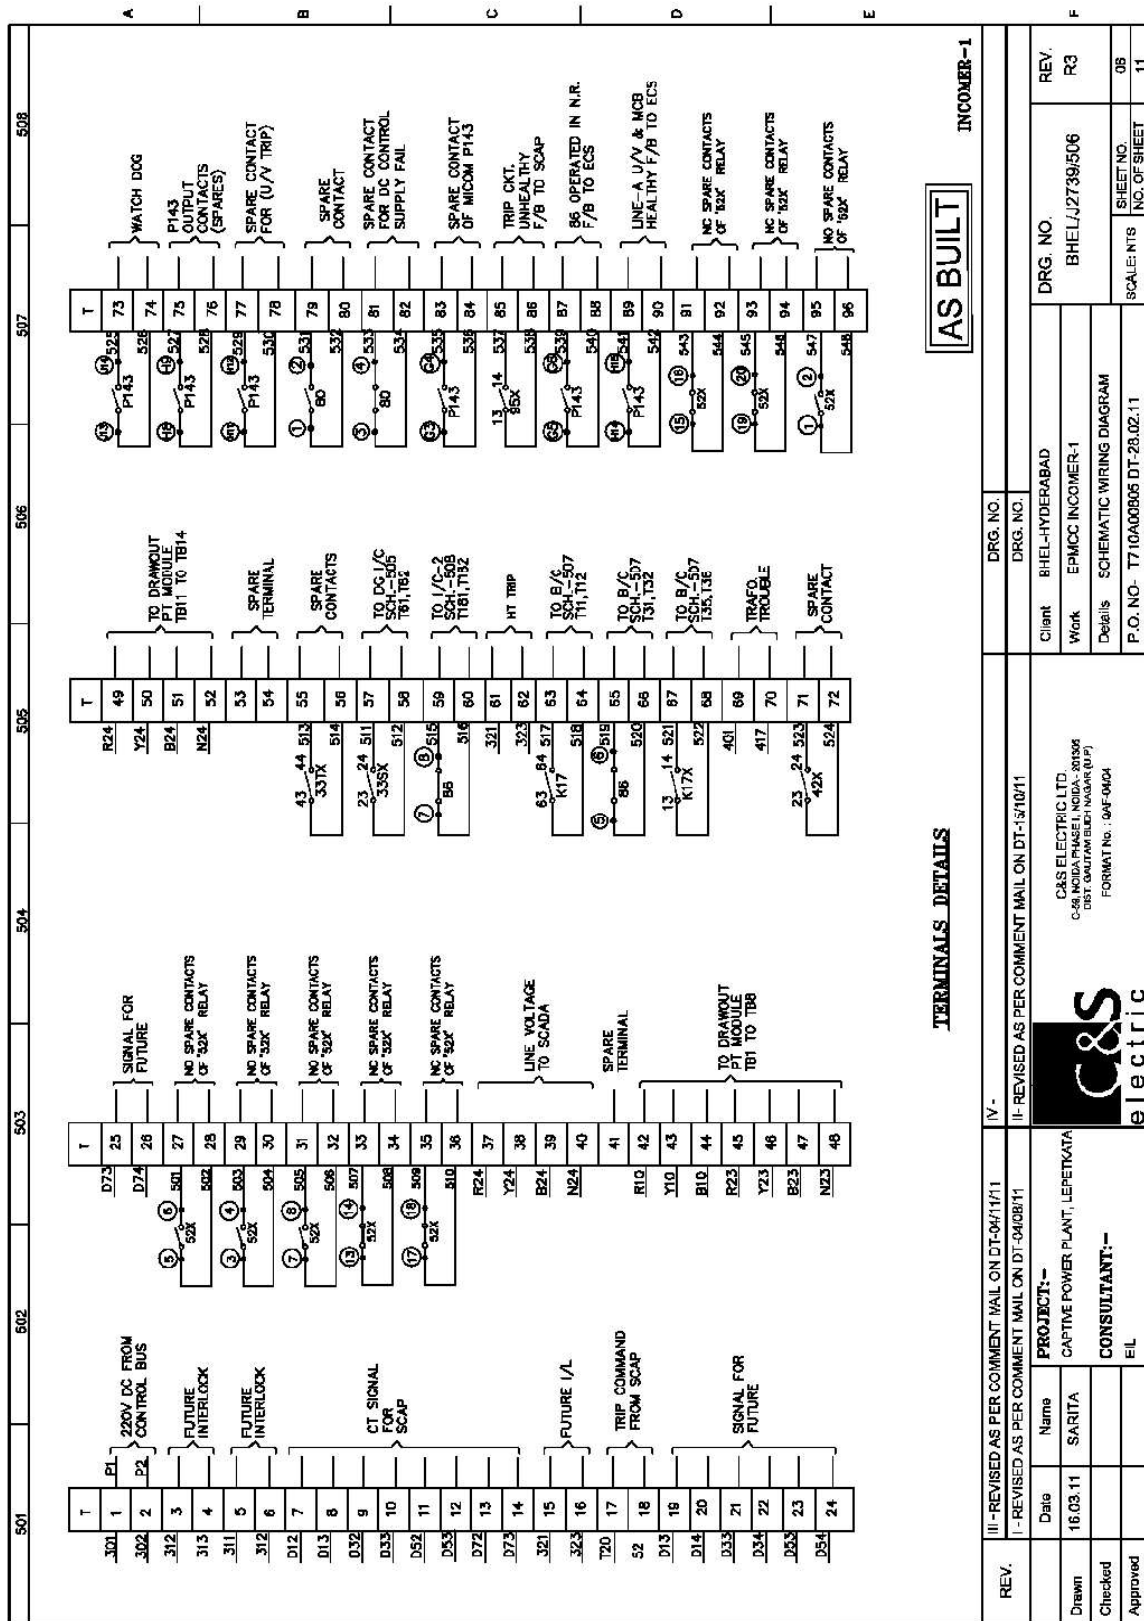


PRODUCED BY AN AUTODESK EDUCATIONAL PRODUCT


PRODUCED BY AN AUTODESK EDUCATIONAL PRODUCT

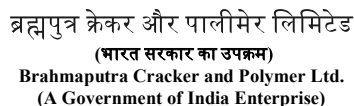


PRODUCED BY AN AUTODESK EDUCATIONAL PRODUCT

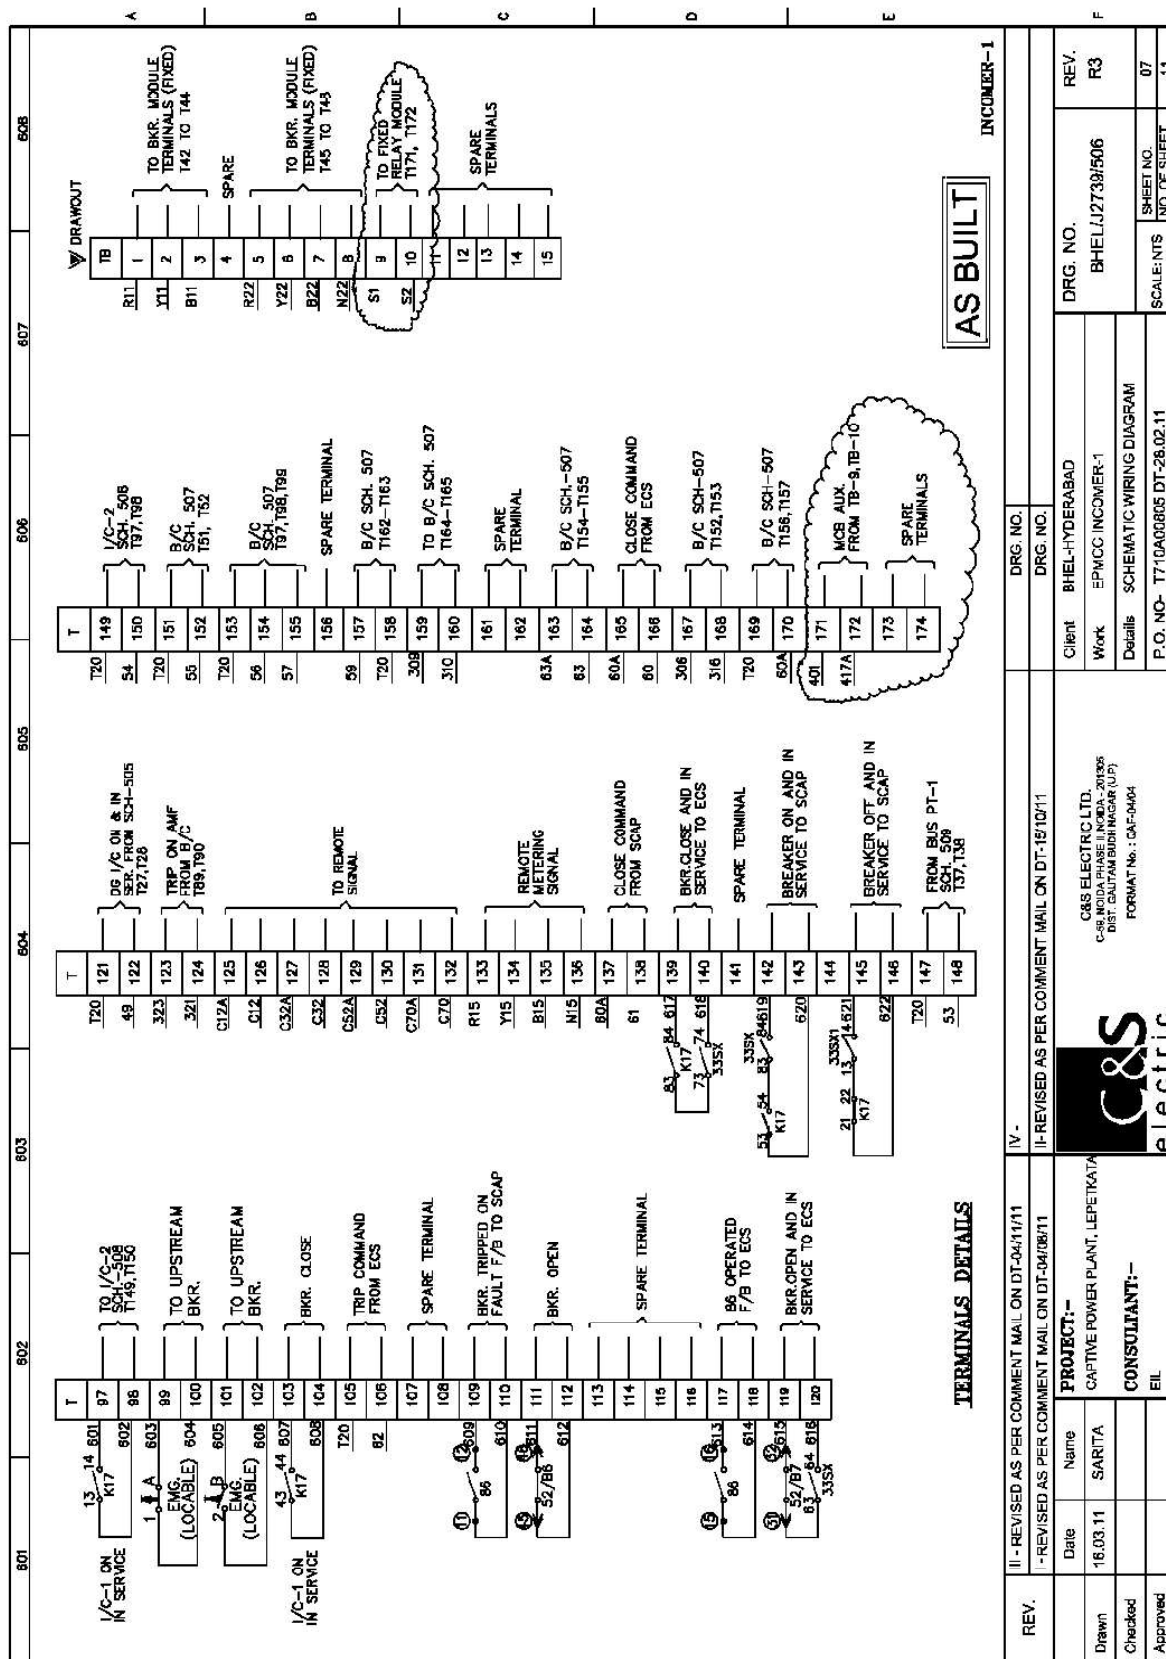


PRODUCED BY AN AUTODESK EDUCATIONAL PRODUCT

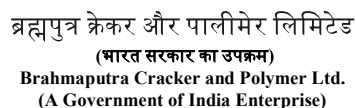


PRODUCED BY AN AUTODESK EDUCATIONAL PRODUCT

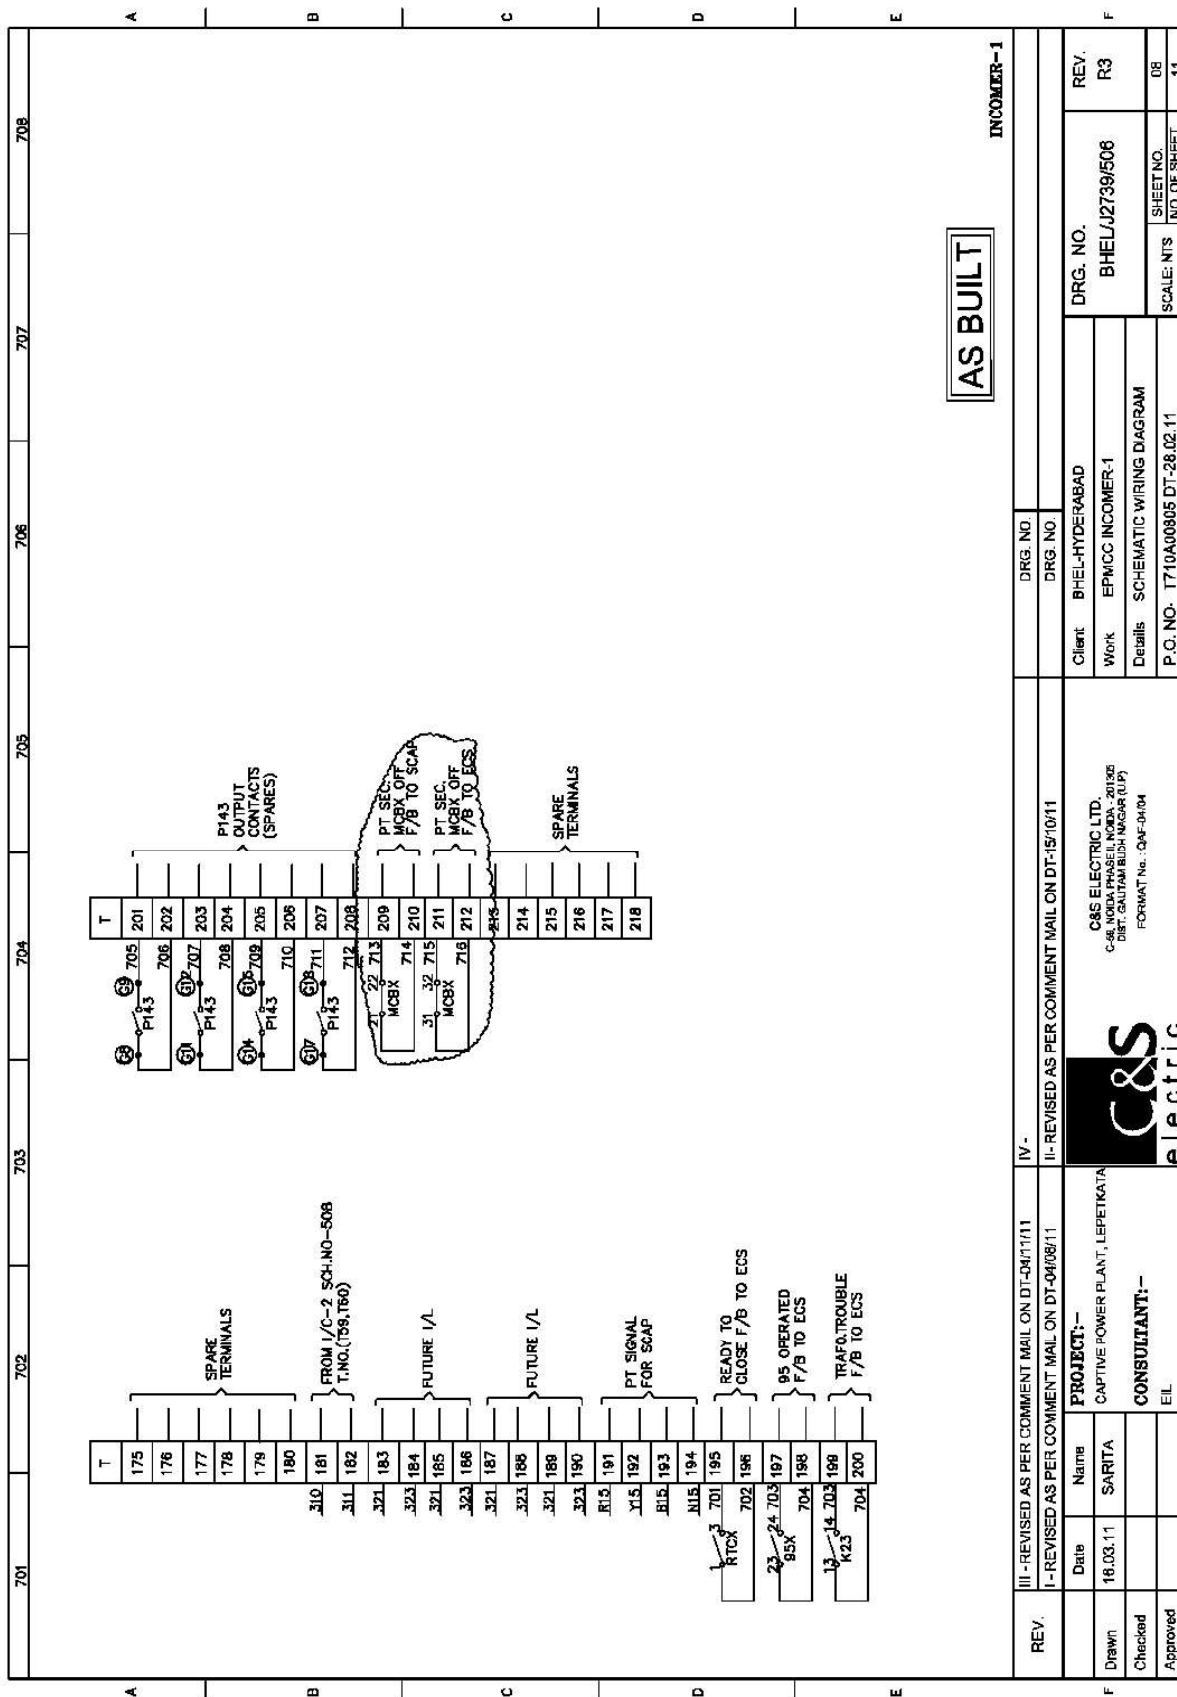

PRODUCED BY AN AUTODESK EDUCATIONAL PRODUCT

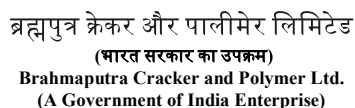

PRODUCED BY AN AUTODESK EDUCATIONAL PRODUCT

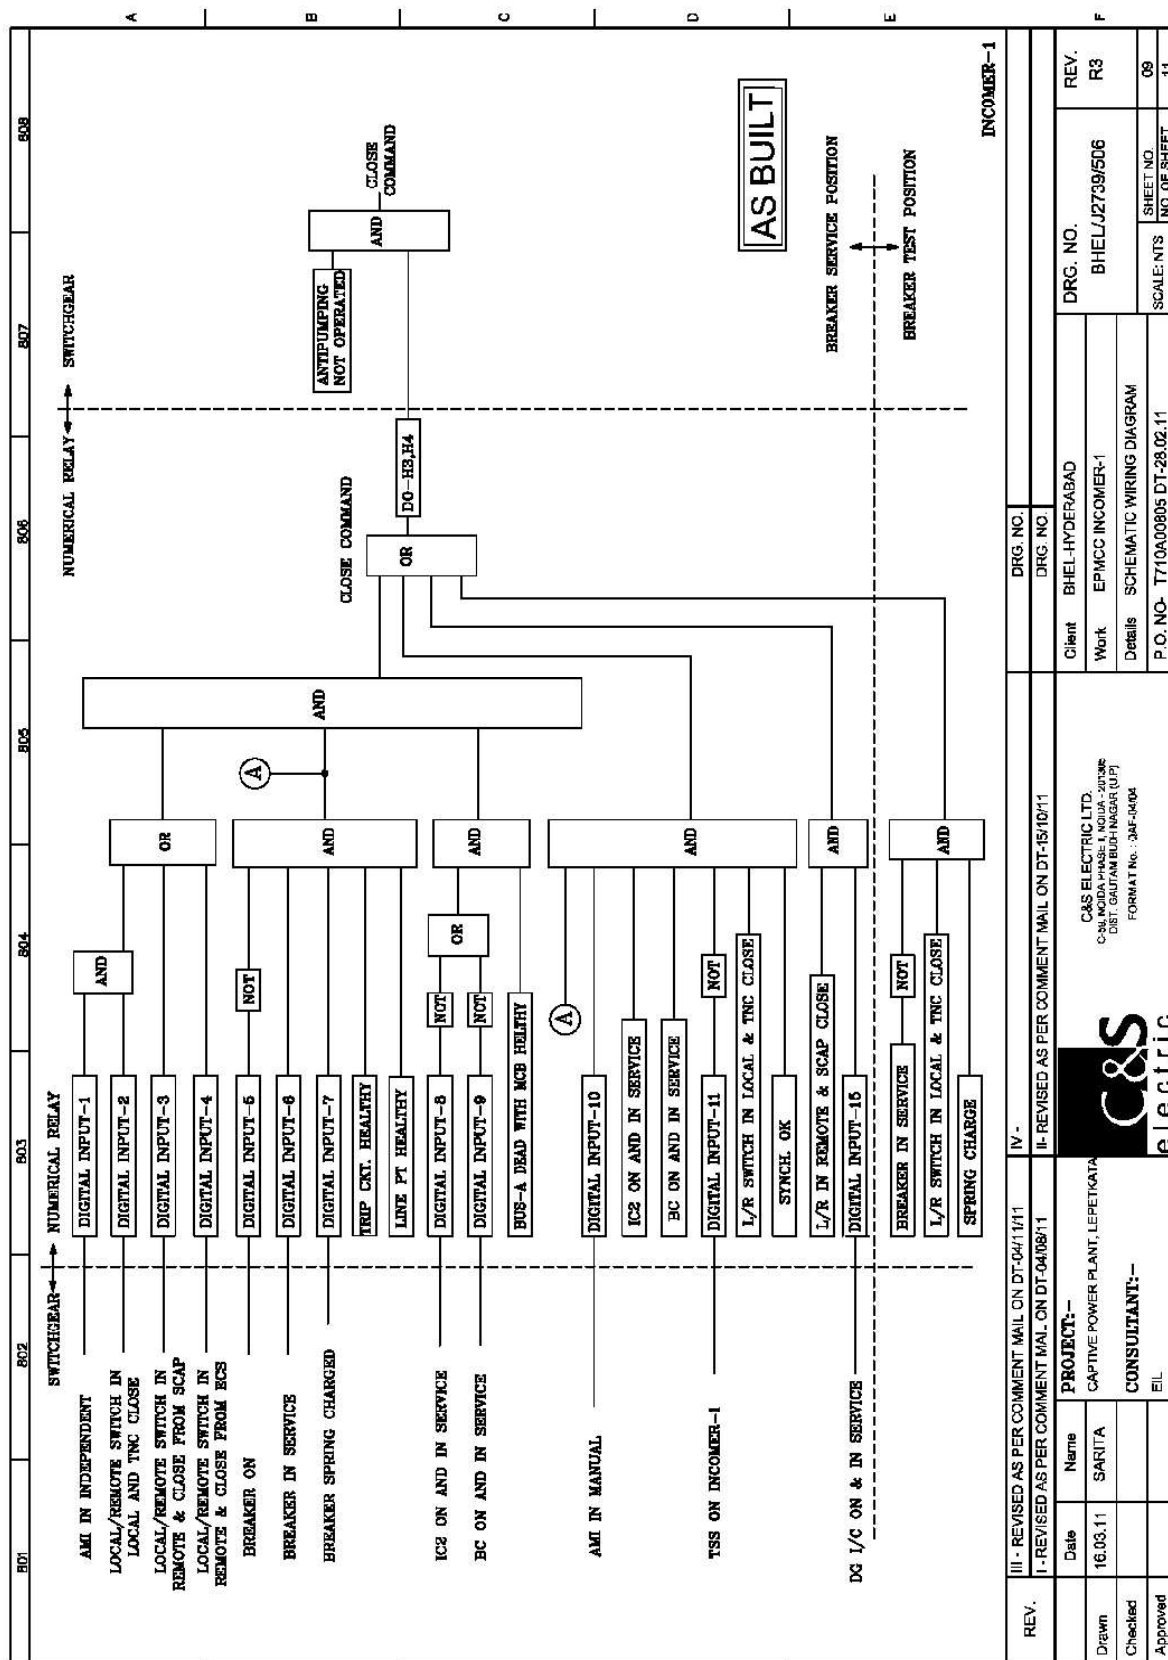


PRODUCED BY AN AUTODESK EDUCATIONAL PRODUCT

PRODUCED BY AN AUTODESK EDUCATIONAL PRODUCT



PRODUCED BY AN AUTODESK EDUCATIONAL PRODUCT

PRODUCED BY AN AUTODESK EDUCATIONAL PRODUCT

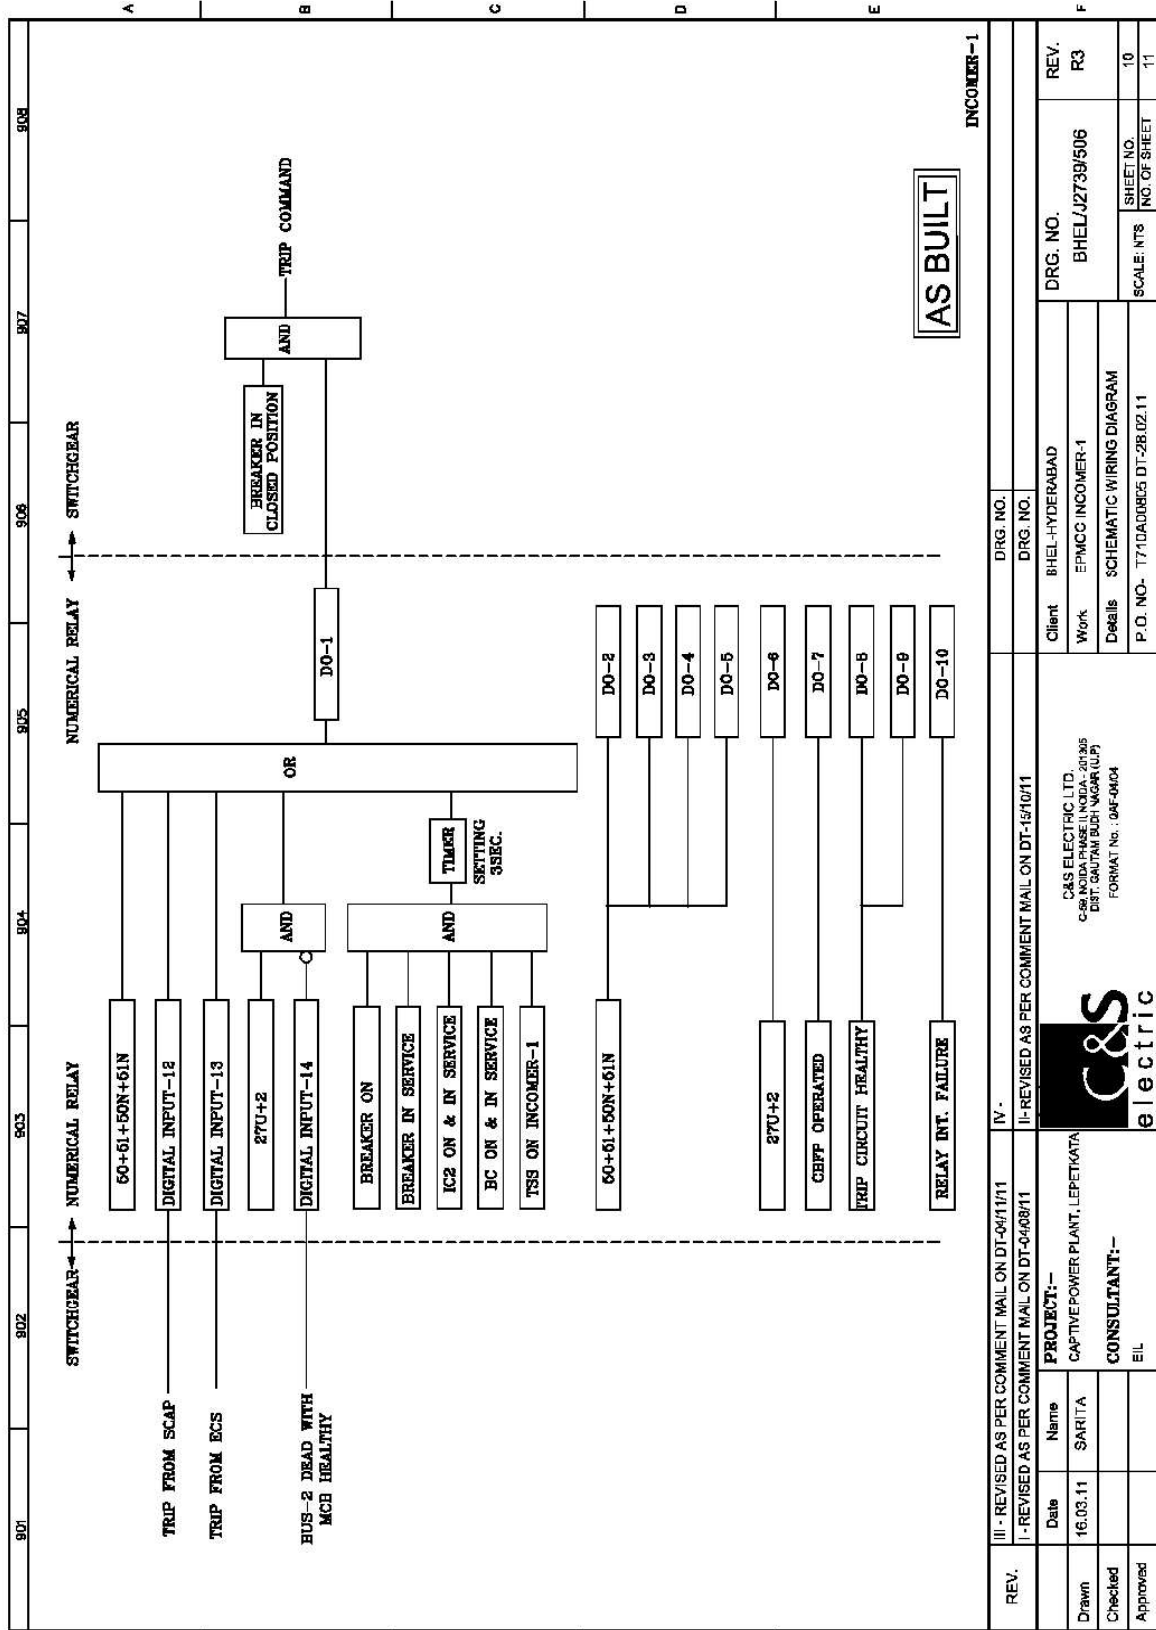

PRODUCED BY AN AUTODESK EDUCATIONAL PRODUCT

PRODUCED BY AN AUTODESK EDUCATIONAL PRODUCT

The contents of this Drawing are the sole property of C&S ELECTRIC LTD. and they should neither be copied nor given to a third person without the prior permission of Company.



PRODUCED BY AN AUTODESK EDUCATIONAL PRODUCT

PRODUCED BY AN AUTODESK EDUCATIONAL PRODUCT

PRODUCED BY AN AUTODESK EDUCATIONAL PRODUCT

REV.	1001	1002	1003	1004	1005	1006	1007	1008	
PROTECTION FUNCTIONS <table border="1"><thead><tr><th>Sl</th><th>FUNCTION</th></tr></thead><tbody><tr><td>1</td><td>3-PH. DMT/DMT O/C PROTECTION</td></tr><tr><td>2</td><td>3-PH. INST./DMT O/C PROTECTION</td></tr><tr><td>3</td><td>DMT/DMT E/F PROTECTION</td></tr><tr><td>4</td><td>INST./DMT E/F PROTECTION</td></tr><tr><td>5</td><td>LINE UNDER VOLTAGE WITH TIMER</td></tr><tr><td>6</td><td>CHECK SYNCHRONISM</td></tr><tr><td>7</td><td>CIRCUIT BREAKER FAILURE</td></tr></tbody></table> MEASUREMENT FUNCTIONS <table border="1"><thead><tr><th>Sl</th><th>FUNCTION</th></tr></thead><tbody><tr><td>8</td><td>3-PHASE CURRENT MEASUREMENT</td></tr><tr><td>9</td><td>NEUTRAL CURRENT MEASUREMENT</td></tr><tr><td>10</td><td>3-PHASE VOLTAGE MEASUREMENT</td></tr><tr><td>11</td><td>ACTIVE POWER MEASUREMENT</td></tr><tr><td>12</td><td>REACTIVE POWER MEASUREMENT</td></tr><tr><td>13</td><td>ENERGY MEASUREMENT</td></tr><tr><td>14</td><td>POWER FACTOR MEASUREMENT</td></tr></tbody></table> CONDITION MONITORING FEATURES <table border="1"><thead><tr><th>Sl</th><th>FUNCTION</th></tr></thead><tbody><tr><td>15</td><td>RELAY INTERNAL SELF SUPERVISION</td></tr><tr><td>16</td><td>TRIP CIRCUIT SUPERVISION</td></tr><tr><td>17</td><td>BREAKER CONDITION MONITORING</td></tr></tbody></table> OTHER FUNCTIONS AVAILABLE IN RELAY <table border="1"><thead><tr><th>Sl</th><th>FUNCTION</th></tr></thead><tbody><tr><td>18</td><td>CIRCUIT BREAKER CONTROL</td></tr><tr><td>19</td><td>DISTURBANCE RECORDING</td></tr><tr><td>20</td><td>FAULT RECORDING</td></tr><tr><td>21</td><td>EVENT RECORDING</td></tr><tr><td>22</td><td>DOUBLING FEATURE DURING STARTING</td></tr></tbody></table> LED INDICATION ON RELAY <table border="1"><thead><tr><th>LED</th><th>DESCRIPTION</th></tr></thead><tbody><tr><td>1</td><td>DMT OVER CURRENT TRIP</td></tr><tr><td>2</td><td>INST. OVER CURRENT TRIP</td></tr><tr><td>3</td><td>DMT EARTH FAULT TRIP</td></tr><tr><td>4</td><td>INST. EARTH FAULT TRIP</td></tr><tr><td>5</td><td>CIRCUIT BREAKER FAILURE</td></tr><tr><td>6</td><td>TRIP CIRCUIT UNHEALTHY</td></tr><tr><td>7</td><td>DS SPRING NOT CHARGED</td></tr><tr><td>8</td><td>LOCKOUT OPERATED (LO)</td></tr><tr><td>9</td><td>DS CONDITION MONITORING ALARM</td></tr><tr><td>10</td><td>LINE UNDER VOLTAGE</td></tr><tr><td>11</td><td>SYNCHROCHECK OK</td></tr></tbody></table> SIGNALS WIRED TO DI OF RELAY <table border="1"><thead><tr><th>INPUT NO.</th><th>INPUT DES.</th><th>SIGNAL DESCRIPTION</th></tr></thead><tbody><tr><td>D1-1</td><td>D1-F2</td><td>ALI IN INDEPENDENT</td></tr><tr><td>D1-2</td><td>D1-F14</td><td>SW IN LOCAL & TRIP CLOSE</td></tr><tr><td>D1-3</td><td>D1-F8</td><td>SW IN REMOTE & CLOSE FROM SCAP</td></tr><tr><td>D1-4</td><td>D1-F16</td><td>SW IN REMOTE & CLOSE FROM EDS</td></tr><tr><td>D1-5</td><td>D1-F10</td><td>INCOMER-1 ON</td></tr><tr><td>D1-6</td><td>D1-D4</td><td>I/C-1 IN SERVICE</td></tr><tr><td>D1-7</td><td>D1-D8</td><td>SPRING CHARGED</td></tr><tr><td>D1-8</td><td>D1-D12</td><td>MOUSER-2 ON IN SERVICE</td></tr><tr><td>D1-9</td><td>D1-D14</td><td>B/C ON IN SERVICE</td></tr><tr><td>D1-10</td><td>D1-D16</td><td>ALI IN MANUAL</td></tr><tr><td>D1-11</td><td>D1-D18</td><td>TSS ON I/C-1</td></tr><tr><td>D1-12</td><td>D1-D18</td><td>TRIP FROM SCAP</td></tr><tr><td>D1-13</td><td>D1-D12</td><td>TRIP FROM EDS</td></tr><tr><td>D1-14</td><td>D1-D10</td><td>BUS-2 READ WITH MCS HEALTHY</td></tr><tr><td>D1-15</td><td>D1-D12</td><td>DS I/C ON AND IN SERVICE FROM DO I/C</td></tr></tbody></table> OUTPUT CONTACT OF RELAY <table border="1"><thead><tr><th>OUTPUT NO.</th><th>SIGNAL DESCRIPTION</th></tr></thead><tbody><tr><td>H13, H14</td><td>WATCH DOG</td></tr><tr><td>H11, H2</td><td>FAULT TRIP</td></tr><tr><td>H3, H4</td><td>CB CLOSE COMMAND</td></tr><tr><td>H5, H6</td><td>BKR. TRIP & TCS</td></tr><tr><td>H8, H9</td><td>SPARE CONTACT</td></tr><tr><td>H11, H12</td><td>U/Y TRIP</td></tr><tr><td>H14, H15</td><td>LINE-A U/Y</td></tr><tr><td>H17, H18</td><td>LINE U/Y</td></tr><tr><td>G1, G2</td><td>TRIP CIRCUIT HEALTHY</td></tr><tr><td>G3, G4</td><td>SPARE CONTACT</td></tr><tr><td>G6, G8</td><td>DS OPERATED I/FB TO EDS</td></tr><tr><td>G8, G9</td><td>SPARE CONTACT</td></tr><tr><td>G11, G12</td><td>SPARE CONTACT</td></tr><tr><td>G14, G15</td><td>SPARE CONTACT</td></tr><tr><td>G17, G18</td><td>SPARE CONTACT</td></tr></tbody></table> RELAY COMMUNICATION DETAILS <table border="1"><thead><tr><th>FRONT COMMUNICATION PORT</th><th>RS232</th></tr><tr><th>REAR COMMUNICATION PORT</th><th>RS485</th></tr><tr><th>COMMUNICATION PROTOCOL</th><th>IEC-61850</th></tr></thead></table> INCOMER-1 AS BUILT									Sl	FUNCTION	1	3-PH. DMT/DMT O/C PROTECTION	2	3-PH. INST./DMT O/C PROTECTION	3	DMT/DMT E/F PROTECTION	4	INST./DMT E/F PROTECTION	5	LINE UNDER VOLTAGE WITH TIMER	6	CHECK SYNCHRONISM	7	CIRCUIT BREAKER FAILURE	Sl	FUNCTION	8	3-PHASE CURRENT MEASUREMENT	9	NEUTRAL CURRENT MEASUREMENT	10	3-PHASE VOLTAGE MEASUREMENT	11	ACTIVE POWER MEASUREMENT	12	REACTIVE POWER MEASUREMENT	13	ENERGY MEASUREMENT	14	POWER FACTOR MEASUREMENT	Sl	FUNCTION	15	RELAY INTERNAL SELF SUPERVISION	16	TRIP CIRCUIT SUPERVISION	17	BREAKER CONDITION MONITORING	Sl	FUNCTION	18	CIRCUIT BREAKER CONTROL	19	DISTURBANCE RECORDING	20	FAULT RECORDING	21	EVENT RECORDING	22	DOUBLING FEATURE DURING STARTING	LED	DESCRIPTION	1	DMT OVER CURRENT TRIP	2	INST. OVER CURRENT TRIP	3	DMT EARTH FAULT TRIP	4	INST. EARTH FAULT TRIP	5	CIRCUIT BREAKER FAILURE	6	TRIP CIRCUIT UNHEALTHY	7	DS SPRING NOT CHARGED	8	LOCKOUT OPERATED (LO)	9	DS CONDITION MONITORING ALARM	10	LINE UNDER VOLTAGE	11	SYNCHROCHECK OK	INPUT NO.	INPUT DES.	SIGNAL DESCRIPTION	D1-1	D1-F2	ALI IN INDEPENDENT	D1-2	D1-F14	SW IN LOCAL & TRIP CLOSE	D1-3	D1-F8	SW IN REMOTE & CLOSE FROM SCAP	D1-4	D1-F16	SW IN REMOTE & CLOSE FROM EDS	D1-5	D1-F10	INCOMER-1 ON	D1-6	D1-D4	I/C-1 IN SERVICE	D1-7	D1-D8	SPRING CHARGED	D1-8	D1-D12	MOUSER-2 ON IN SERVICE	D1-9	D1-D14	B/C ON IN SERVICE	D1-10	D1-D16	ALI IN MANUAL	D1-11	D1-D18	TSS ON I/C-1	D1-12	D1-D18	TRIP FROM SCAP	D1-13	D1-D12	TRIP FROM EDS	D1-14	D1-D10	BUS-2 READ WITH MCS HEALTHY	D1-15	D1-D12	DS I/C ON AND IN SERVICE FROM DO I/C	OUTPUT NO.	SIGNAL DESCRIPTION	H13, H14	WATCH DOG	H11, H2	FAULT TRIP	H3, H4	CB CLOSE COMMAND	H5, H6	BKR. TRIP & TCS	H8, H9	SPARE CONTACT	H11, H12	U/Y TRIP	H14, H15	LINE-A U/Y	H17, H18	LINE U/Y	G1, G2	TRIP CIRCUIT HEALTHY	G3, G4	SPARE CONTACT	G6, G8	DS OPERATED I/FB TO EDS	G8, G9	SPARE CONTACT	G11, G12	SPARE CONTACT	G14, G15	SPARE CONTACT	G17, G18	SPARE CONTACT	FRONT COMMUNICATION PORT	RS232	REAR COMMUNICATION PORT	RS485	COMMUNICATION PROTOCOL	IEC-61850
Sl	FUNCTION	
1	3-PH. DMT/DMT O/C PROTECTION	
2	3-PH. INST./DMT O/C PROTECTION	
3	DMT/DMT E/F PROTECTION	
4	INST./DMT E/F PROTECTION	
5	LINE UNDER VOLTAGE WITH TIMER	
6	CHECK SYNCHRONISM	
7	CIRCUIT BREAKER FAILURE	
Sl	FUNCTION	
8	3-PHASE CURRENT MEASUREMENT	
9	NEUTRAL CURRENT MEASUREMENT	
10	3-PHASE VOLTAGE MEASUREMENT	
11	ACTIVE POWER MEASUREMENT	
12	REACTIVE POWER MEASUREMENT	
13	ENERGY MEASUREMENT	
14	POWER FACTOR MEASUREMENT	
Sl	FUNCTION	
15	RELAY INTERNAL SELF SUPERVISION	
16	TRIP CIRCUIT SUPERVISION	
17	BREAKER CONDITION MONITORING	
Sl	FUNCTION	
18	CIRCUIT BREAKER CONTROL	
19	DISTURBANCE RECORDING	
20	FAULT RECORDING	
21	EVENT RECORDING	
22	DOUBLING FEATURE DURING STARTING	
LED	DESCRIPTION	
1	DMT OVER CURRENT TRIP	
2	INST. OVER CURRENT TRIP	
3	DMT EARTH FAULT TRIP	
4	INST. EARTH FAULT TRIP	
5	CIRCUIT BREAKER FAILURE	
6	TRIP CIRCUIT UNHEALTHY	
7	DS SPRING NOT CHARGED	
8	LOCKOUT OPERATED (LO)	
9	DS CONDITION MONITORING ALARM	
10	LINE UNDER VOLTAGE	
11	SYNCHROCHECK OK	
INPUT NO.	INPUT DES.	SIGNAL DESCRIPTION	
D1-1	D1-F2	ALI IN INDEPENDENT	
D1-2	D1-F14	SW IN LOCAL & TRIP CLOSE	
D1-3	D1-F8	SW IN REMOTE & CLOSE FROM SCAP	
D1-4	D1-F16	SW IN REMOTE & CLOSE FROM EDS	
D1-5	D1-F10	INCOMER-1 ON	
D1-6	D1-D4	I/C-1 IN SERVICE	
D1-7	D1-D8	SPRING CHARGED	
D1-8	D1-D12	MOUSER-2 ON IN SERVICE	
D1-9	D1-D14	B/C ON IN SERVICE	
D1-10	D1-D16	ALI IN MANUAL	
D1-11	D1-D18	TSS ON I/C-1	
D1-12	D1-D18	TRIP FROM SCAP	
D1-13	D1-D12	TRIP FROM EDS	
D1-14	D1-D10	BUS-2 READ WITH MCS HEALTHY	
D1-15	D1-D12	DS I/C ON AND IN SERVICE FROM DO I/C	
OUTPUT NO.	SIGNAL DESCRIPTION	
H13, H14	WATCH DOG	
H11, H2	FAULT TRIP	
H3, H4	CB CLOSE COMMAND	
H5, H6	BKR. TRIP & TCS	
H8, H9	SPARE CONTACT	
H11, H12	U/Y TRIP	
H14, H15	LINE-A U/Y	
H17, H18	LINE U/Y	
G1, G2	TRIP CIRCUIT HEALTHY	
G3, G4	SPARE CONTACT	
G6, G8	DS OPERATED I/FB TO EDS	
G8, G9	SPARE CONTACT	
G11, G12	SPARE CONTACT	
G14, G15	SPARE CONTACT	
G17, G18	SPARE CONTACT	
FRONT COMMUNICATION PORT	RS232	
REAR COMMUNICATION PORT	RS485	
COMMUNICATION PROTOCOL	IEC-61850	
REV.	III - REVISED AS PER COMMENT MAIL ON DT-04/11/11 I - REVISED AS PER COMMENT MAIL ON DT-04/08/11	IV - II - REVISED AS PER COMMENT MAIL ON DT-15/10/11	
Drawn	Date	Name	PROJECT:- CAPTIVE POWER PLANT, LEPTAKATA	C&S electric	
Approved			CONSULTANT:- EIL	Client: BHEL-HYDERABAD Work: EPMCC INCOMER-1 Details: SCHEMATIC WIRING DIAGRAM P.O. NO.: T7710A00805 DT-28.02.11	
				DRG. NO. BHEL/J2739/506 REV. R3	
				SHEET NO. 11 NO. OF SHEET 11	
				SCALE NTS	


PRODUCED BY AN AUTODESK EDUCATIONAL PRODUCT

The contents of this Drawing are the sole property of C&S ELECTRIC LTD. and they should neither be copied nor given to a third person without the prior permission of Company.



PRODUCED BY AN AUTODESK EDUCATIONAL PRODUCT

PRODUCED BY AN AUTODESK EDUCATIONAL PRODUCT

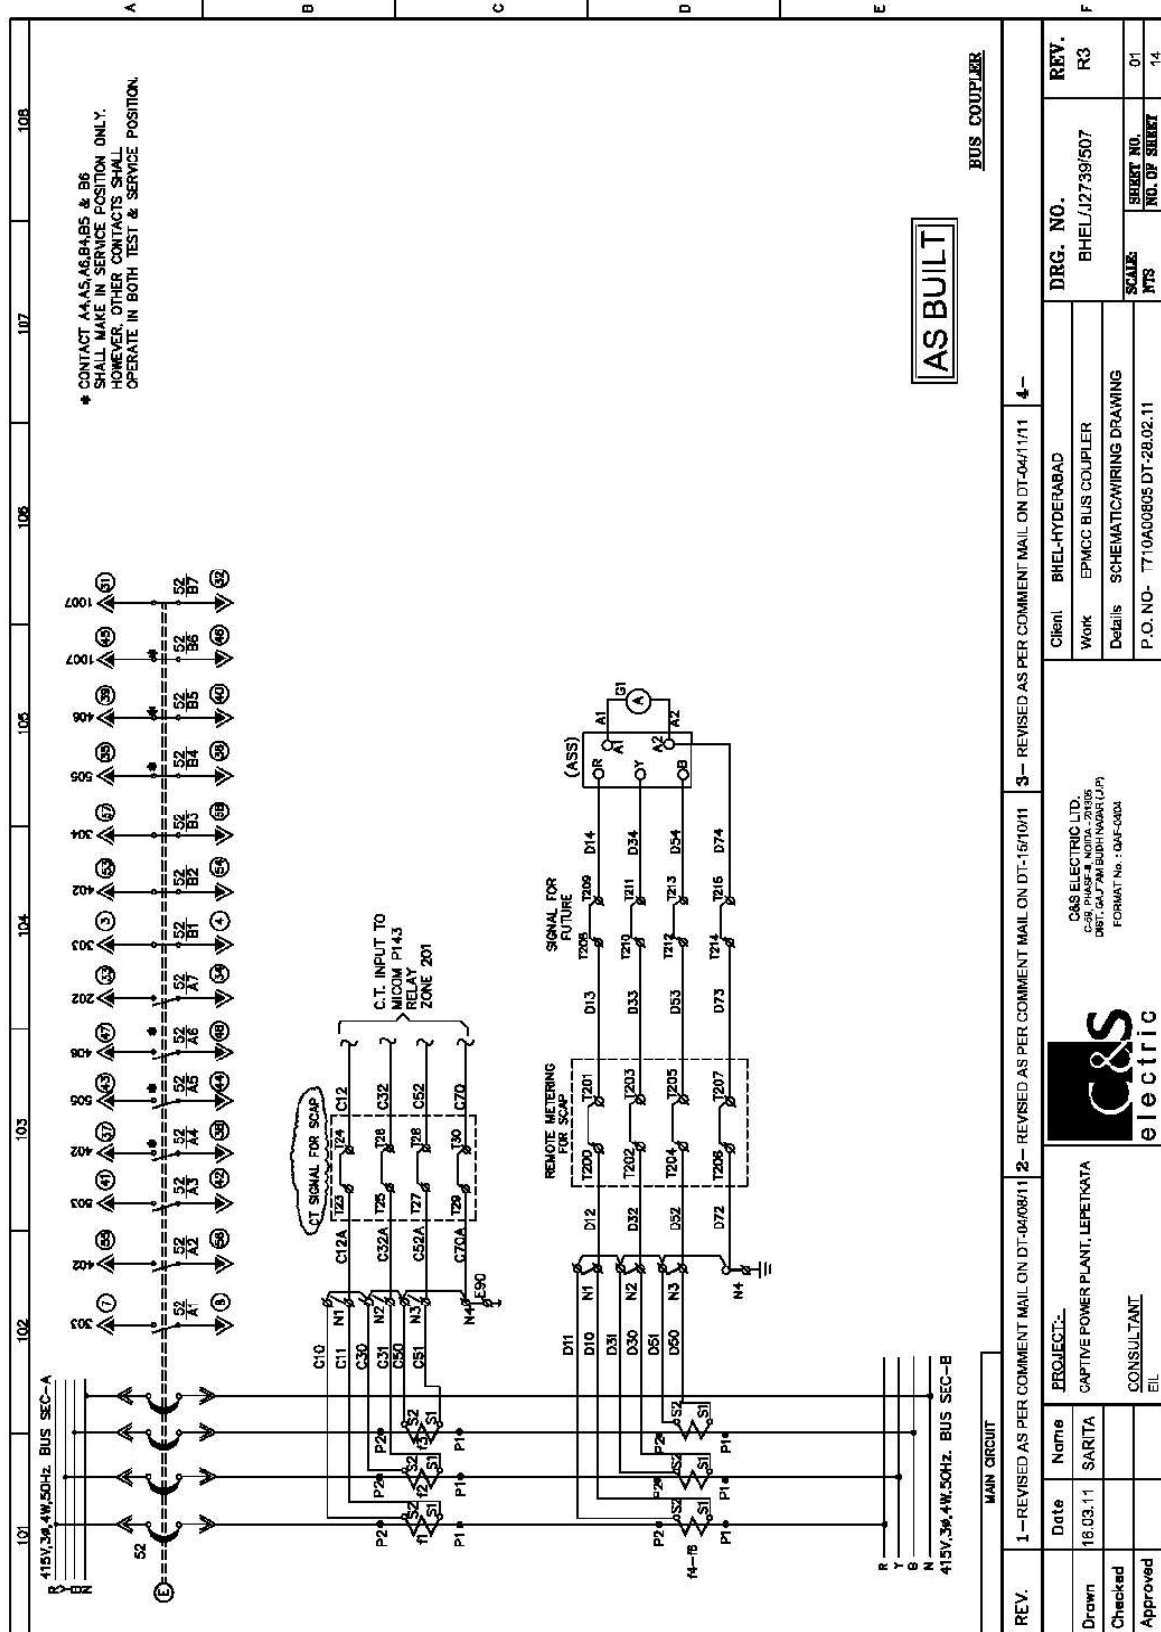

The contents of this Drawing are the sole property of C&S ELECTRIC LTD. and they should neither be copied nor given to a third person without the prior permission of Company.


PRODUCED BY AN AUTODESK EDUCATIONAL PRODUCT

PRODUCED BY AN AUTODESK EDUCATIONAL PRODUCT




PRODUCED BY AN AUTODESK EDUCATIONAL PRODUCT

The contents of this Drawing are the sole property of C&S ELECTRIC LTD.
and they should neither be copied nor given to a third person without the prior permission of Company

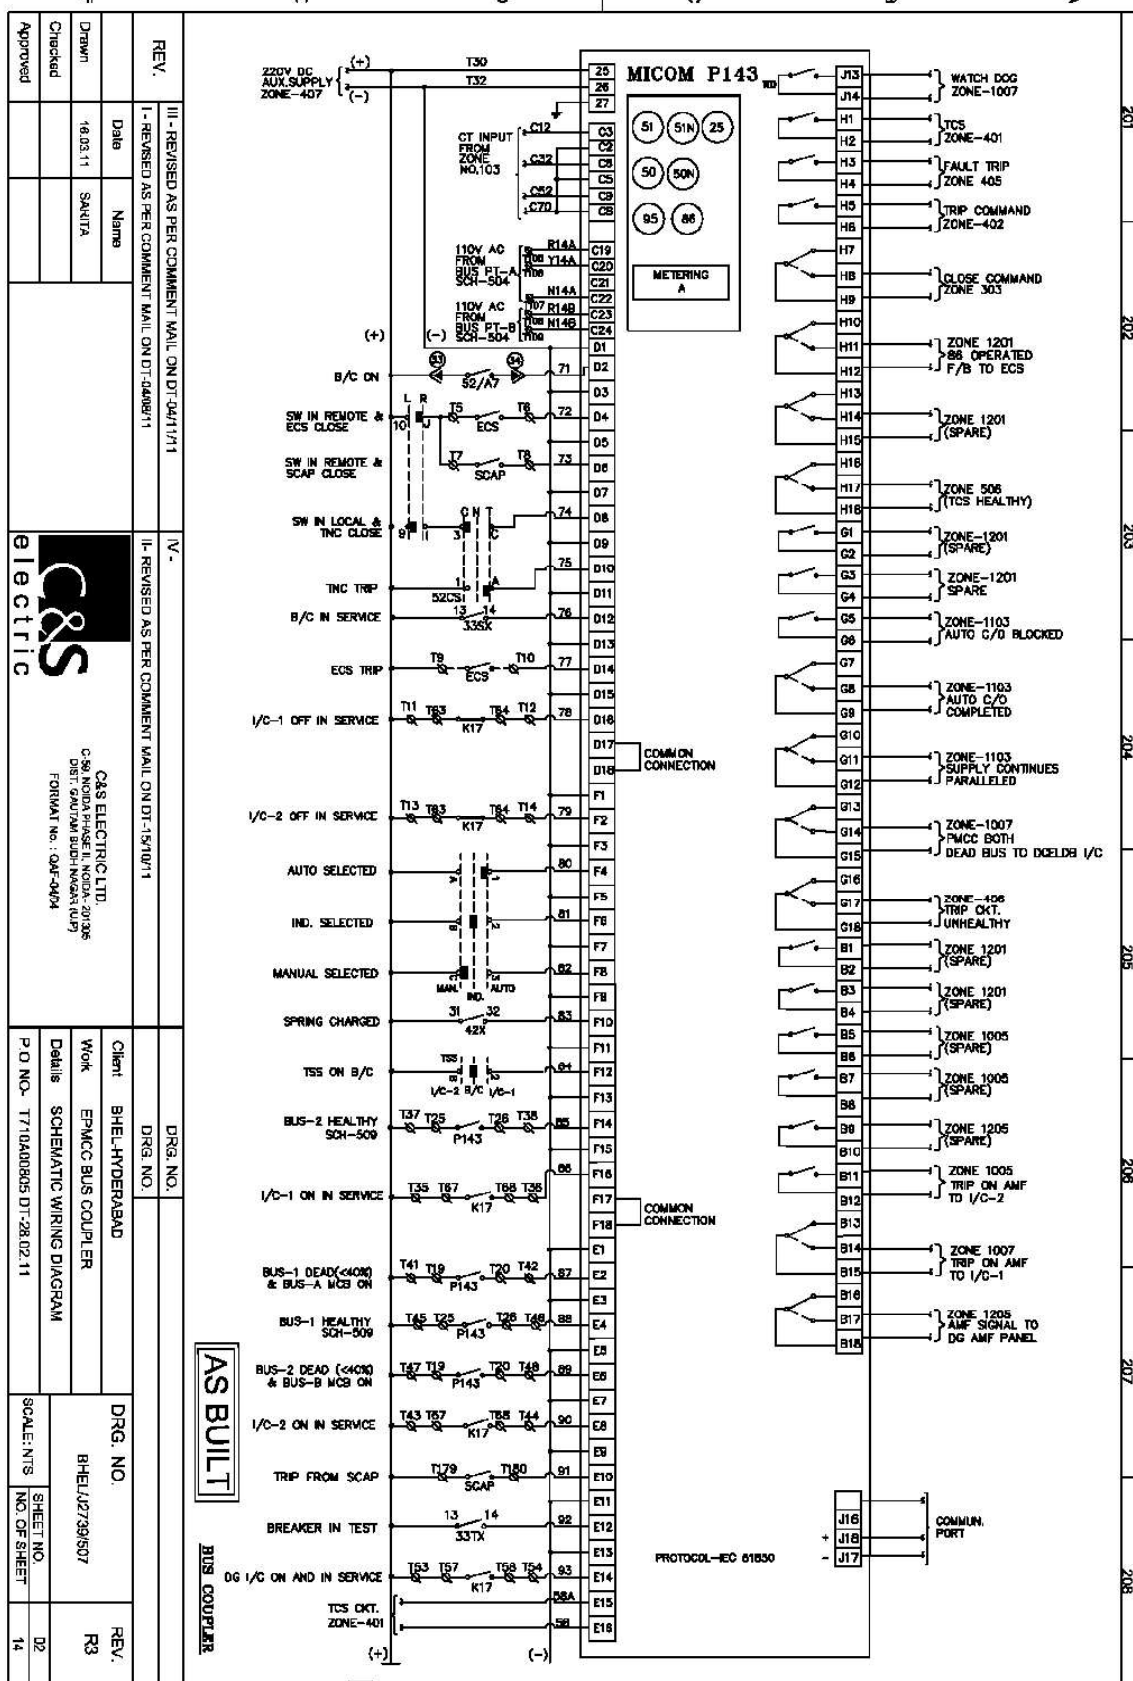


PRODUCED BY AN AUTODESK EDUCATIONAL PRODUCT

PRODUCED BY AN AUTODESK EDUCATIONAL PRODUCT

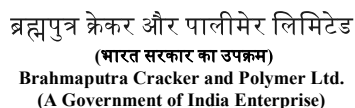


PRODUCED BY AN AUTODESK EDUCATIONAL PRODUCT

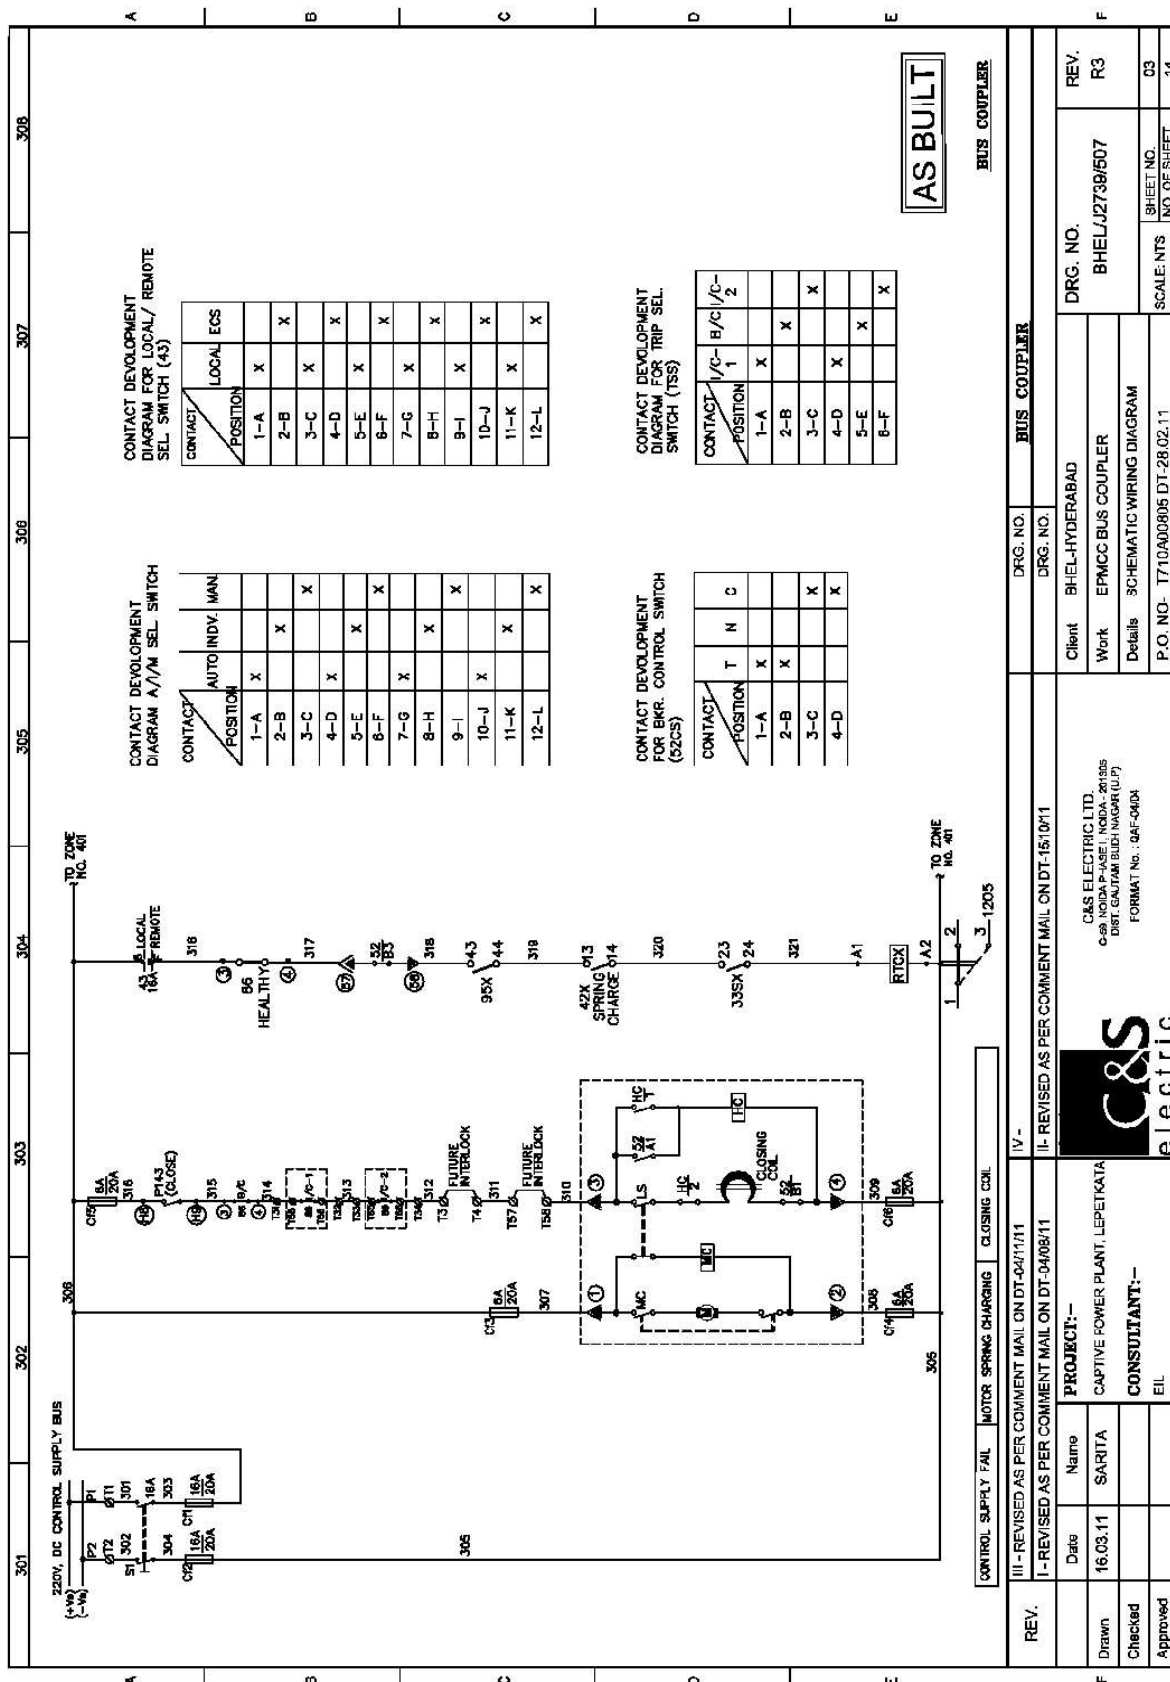


PRODUCED BY AN AUTODESK EDUCATIONAL PRODUCT

PRODUCED BY AN AUTODESK EDUCATIONAL PRODUCT

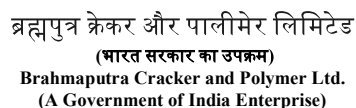

PRODUCED BY AN AUTODESK EDUCATIONAL PRODUCT

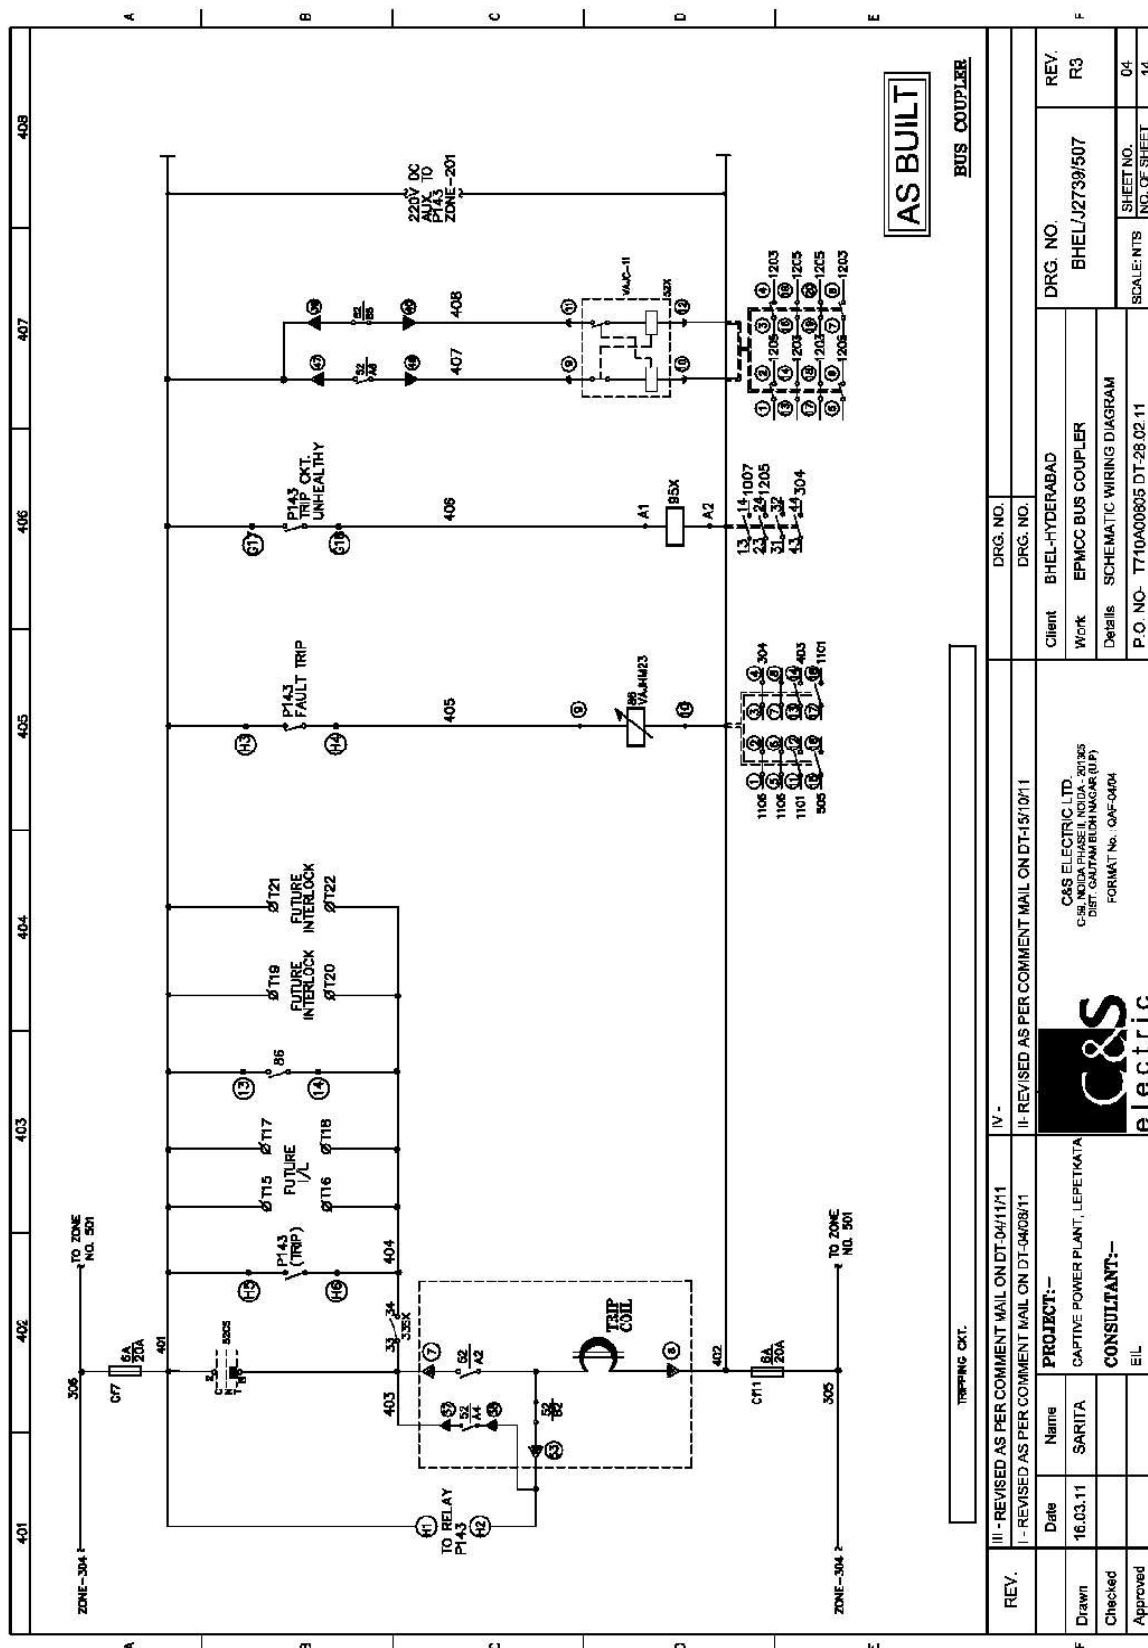

The contents of this Drawing are the sole property of CAS ELECTRIC LTD. and they should neither be copied nor given to a third person without the prior permission of Company


PRODUCED BY AN AUTODESK EDUCATIONAL PRODUCT

PRODUCED BY AN AUTODESK EDUCATIONAL PRODUCT



PRODUCED BY AN AUTODESK EDUCATIONAL PRODUCT


PRODUCED BY AN AUTODESK EDUCATIONAL PRODUCT

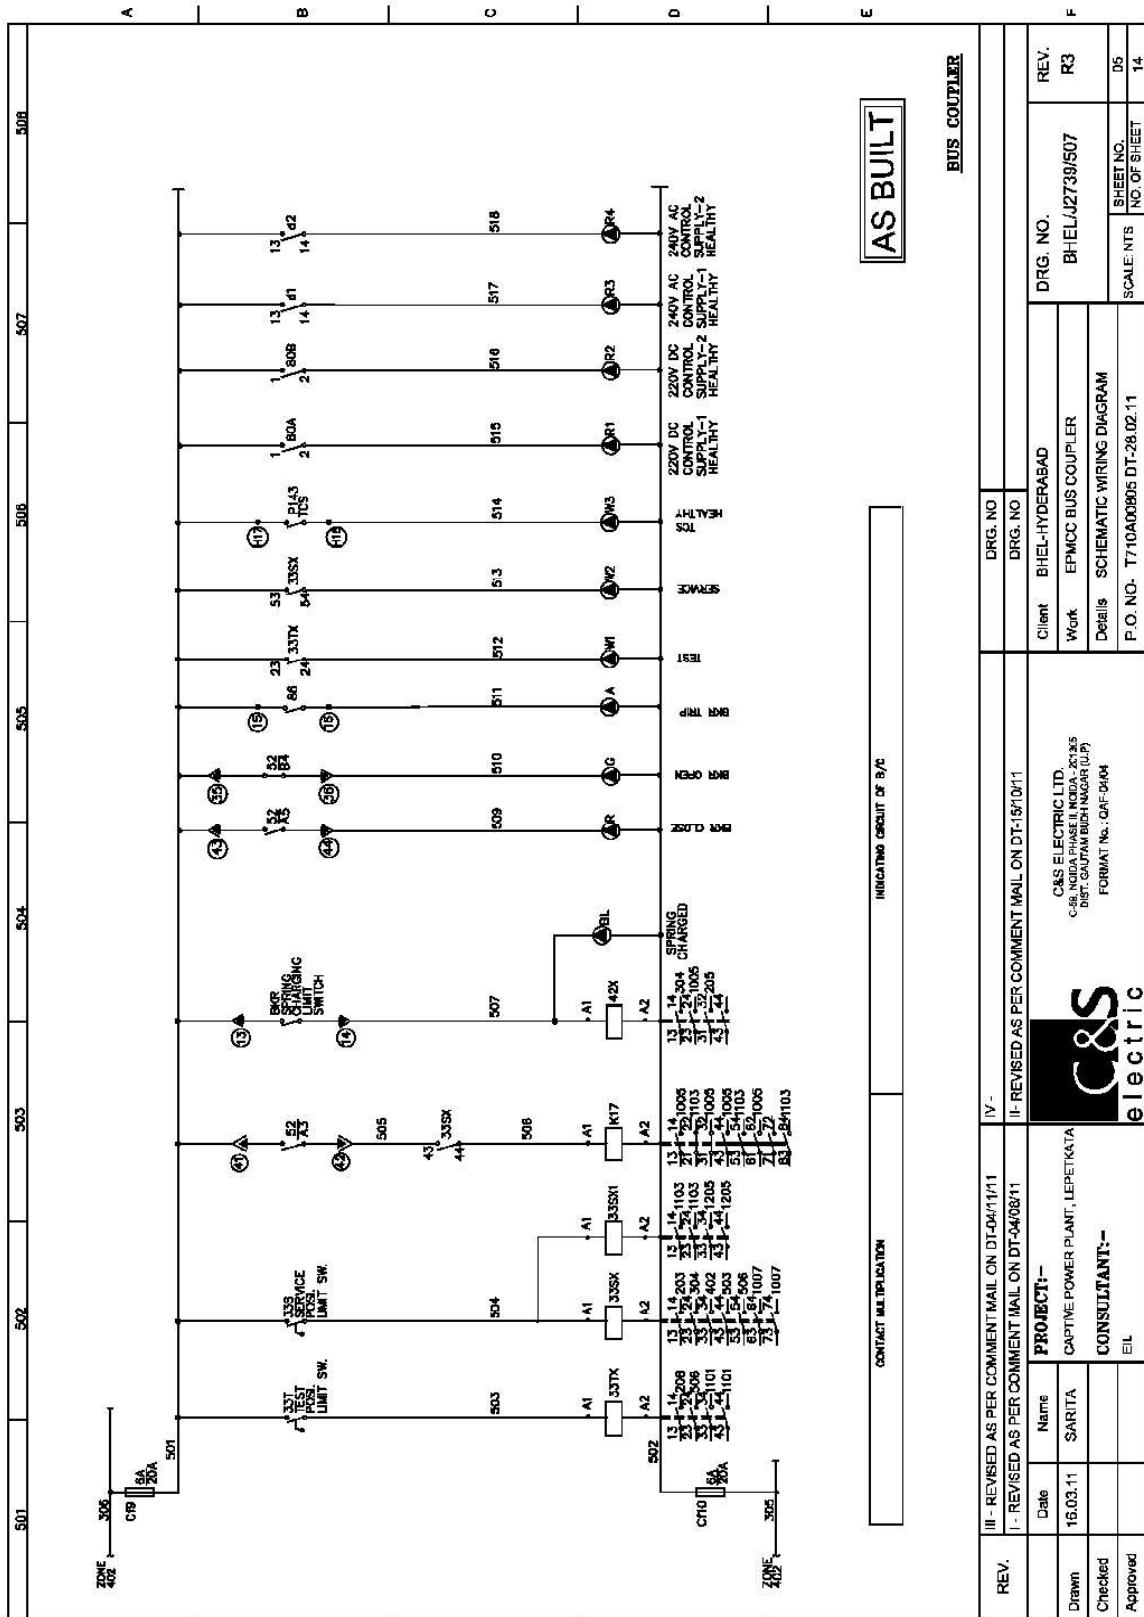


The contents of this Drawing are the sole property of C&S ELECTRIC LTD. and they should neither be copied nor given to a third person without the prior permission of Company

PRODUCED BY AN AUTODESK EDUCATIONAL PRODUCT

PRODUCED BY AN AUTODESK EDUCATIONAL PRODUCT

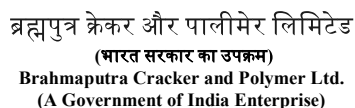

PRODUCED BY AN AUTODESK EDUCATIONAL PRODUCT

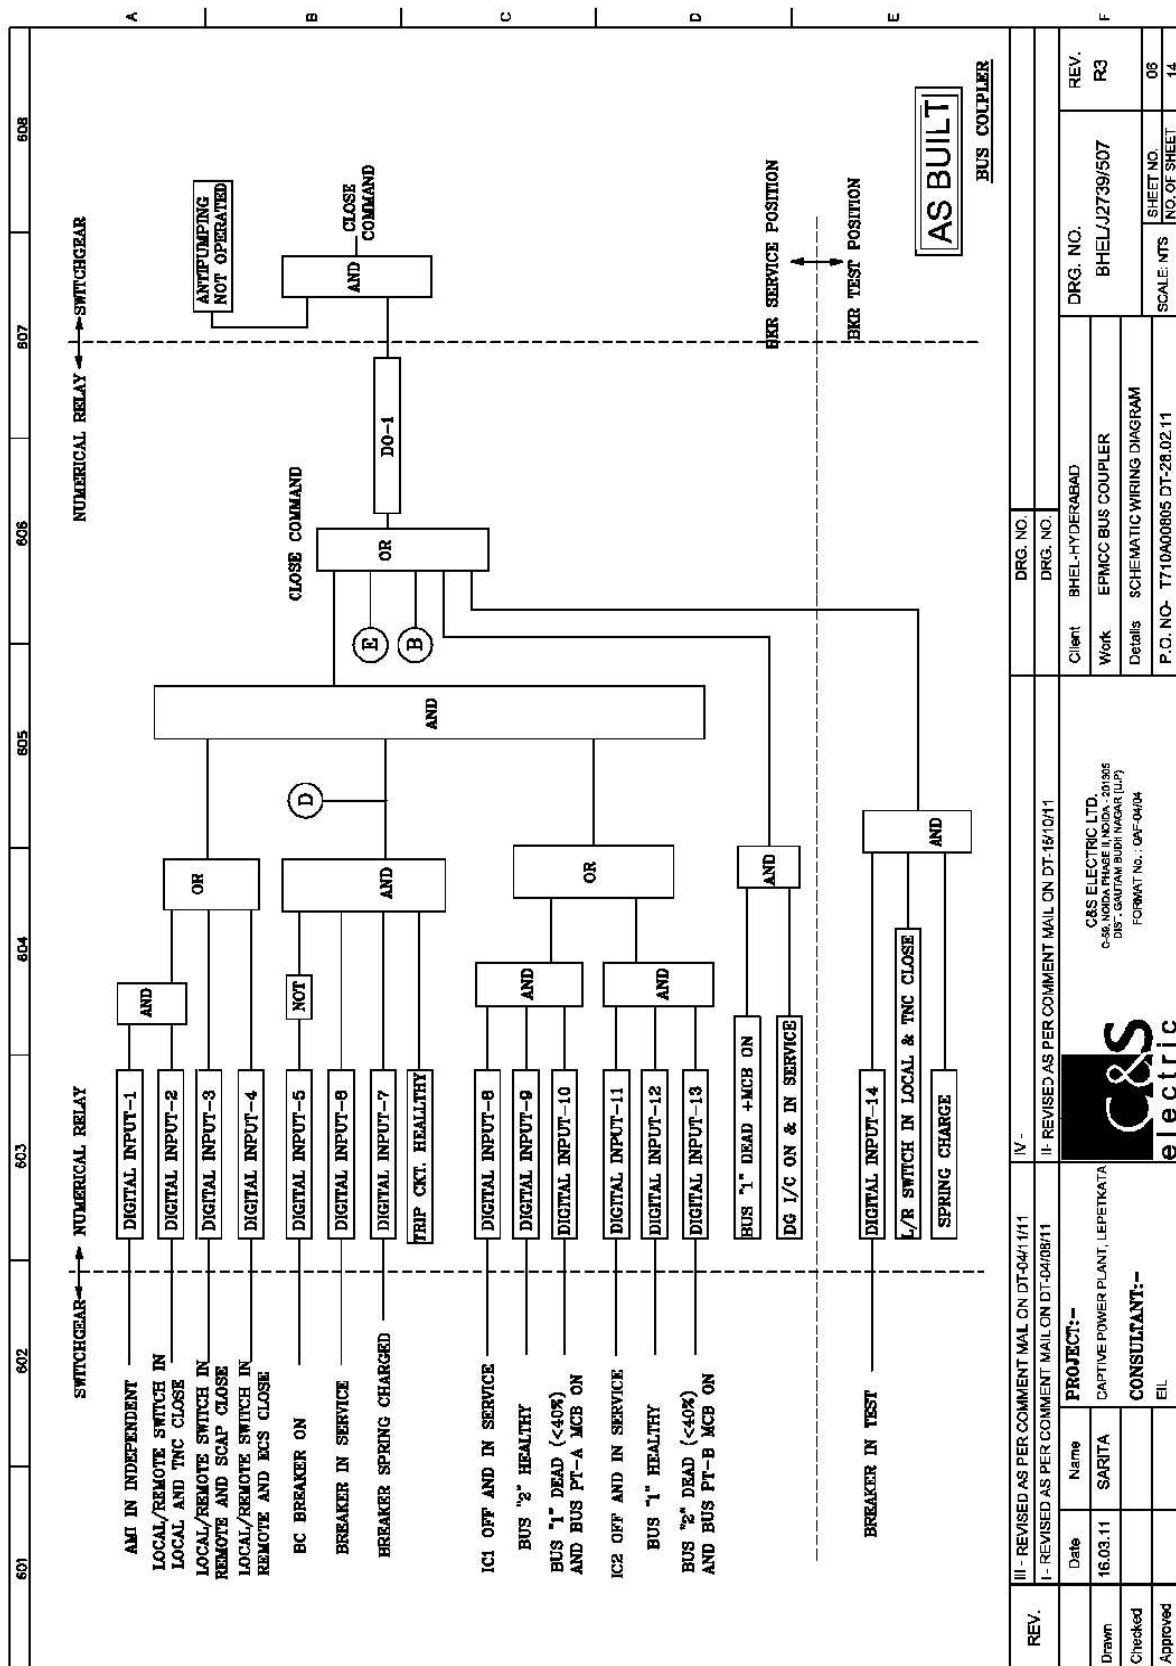


PRODUCED BY AN ADOBE SYSTEMS INC. PRODUCT

PRODUCED BY AN AUTODESK EDUCATIONAL PRODUCT



PRODUCED BY AN AUTODESK EDUCATIONAL PRODUCT


The contents of this Drawing are the sole property of C&S ELECTRIC LTD.
and they should neither be copied nor given to a third person without the prior permission of Company

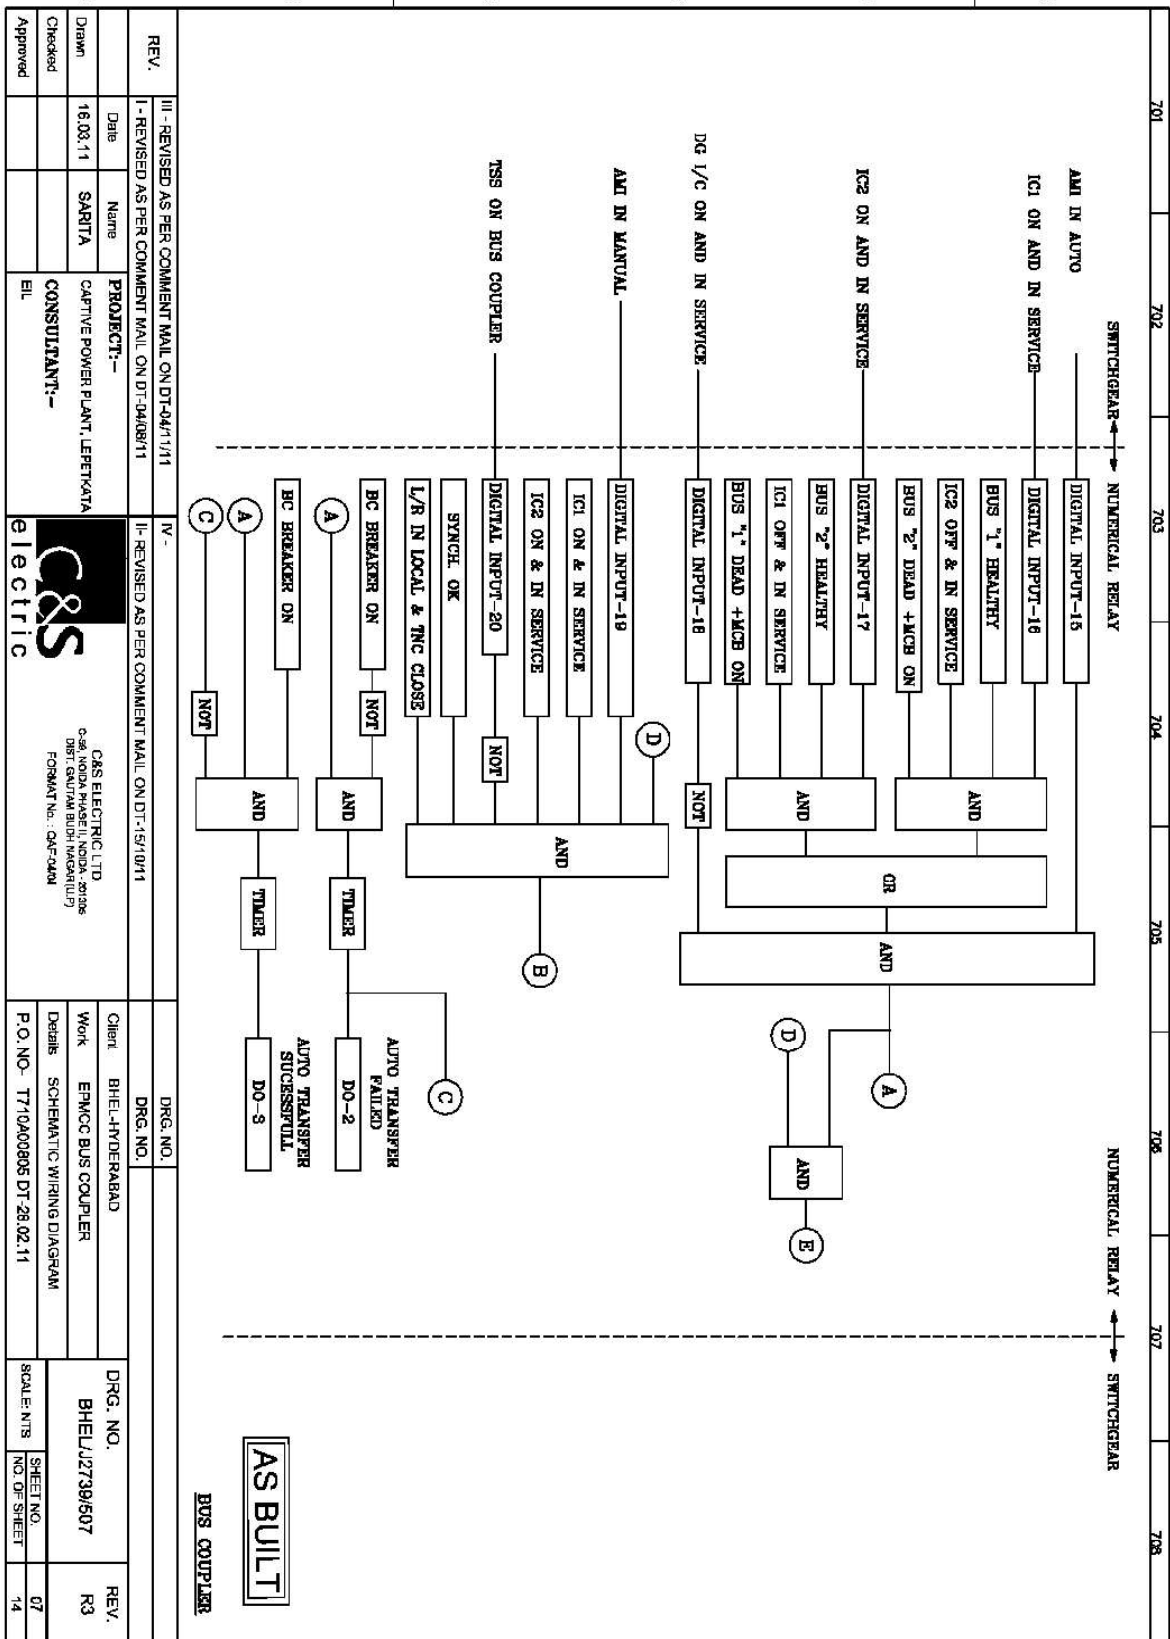


PRODUCED BY AN AUTODESK EDUCATIONAL PRODUCT

PRODUCED BY AN AUTODESK EDUCATIONAL PRODUCT

PRODUCED BY AN AUTODESK EDUCATIONAL PRODUCT

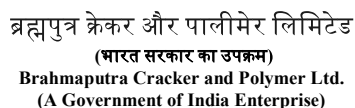

PRODUCED BY AN AUTODESK EDUCATIONAL PRODUCT

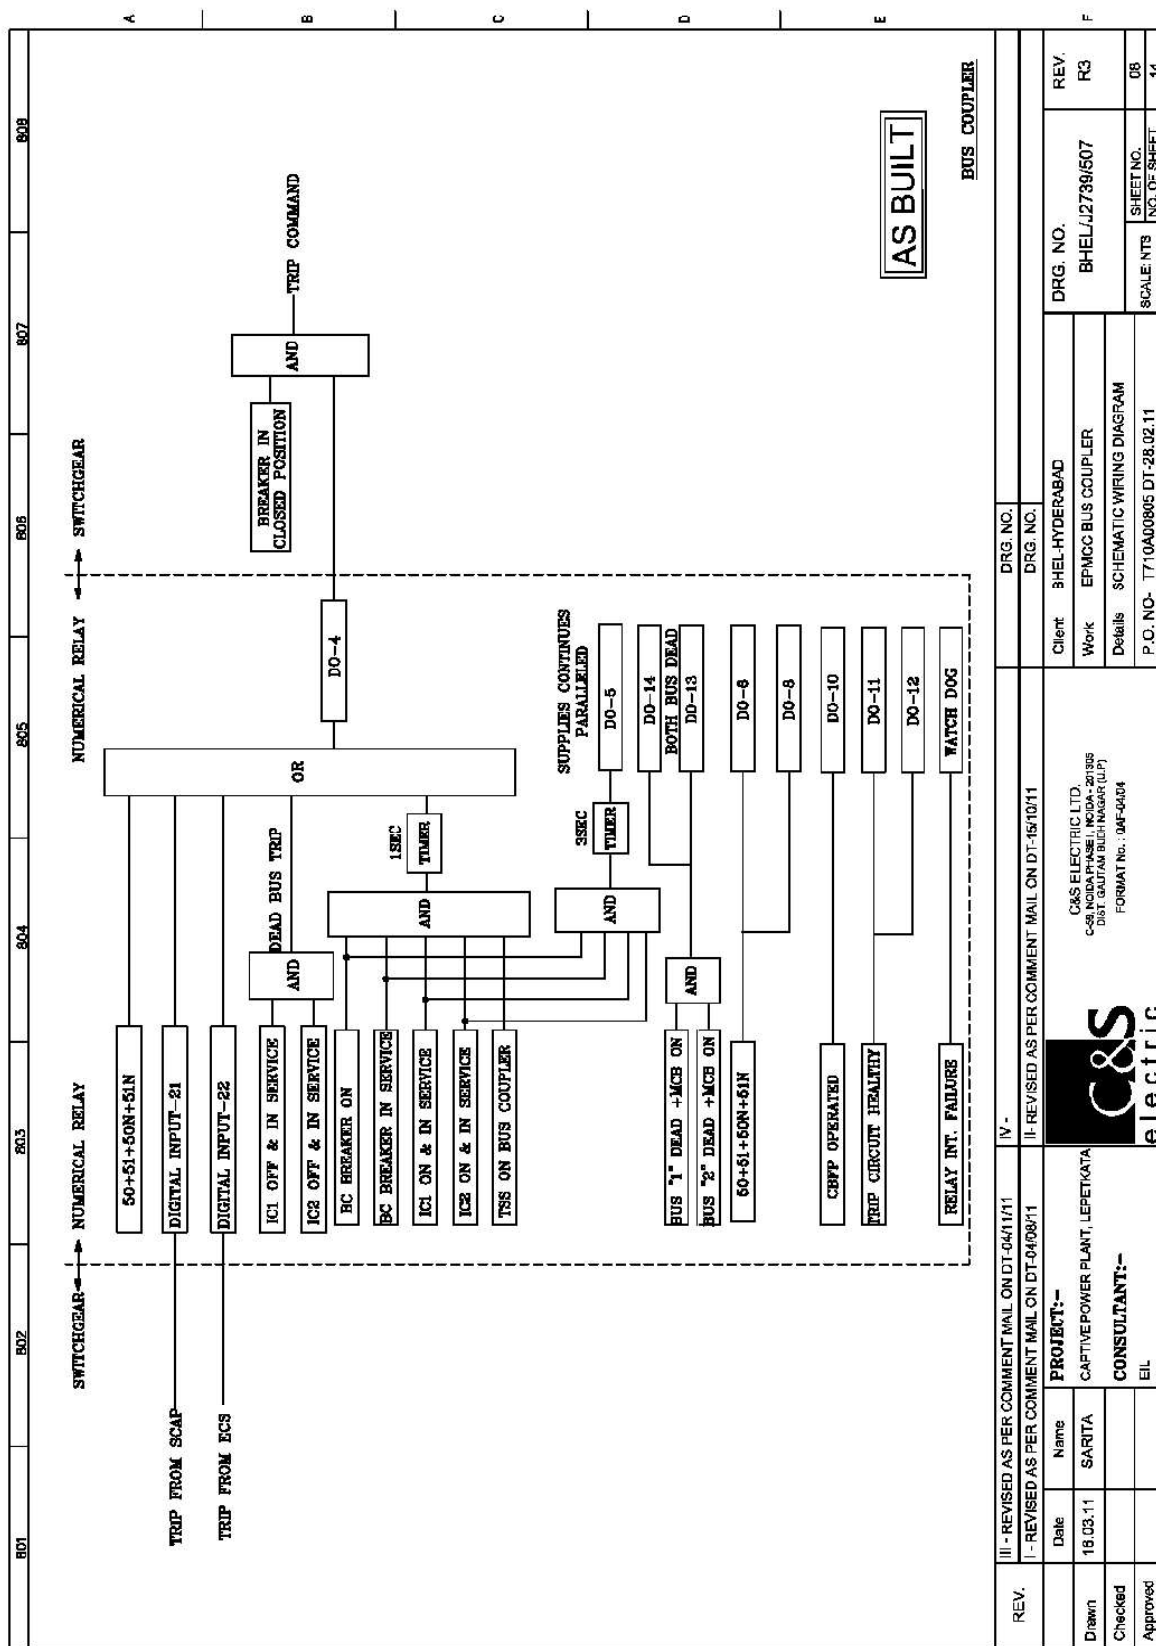

The contents of this Drawing are the sole property of C&S ELECTRIC LTD. and they should neither be copied nor given to a third person without the prior permission of Company.

PRODUCED BY AN AUTODESK EDUCATIONAL PRODUCT

PRODUCED BY AN AUTODESK EDUCATIONAL PRODUCT



PRODUCED BY AN AUTODESK EDUCATIONAL PRODUCT

PRODUCED BY AN AUTODESK EDUCATIONAL PRODUCT


901	902	903	904	905	907	908
PROTECTION FUNCTIONS						
SIGNALS WIRING TO DI OF RELAY						
AS BUILT						
BUS COUPLER						
REV. III - REVISED AS PER COMMENT MAIL ON DT-04/11/11						
REV. II - REVISED AS PER COMMENT MAIL ON DT-15/10/11						
REV. I - REVISED AS PER COMMENT MAIL ON DT-04/08/11						
PROJECT: - CAPTIVE POWER PLANT, LEPETKATA						
CONSULTANT: - EIL						
DATE: 16.03.11						
SARITA						
CHECKED: -						
APPROVED: -						
SCALE: NTS						
SHEET NO. 09						
NO. OF SHEET 14						
DRG. NO. BHEL/J2739/507						
REV. R3						
SCHEMATIC WIRING DIAGRAM						
P.O. NO. T710A00005 DT-28.02.11						
Client BHEL-HYDERABAD						
Work EPMCC BUS COUPLER						
Details SCHEMATIC WIRING DIAGRAM						
C&S ELECTRIC LTD.						
C-85, NODA PHASE I NODA - 20136						
DIST. GAUTAM BUDDH NAGAR (UP)						
FORMAT No : DAF-0404						

PRODUCED BY AN AUTODESK EDUCATIONAL PRODUCT

PRODUCED BY AN AUTODESK EDUCATIONAL PRODUCT


PRODUCED BY AN AUTODESK EDUCATIONAL PRODUCT

PRODUCED BY AN AUTODESK EDUCATIONAL PRODUCT

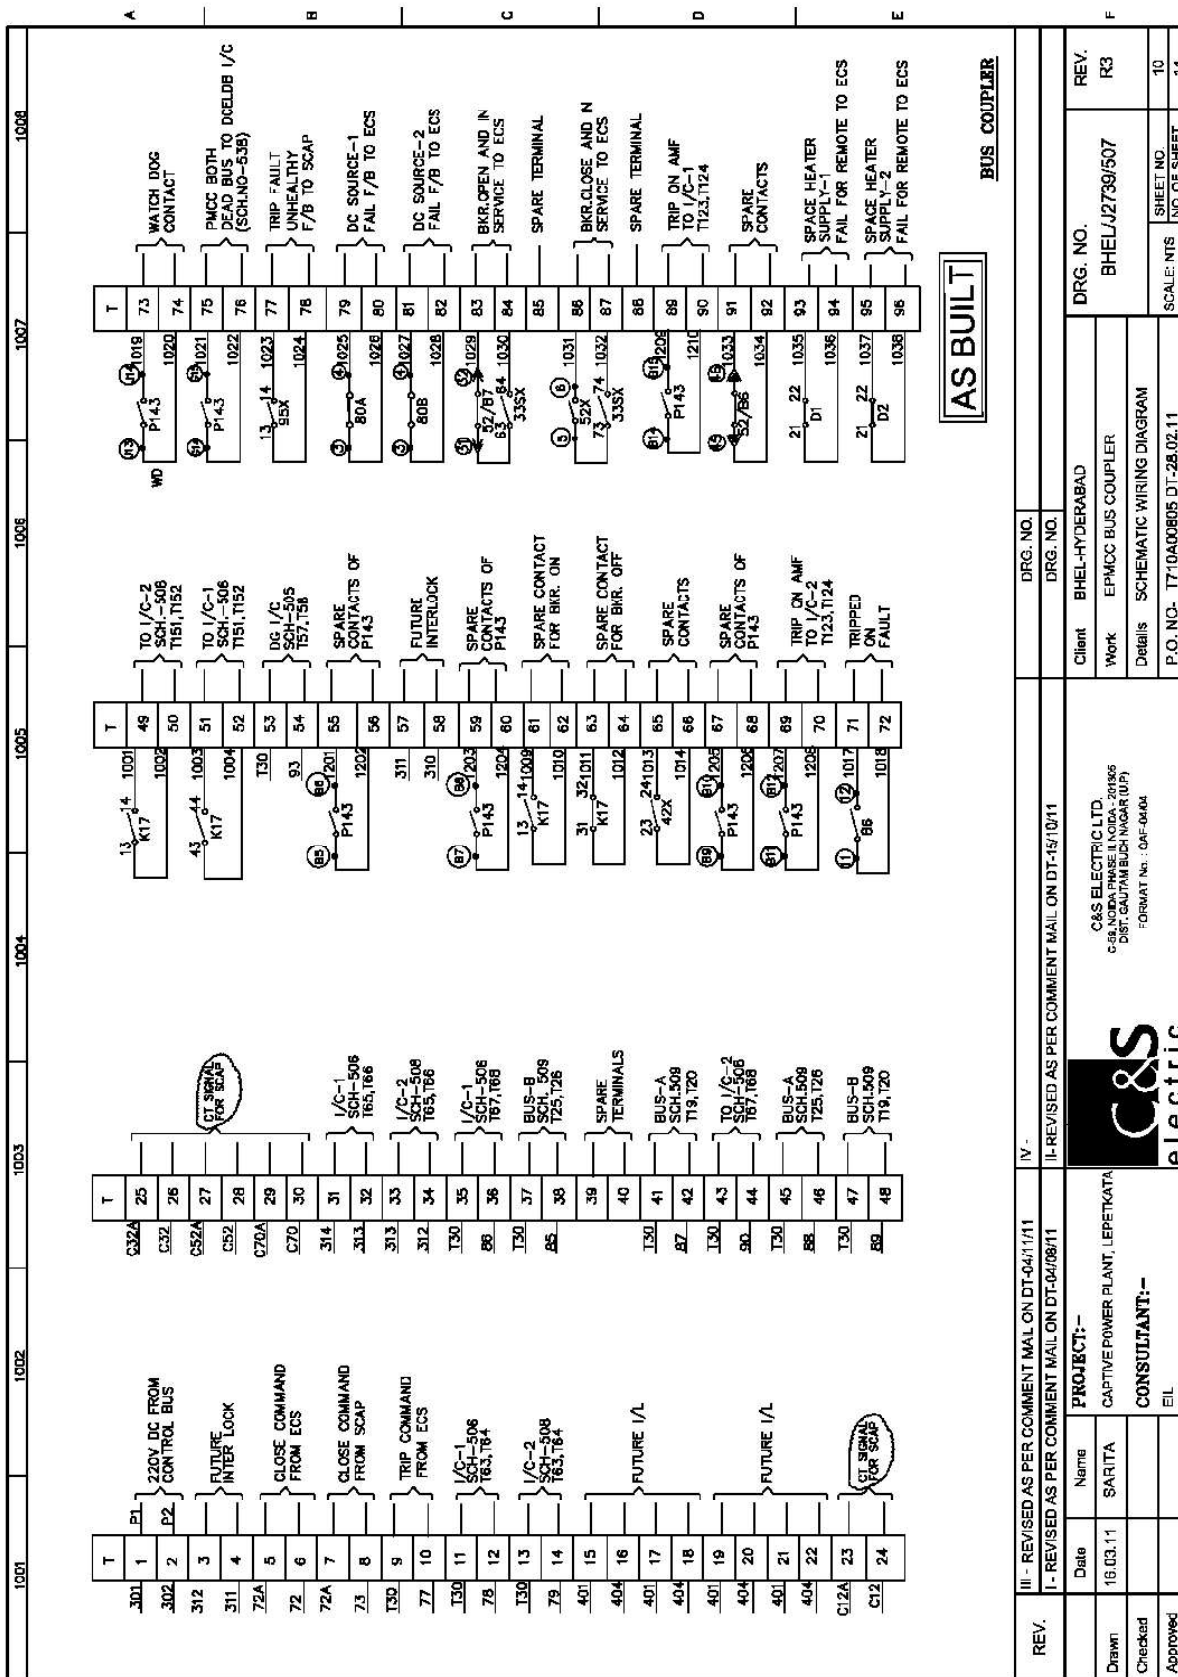


PRODUCED BY AN AUTODESK EDUCATIONAL PRODUCT

PRODUCED BY AN AUTODESK EDUCATIONAL PRODUCT

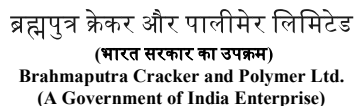

PRODUCED BY AN AUTODESK EDUCATIONAL PRODUCT

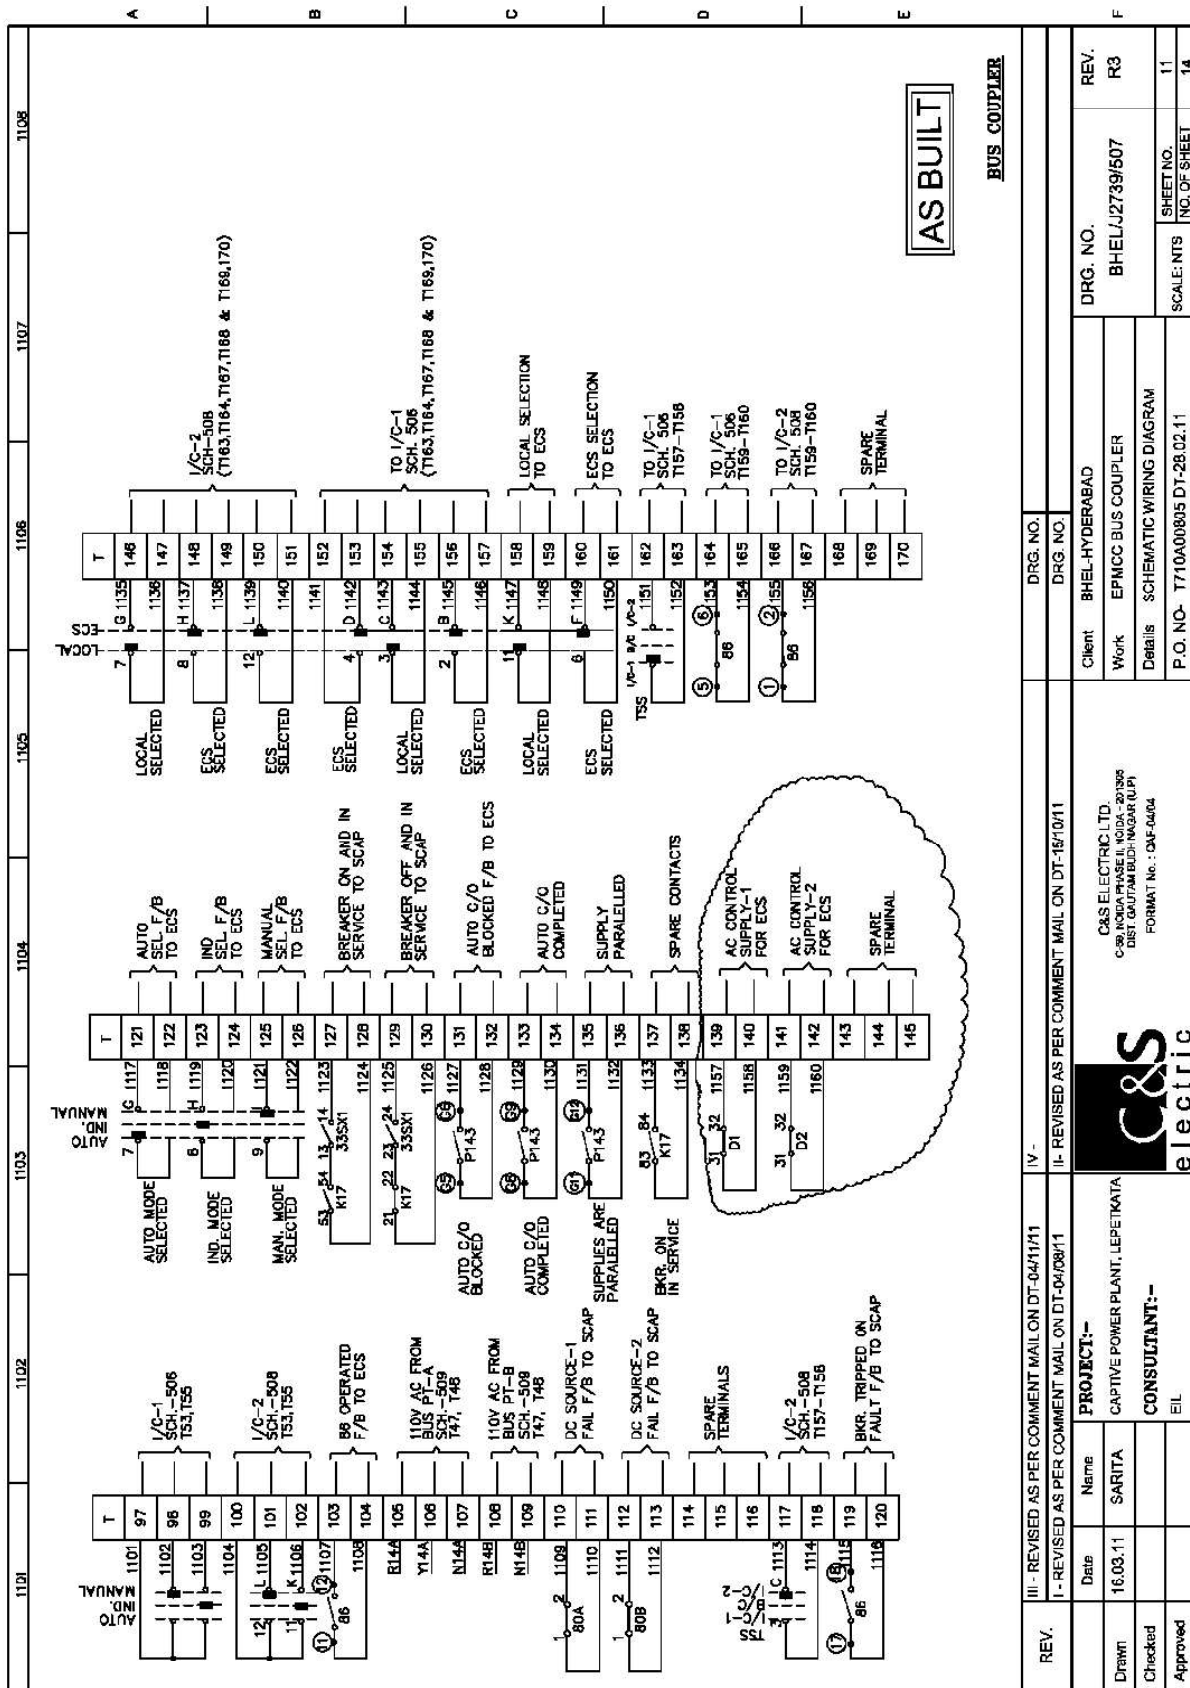


PRODUCED BY AN AUTODESK EDUCATIONAL PRODUCT




PRODUCED BY AN AUTODESK EDUCATIONAL PRODUCT

PRODUCED BY AN AUTODESK EDUCATIONAL PRODUCT

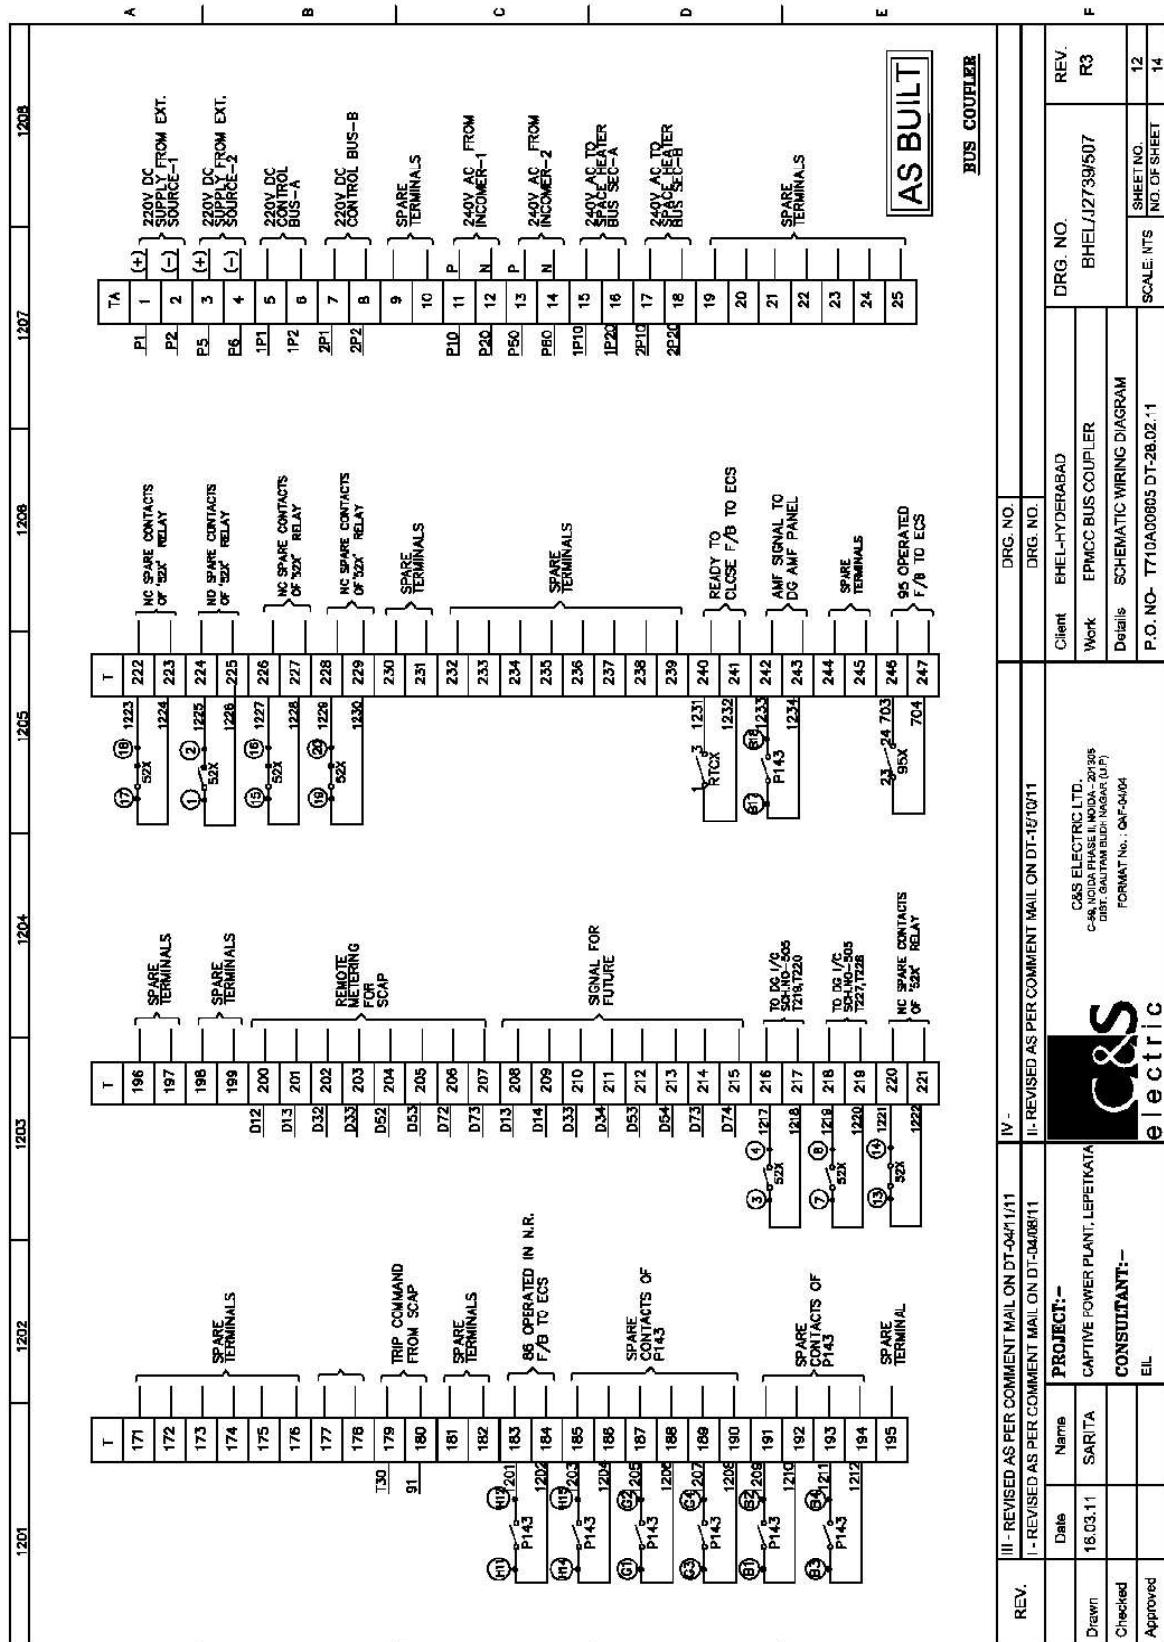


PRODUCED BY AN AUTODESK EDUCATIONAL PRODUCT

PRODUCED BY AN AUTODESK EDUCATIONAL PRODUCT

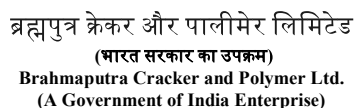

PRODUCED BY AN AUTODESK EDUCATIONAL PRODUCT

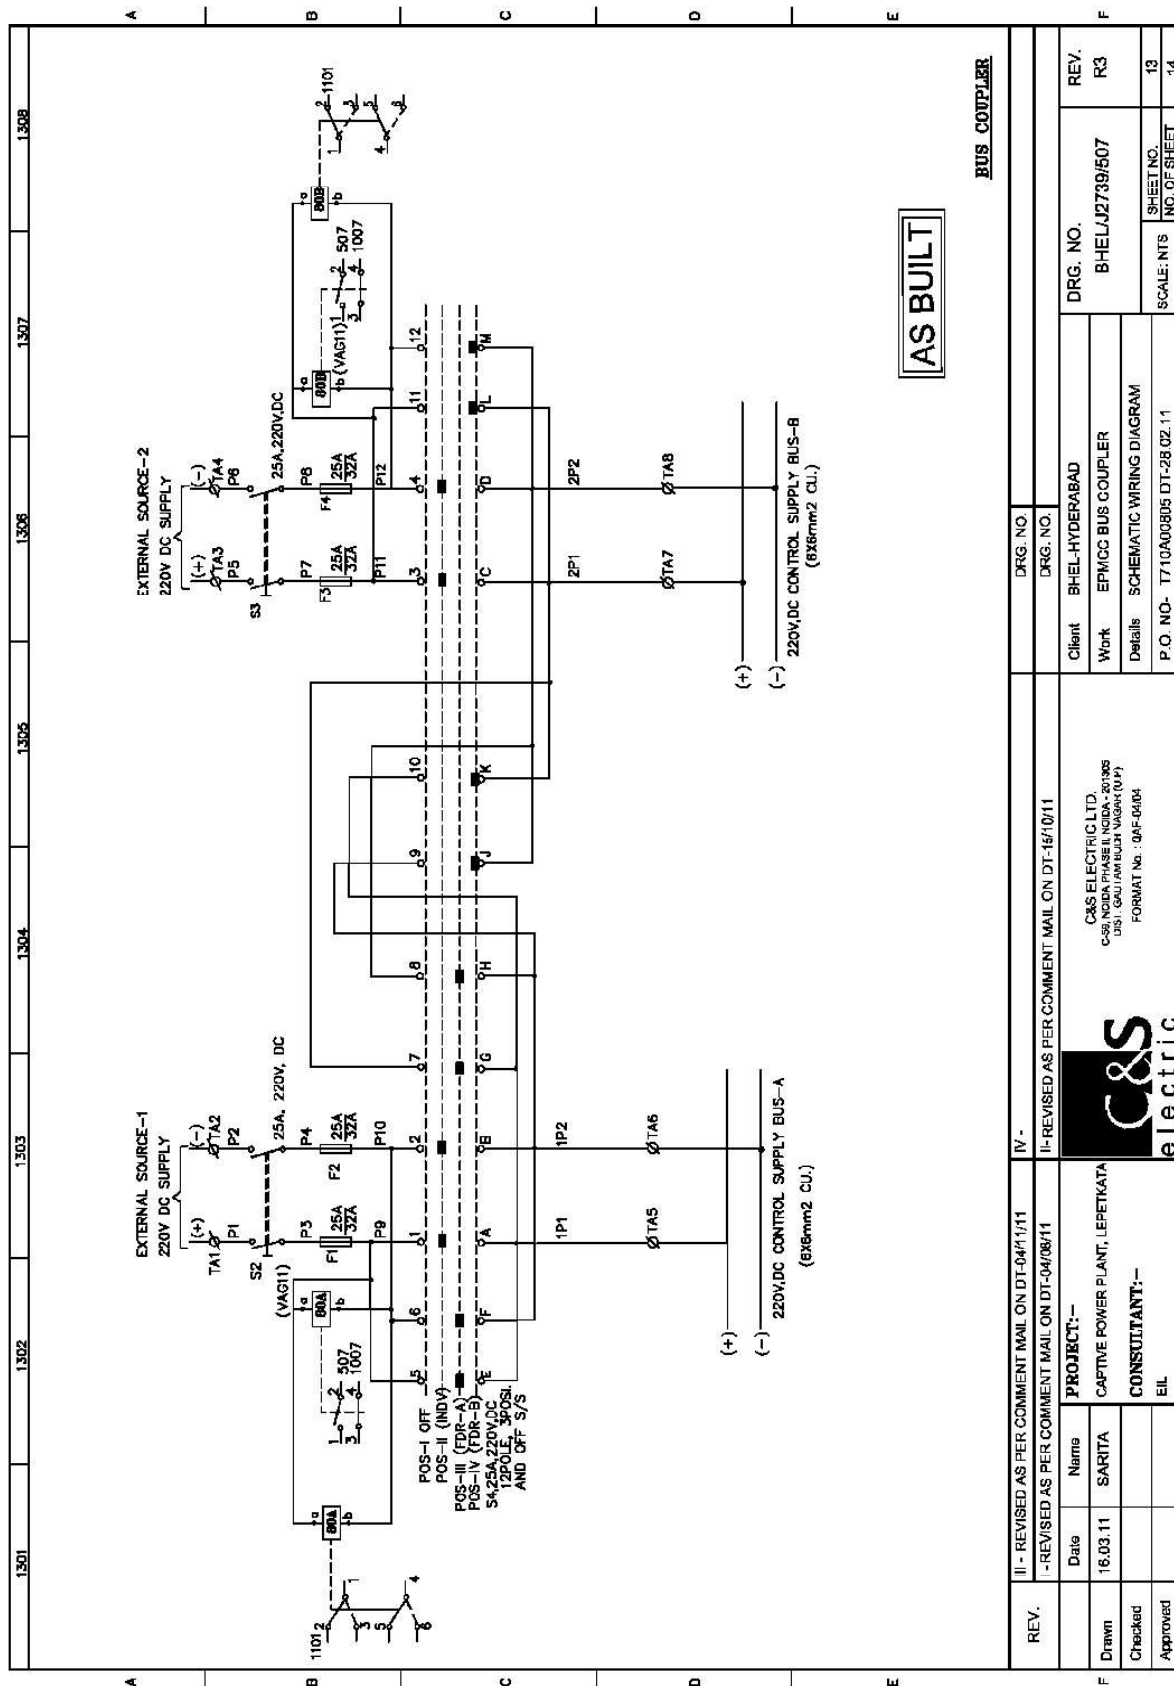


PRODUCED BY AN AUTODESK EDUCATIONAL PRODUCT

PRODUCED BY AN AUTODESK EDUCATIONAL PRODUCT



PRODUCED BY AN AUTODESK EDUCATIONAL PRODUCT

PRODUCED BY AN AUTODESK EDUCATIONAL PRODUCT

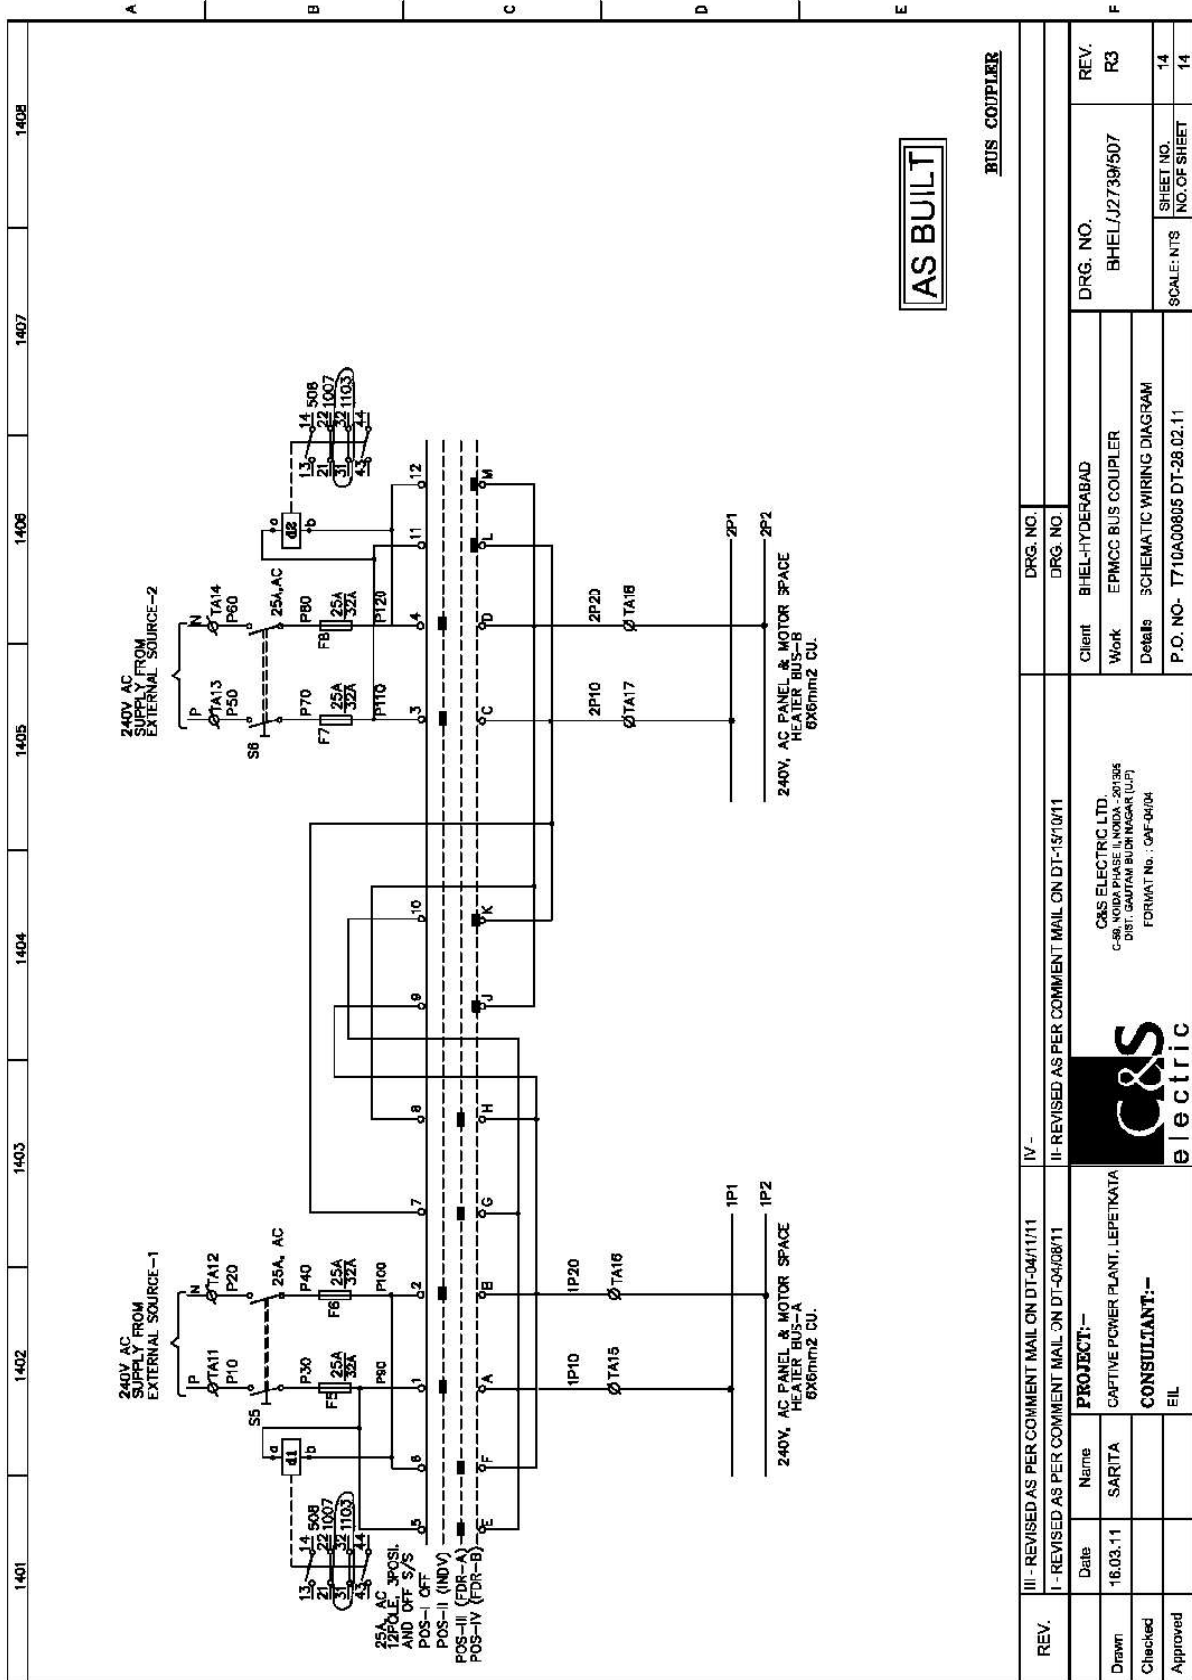

The contents of this Drawing are the sole property of C&S ELECTRIC LTD. and they should neither be copied nor given to a third person without the prior permission of Company

PRODUCED BY AN AUTODESK EDUCATIONAL PRODUCT

PRODUCED BY AN AUTODESK EDUCATIONAL PRODUCT