





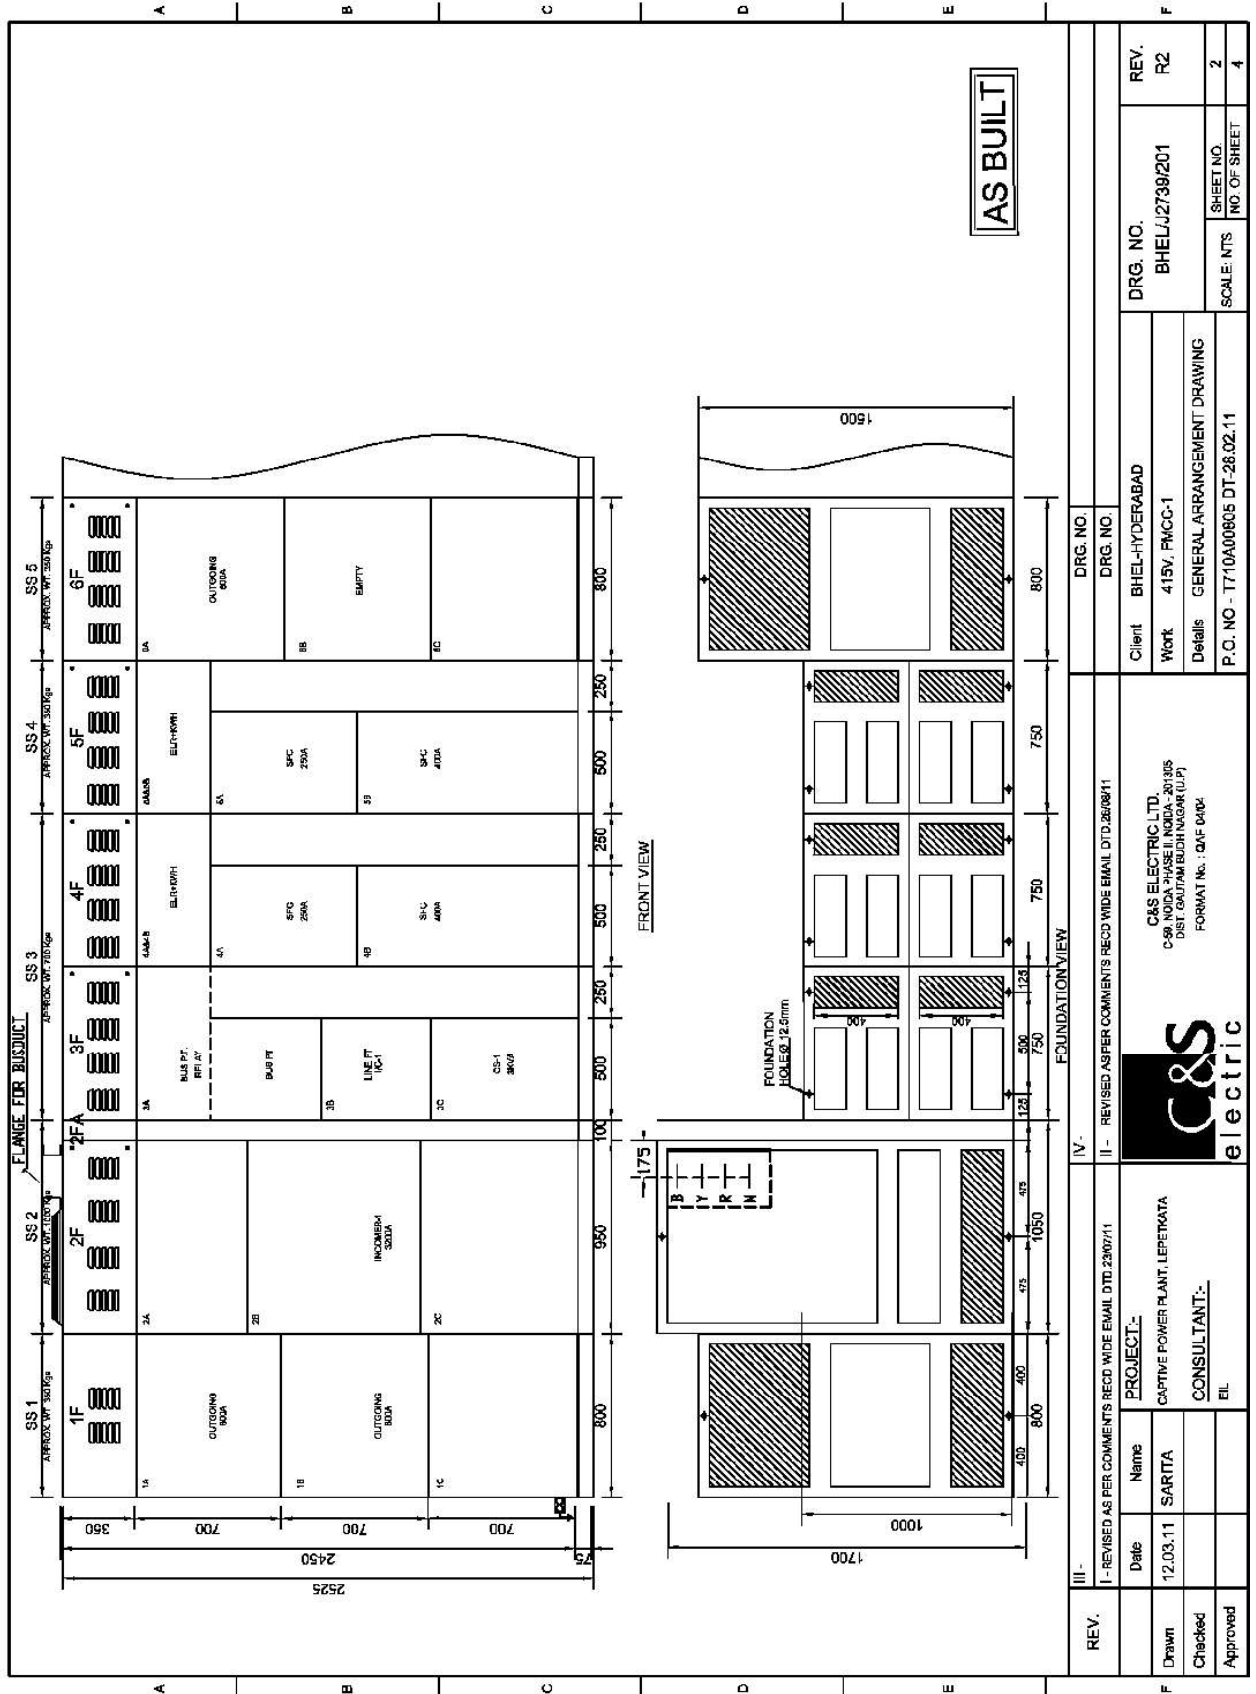




DRAWINGS RELATED TO PMCC
(INCOMING-1 & INCOMING-2 HAVE THE SAME SCHEMATIC)


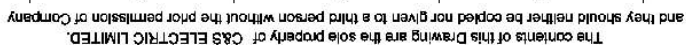


The contents of this Drawing are the sole property of C&S ELECTRIC LIMITED, and they should neither be copied nor given to a third person without the prior permission of Company.

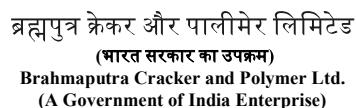

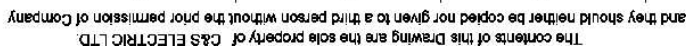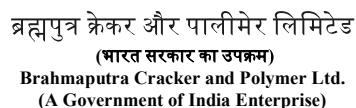


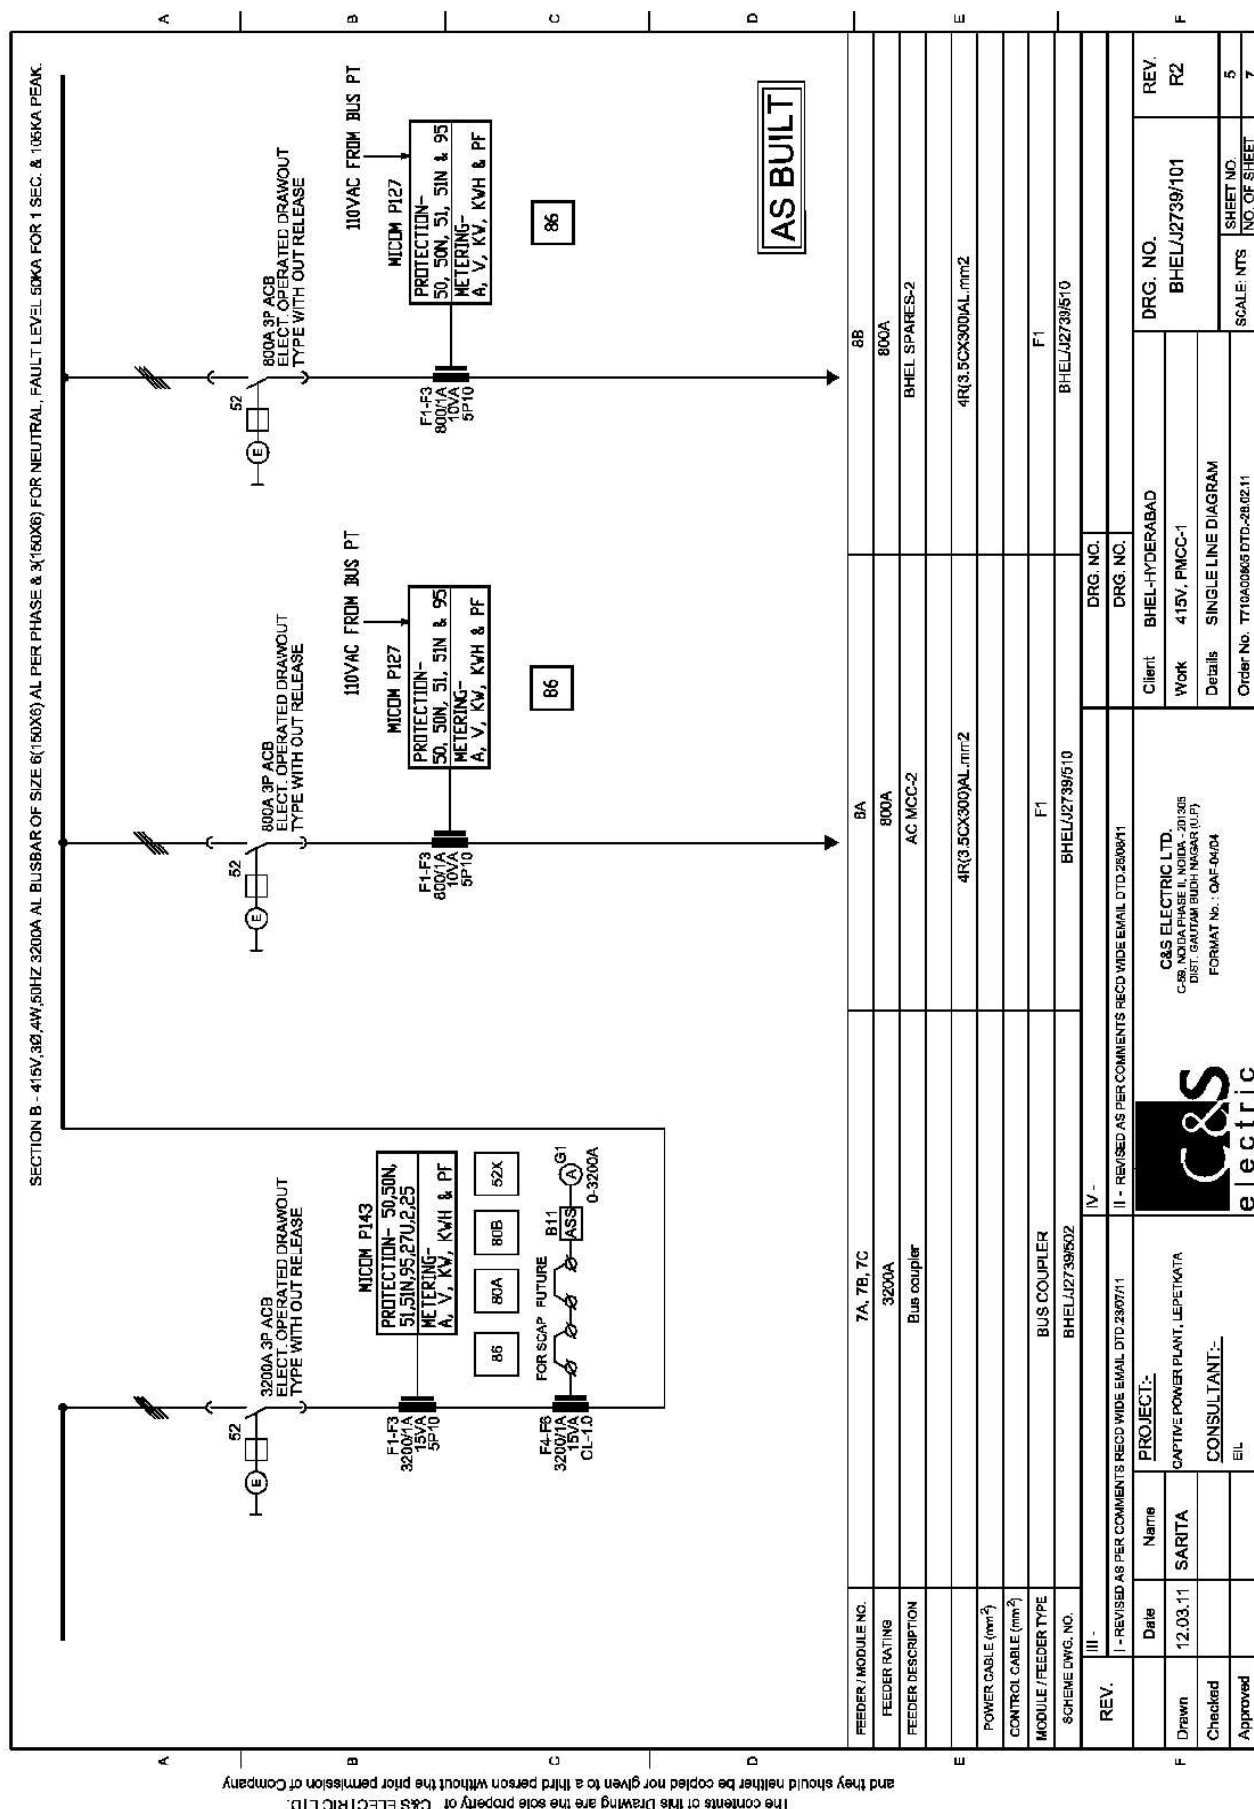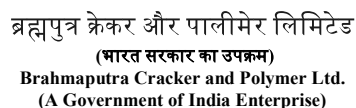

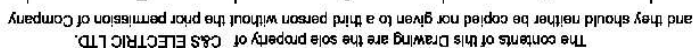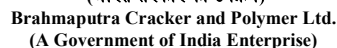




ब्रह्मपुत्र क्रेकर और पालीमेर लिमिटेड
(भारत सरकार का उपक्रम)
Brahmaputra Cracker and Polymer Ltd.
(A Government of India Enterprise)

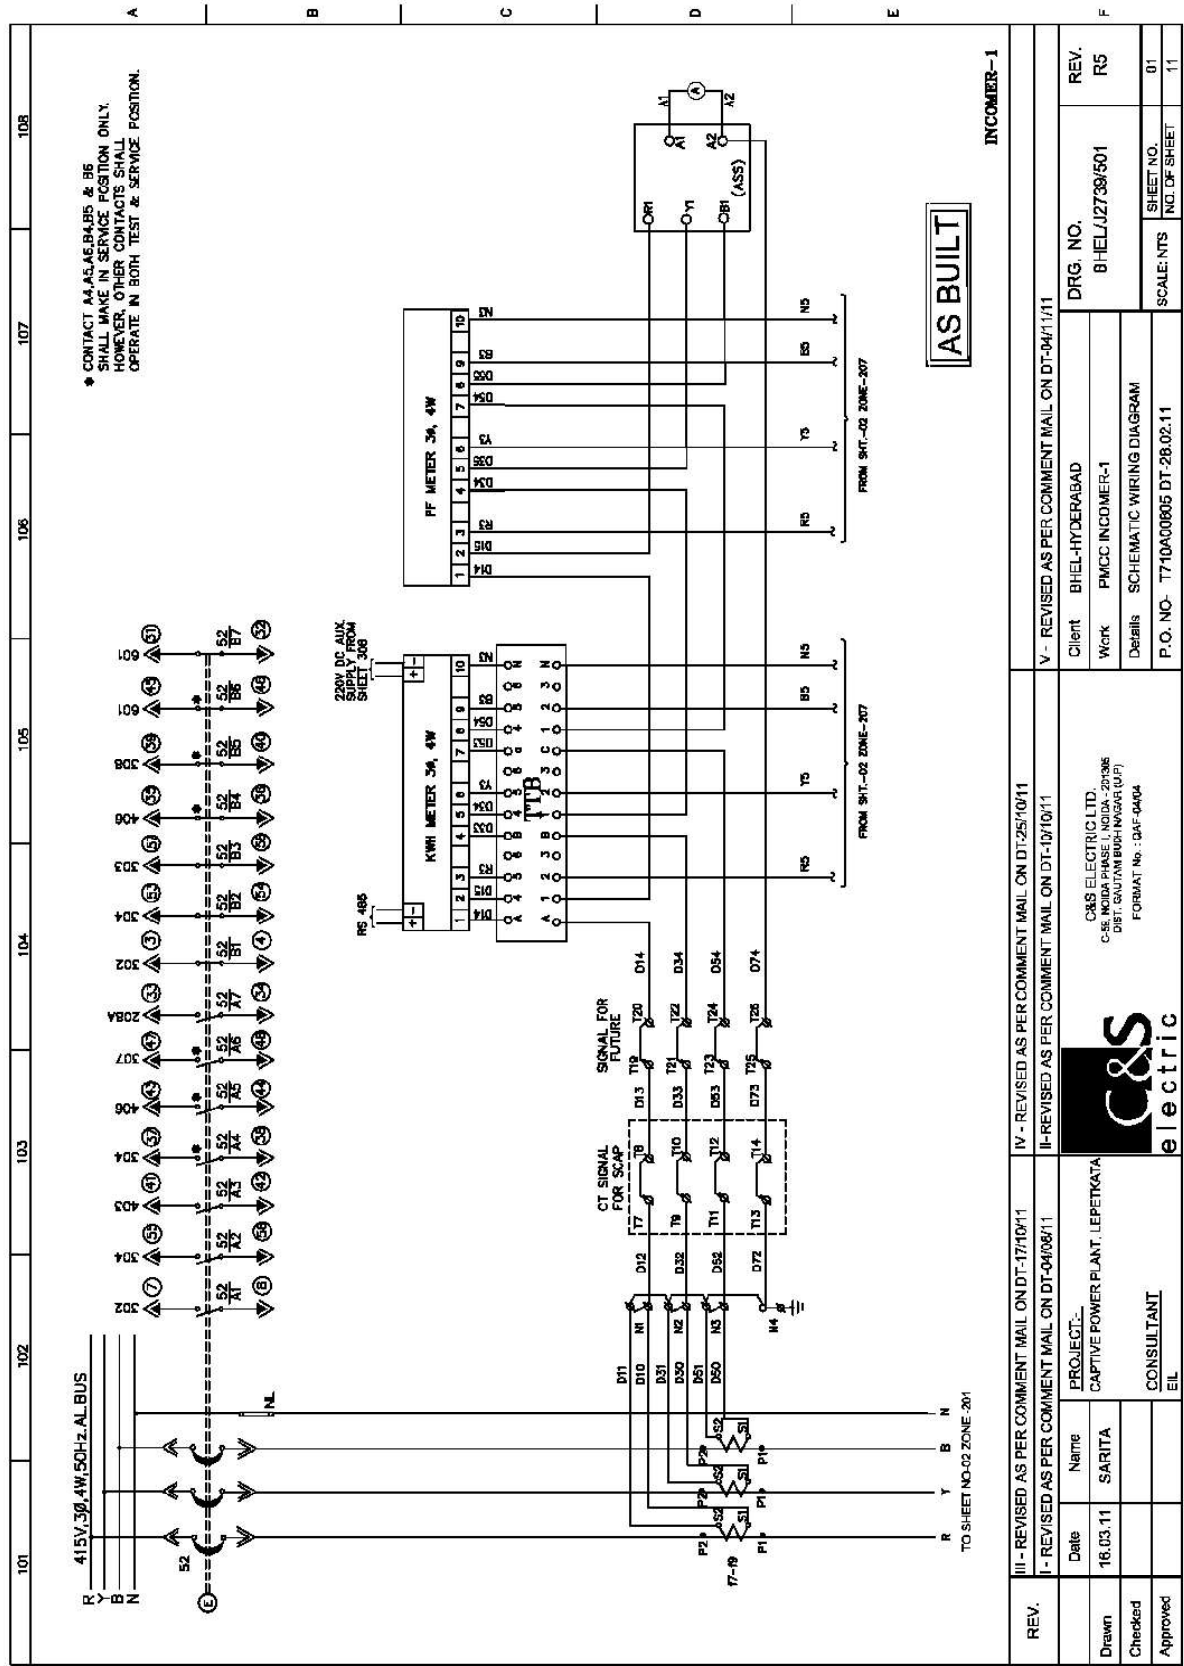

The contents of this Drawing are the sole property of C&S ELECTRIC LTD. and they should neither be copied nor given to a third person without the prior permission of Company.



ब्रह्मपुत्र क्रैकर और पालीमेर लिमिटेड
(भारत सरकार का उपक्रम)
Brahmaputra Cracker and Polymer Ltd.
(A Government of India Enterprise)

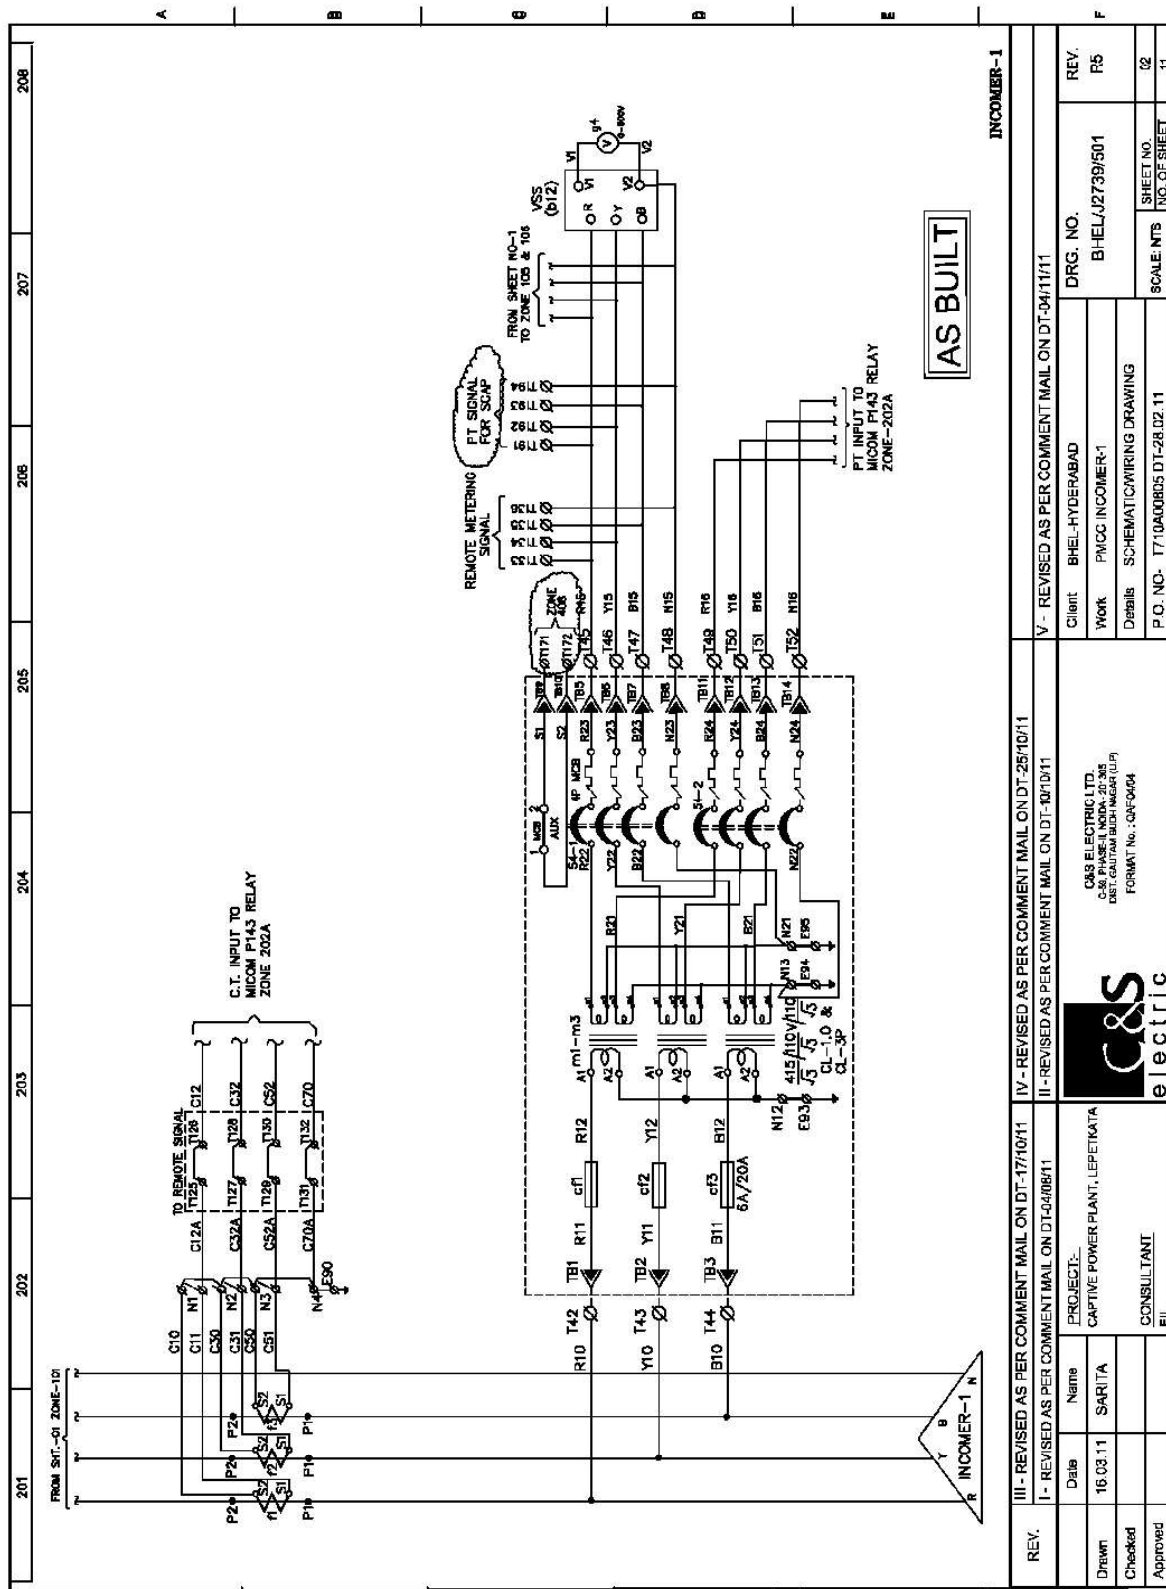







ब्रह्मपुत्र क्रेकर और पालीमेर लिमिटेड
(भारत सरकार का उपक्रम)
Brahmaputra Cracker and Polymer Ltd.
(A Government of India Enterprise)


The contents of this Drawing are the sole property of C&S ELECTRIC LTD.
and they should neither be copied nor given to a third person without the prior permission of Company

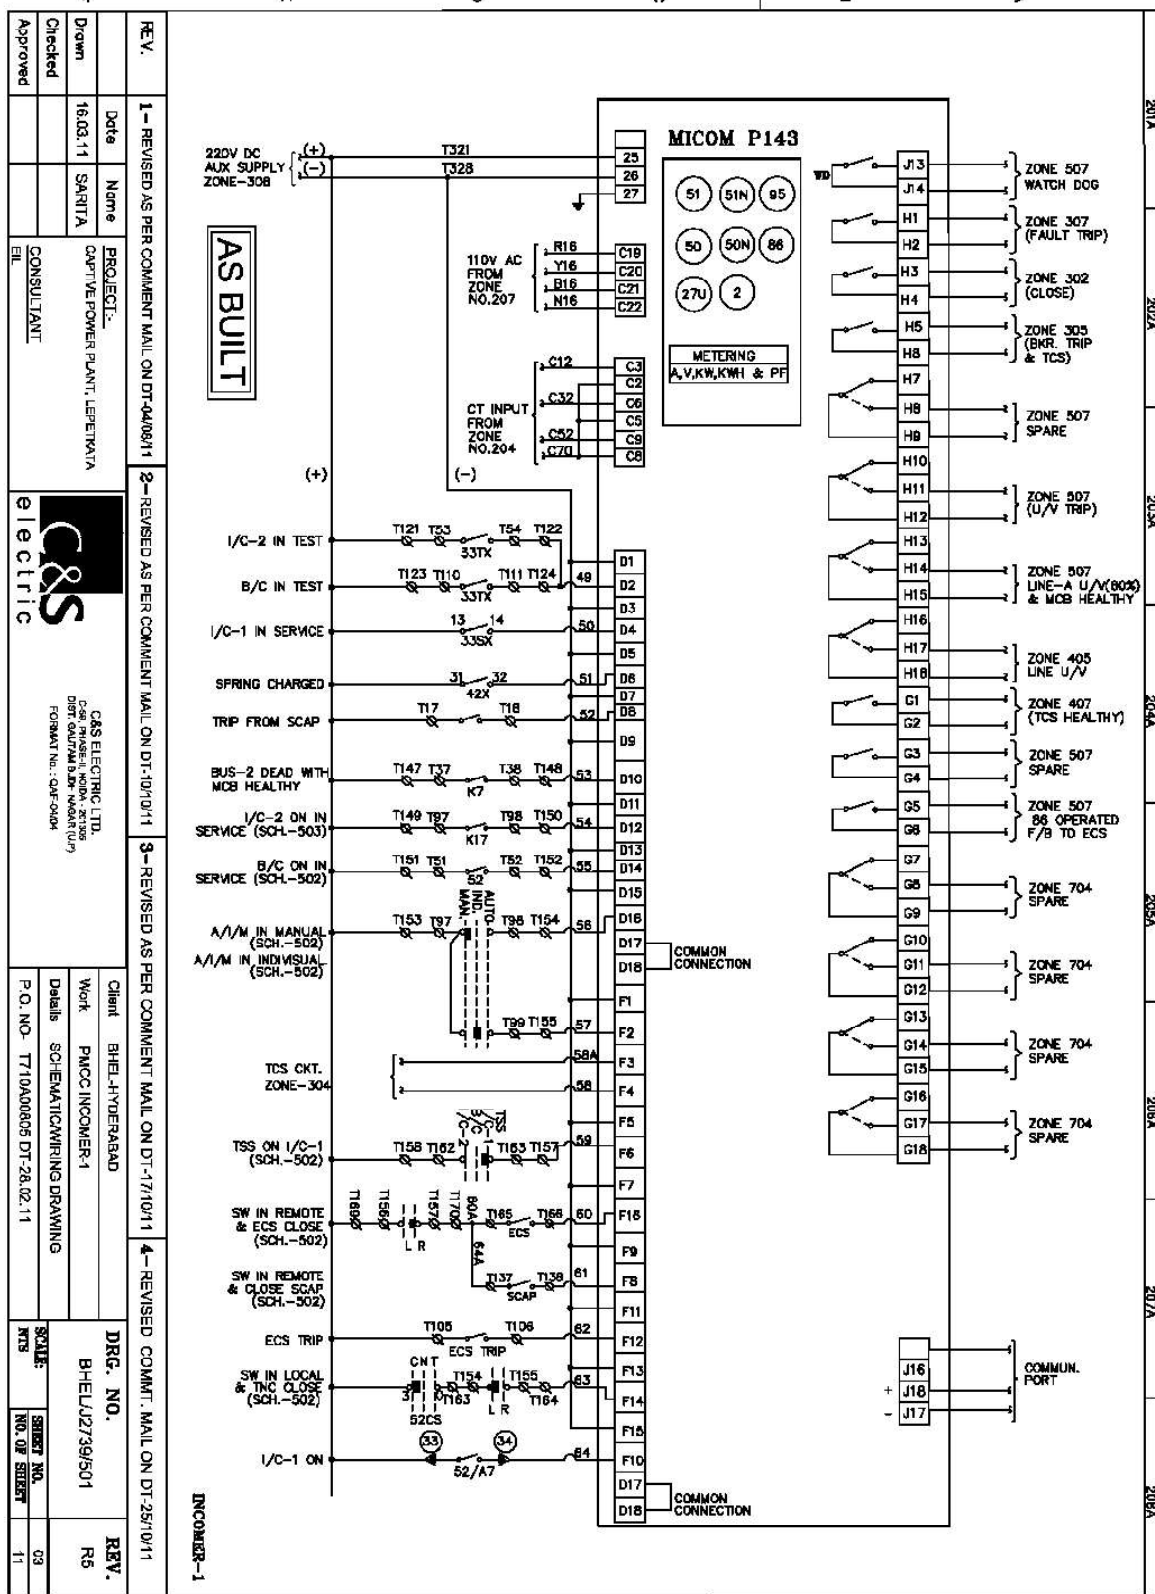

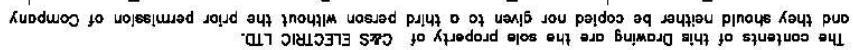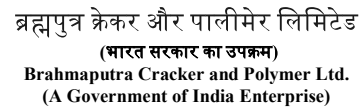




ब्रह्मपुत्र क्रेकर और पालीमेर लिमिटेड
(भारत सरकार का उपक्रम)
Brahmaputra Cracker and Polymer Ltd.
(A Government of India Enterprise)

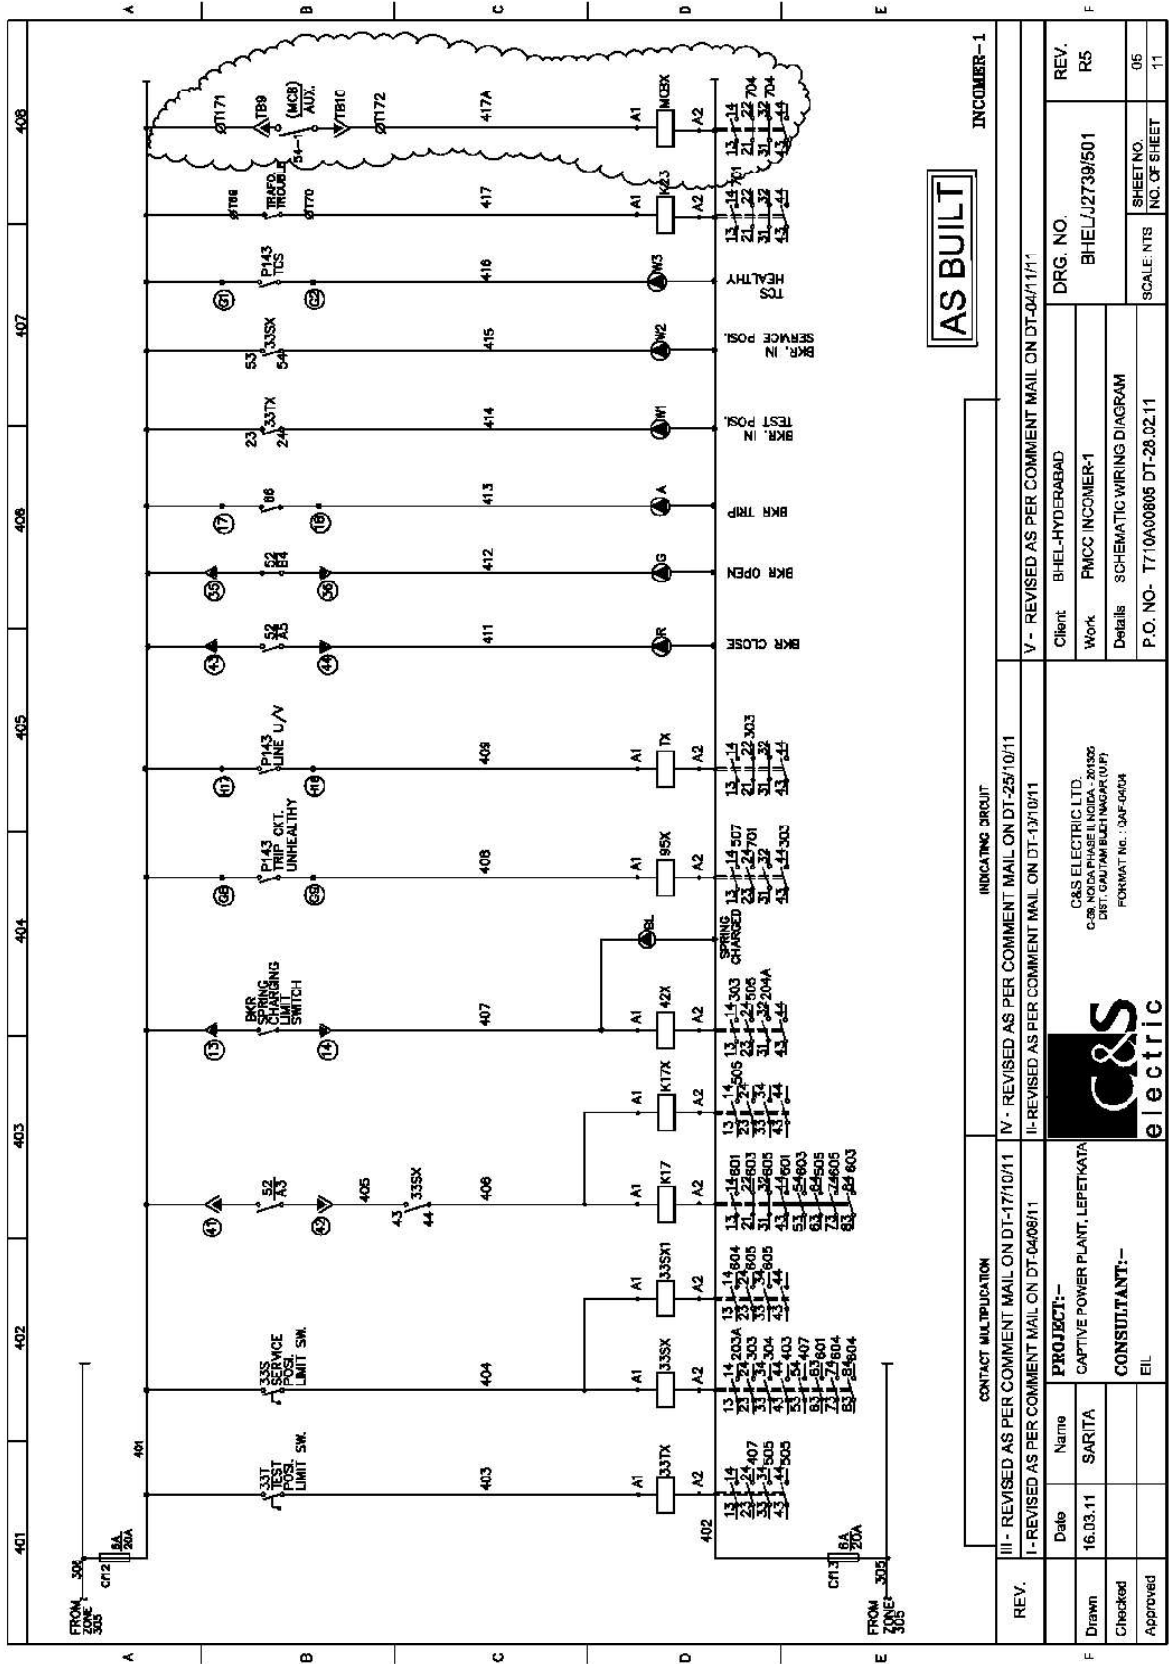

AS BUILT

CONTACT MULTIPLICATION		INDICATING CIRCUIT		INCOMER-1	
REV.	III - REVISED AS PER COMMENT MAIL ON DT-17/10/11	IV - REVISED AS PER COMMENT MAIL ON DT-25/10/11	V - REVISED AS PER COMMENT MAIL ON DT-04/11/11		
PROJECT:-		C&S ELECTRIC LTD.		REV.	
CAPTIVE POWER PLANT, LEFETKATA		C&S ELECTRIC LTD.		BHEL/J2739/501	
CONSULTANT:-		C&S ELECTRIC LTD.		R5	
EIL		C&S ELECTRIC LTD.		SHEET NO.	
				NO. OF SHEET	
				SCALE: NTS	
				P.O. NO. T710A00805 DT-28.02.11	
				05	
				11	

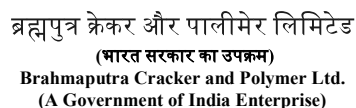



(भारत सरकार का उपक्रम)
Brahmaputra Cracker and Polymer Ltd.
(A Government of India Enterprise)



TERMINALS DETAILS


REV.	III - REVISED AS PER COMMENT MAIL ON DT-17/10/11		IV - REVISED AS PER COMMENT MAIL ON DT-25/10/11		V - REVISED AS PER COMMENT MAIL ON DT-04/11/11		REV.
	I - REVISED AS PER COMMENT MAIL ON DT-04/08/11		II - REVISED AS PER COMMENT MAIL ON DT-10/10/11				
	Date	Name					
Drawn	16.03.11	SARITA	PROJECT:- CAPTIVE POWER PLANT, LEPETKATA CONSULTANT:-				
Approved					Client	BHEL-HYDERABAD	DRG. NO. BHEL/J2738/501
					Work	PMCC INCOMER-1	
						Details	SCHEMATIC WIRING DIAGRAM
						P.O. NO.	T710A00805 DT-28.02.11
						SHEET NO.	06
						NO. OF SHEET	11
						SCALE: NTS	

The contents of this Drawing are the sole property of C&S ELECTRIC LTD. and they should neither be copied nor given to a third person without the prior permission of Company.

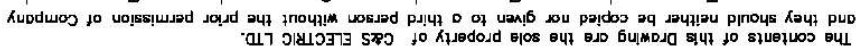
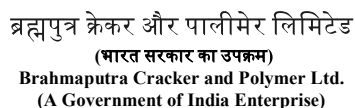




ब्रह्मपुत्र क्रेकर और पालीमेर लिमिटेड
(भारत सरकार का उपक्रम)
Brahmaputra Cracker and Polymer Ltd.
(A Government of India Enterprise)

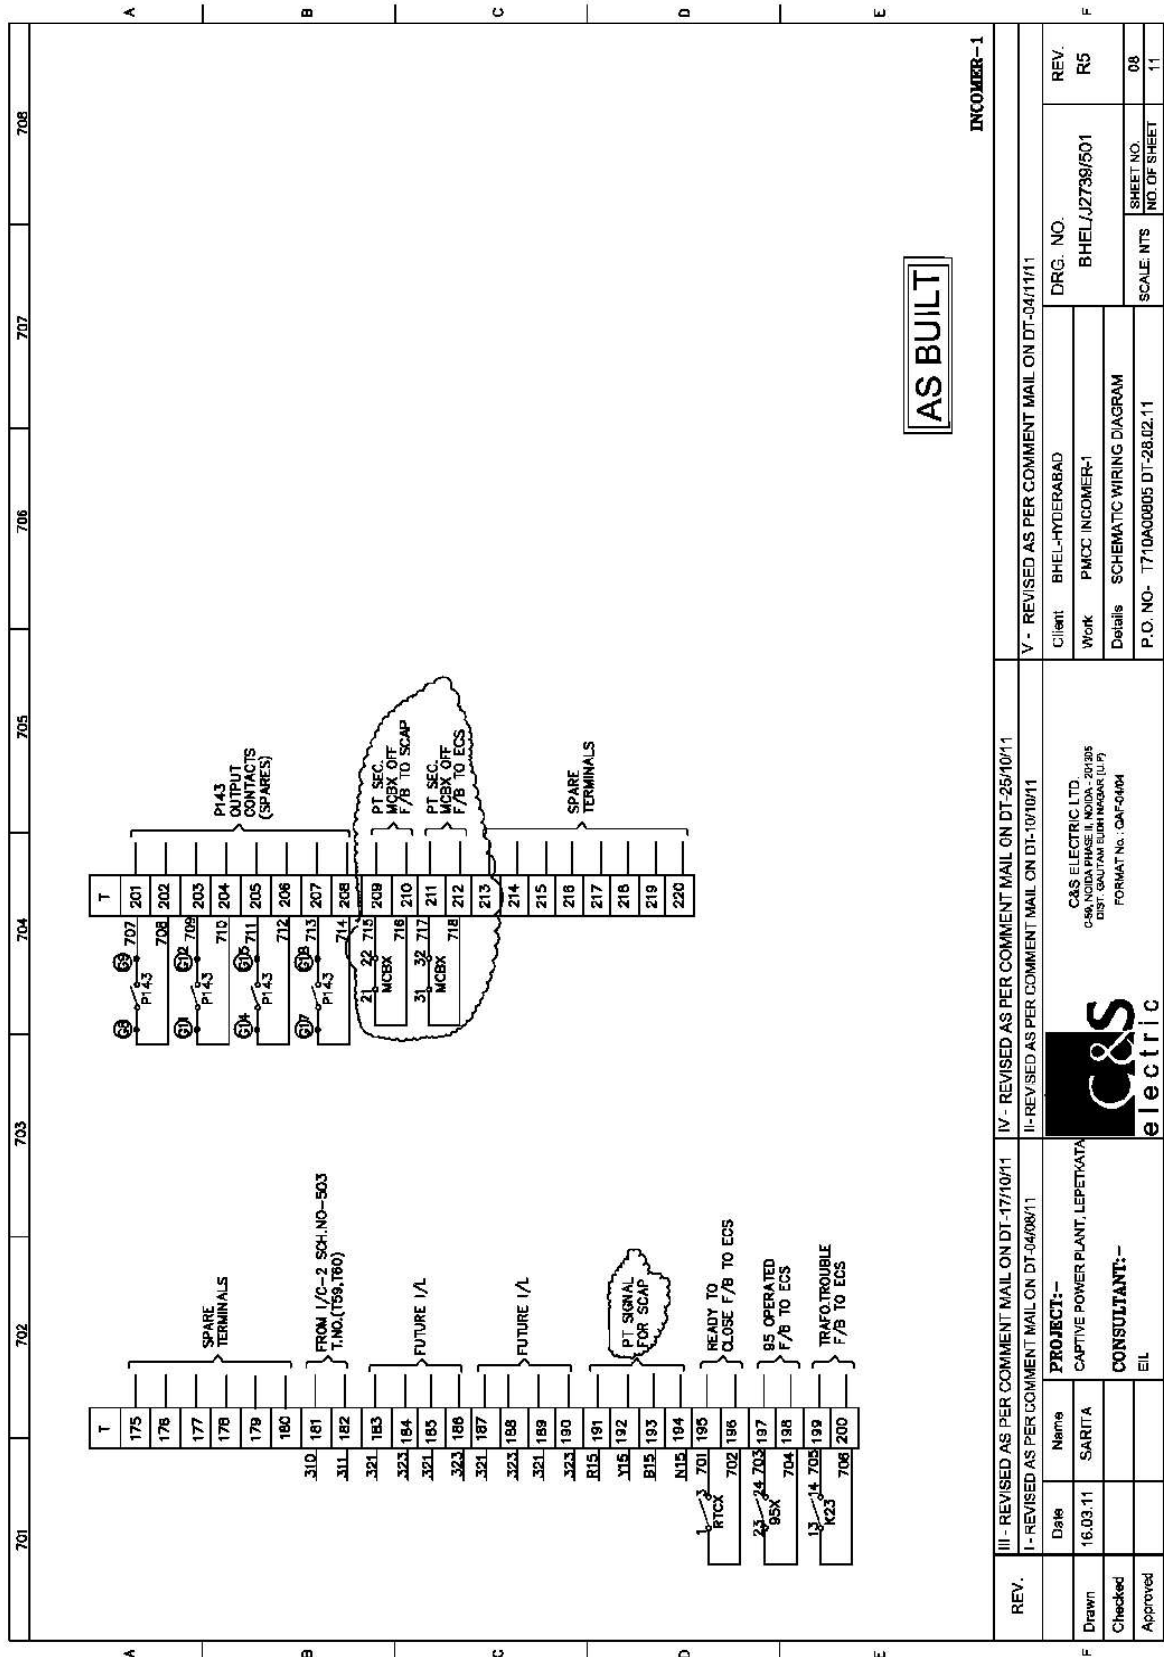



The contents of this Drawing are the sole property of C&S ELECTRIC LTD. and they should neither be copied nor given to a third person without the prior permission of Company.

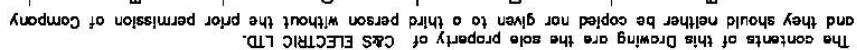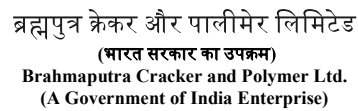





ब्रह्मपुत्र क्रेकर और पालीमेर लिमिटेड
(भारत सरकार का उपक्रम)
Brahmaputra Cracker and Polymer Ltd.
(A Government of India Enterprise)

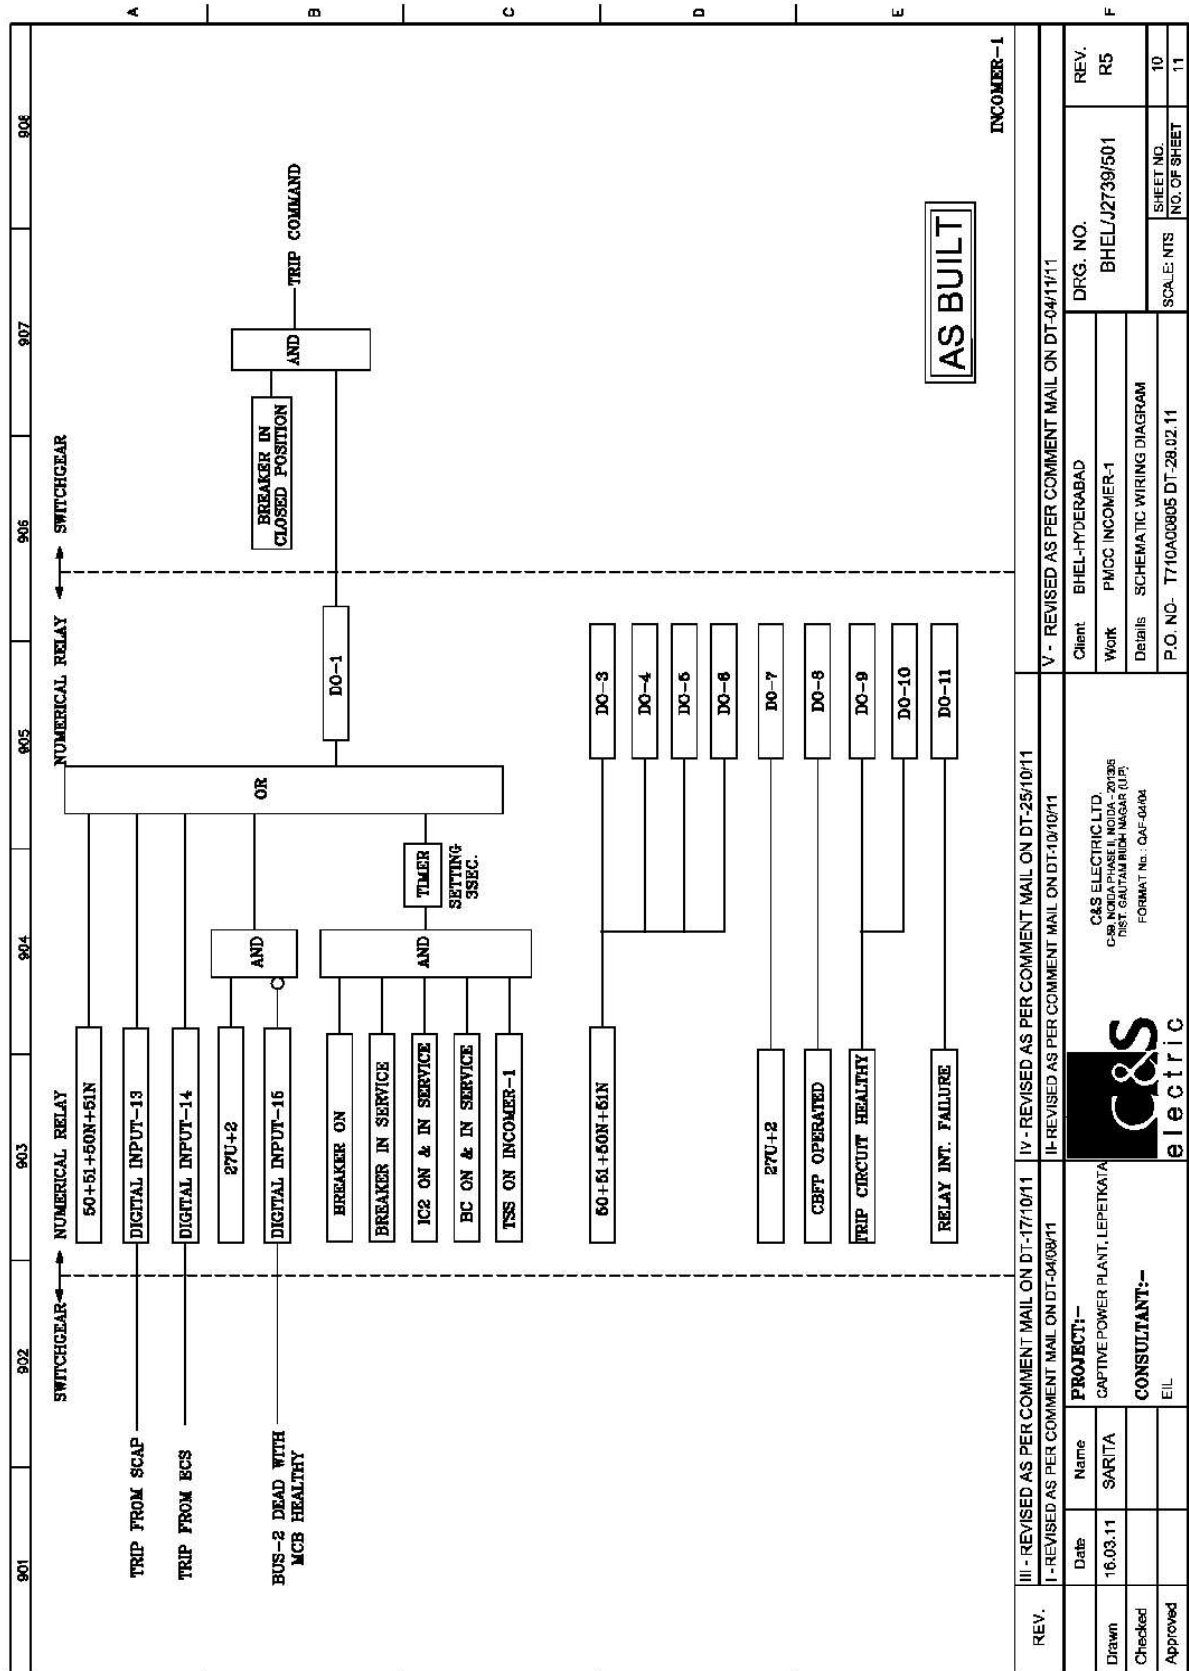

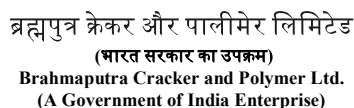



Page - 241 - of 255

[illegible]

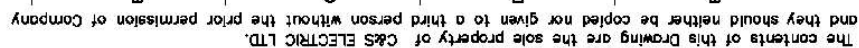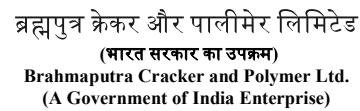


The contents of this Drawing are the sole property of C&S ELECTRIC LTD.
and they should neither be copied nor given to a third person without the prior permission of Company

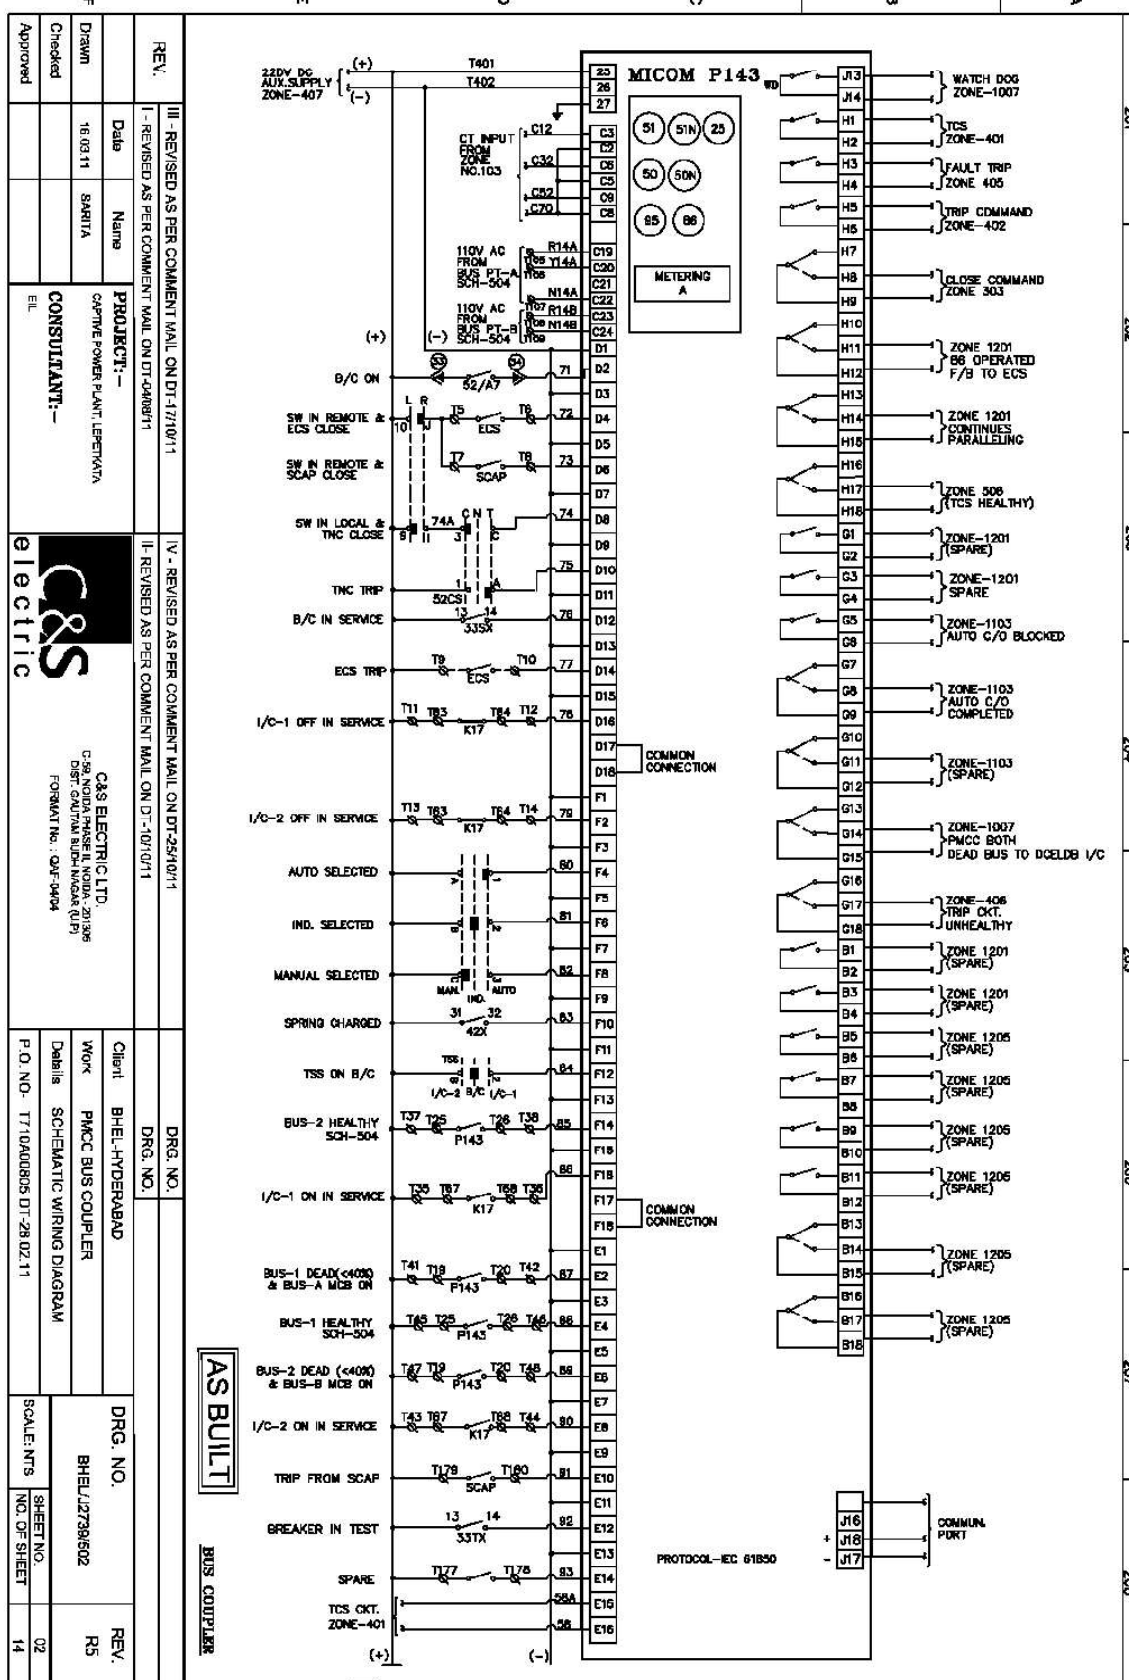

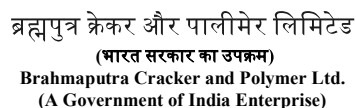


Brahmaputra Cracker and Polymer Ltd.
(A Government of India Enterprise)

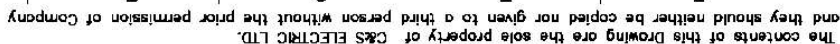



ब्रह्मपुत्र क्रेकर और पालीमेर लिमिटेड
(भारत सरकार का उपक्रम)
Brahmaputra Cracker and Polymer Ltd.
(A Government of India Enterprise)

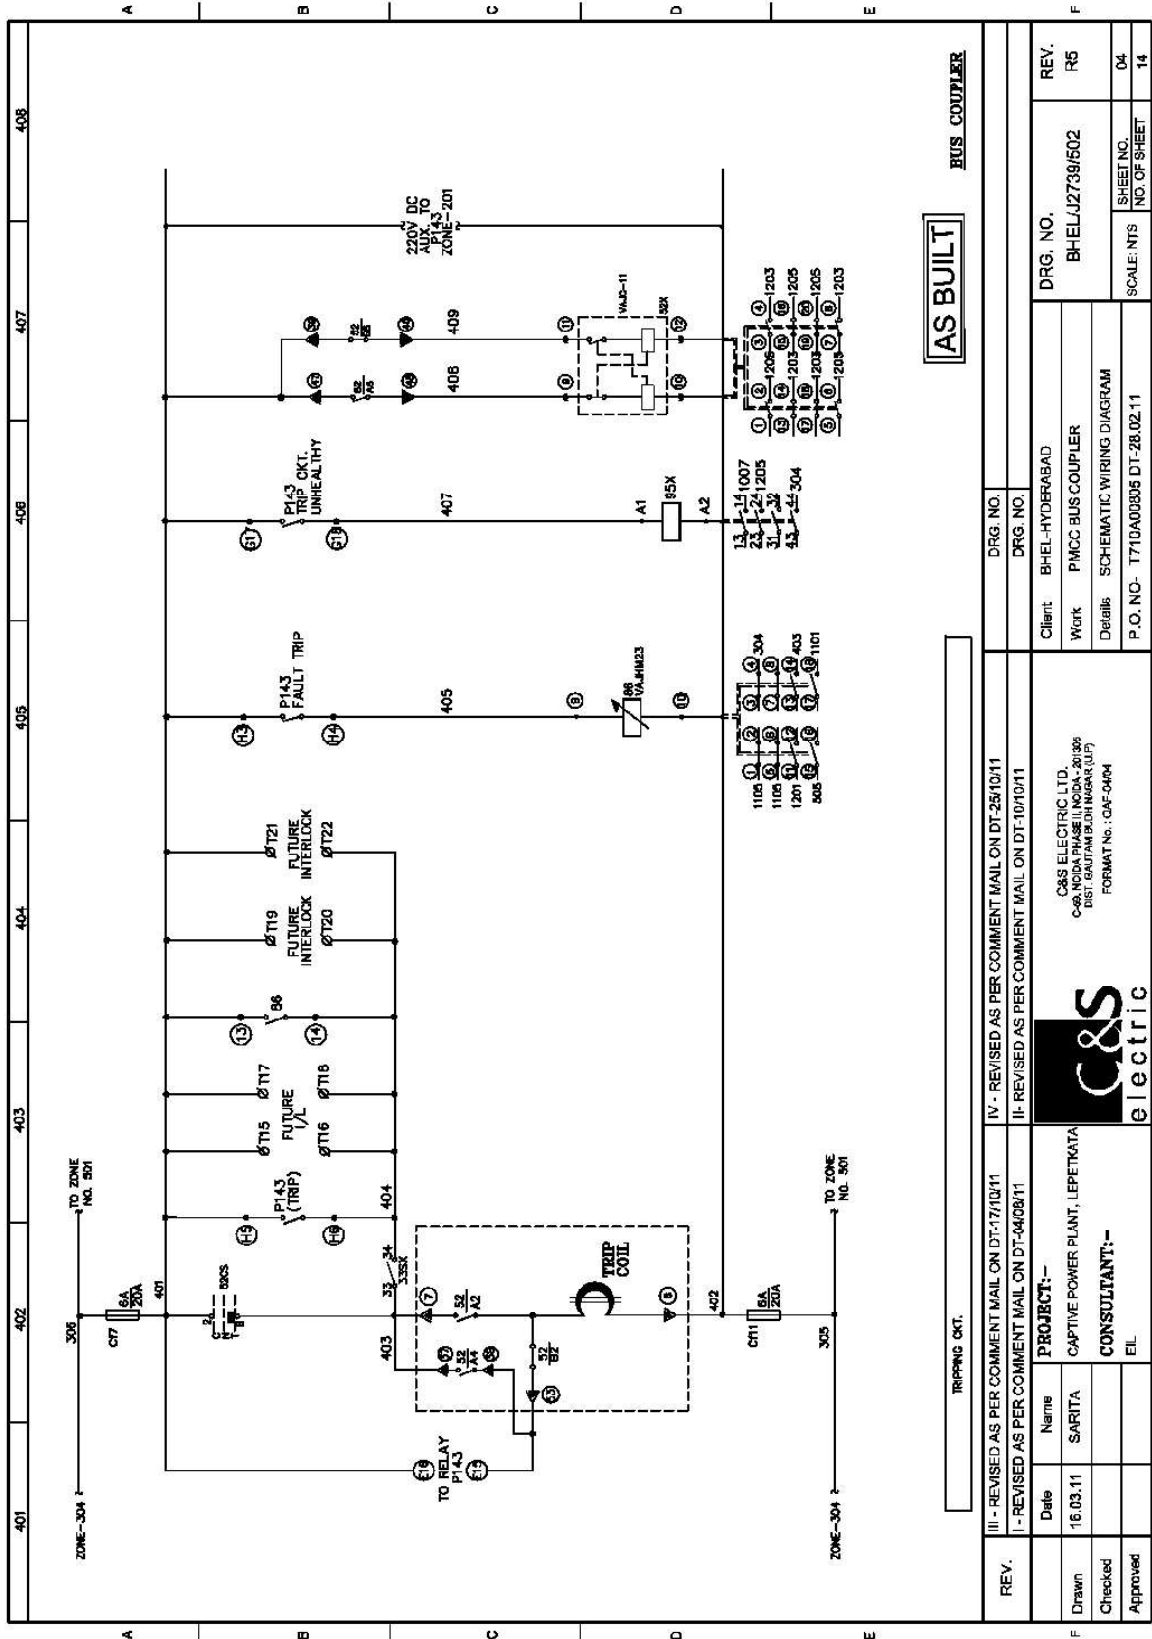



AS BUILT

TRIPPING CKT.

BUS COUPLER


REV.	III - REVISED AS PER COMMENT MAIL ON DT:17/10/11	IV - REVISED AS PER COMMENT MAIL ON DT:25/10/11	DRG. NO.	DRG. NO.
I - REVISED AS PER COMMENT MAIL ON DT:04/08/11	II - REVISED AS PER COMMENT MAIL ON DT:10/10/11			
Drawn	Date	Name	PROJECT:-	CLIENT: BHEL-HYDERABAD
Checked	16.03.11	SARITA	CAPTIVE POWER PLANT, LEPTHATA	Work PMCC BUS COUPLER
Approved			CONSULTANT:-	Details SCHEMATIC WIRING DIAGRAM
			EIL	P.O. NO. T710A00805 DT-28.02.11
				SCALE: NTS
				SHEET NO. 04
				NO. OF SHEET 14
				DRG. NO. BHEL/J2739/502
				REV. R5



The contents of this Drawing are the sole property of C&S ELECTRIC LTD. and they should neither be copied nor given to a third person without the prior permission of Company

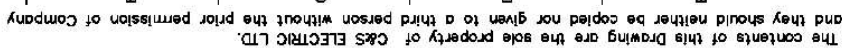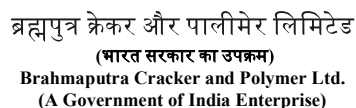




ब्रह्मपुत्र क्रेकर और पालीमेर लिमिटेड
(भारत सरकार का उपक्रम)
Brahmaputra Cracker and Polymer Ltd.
(A Government of India Enterprise)

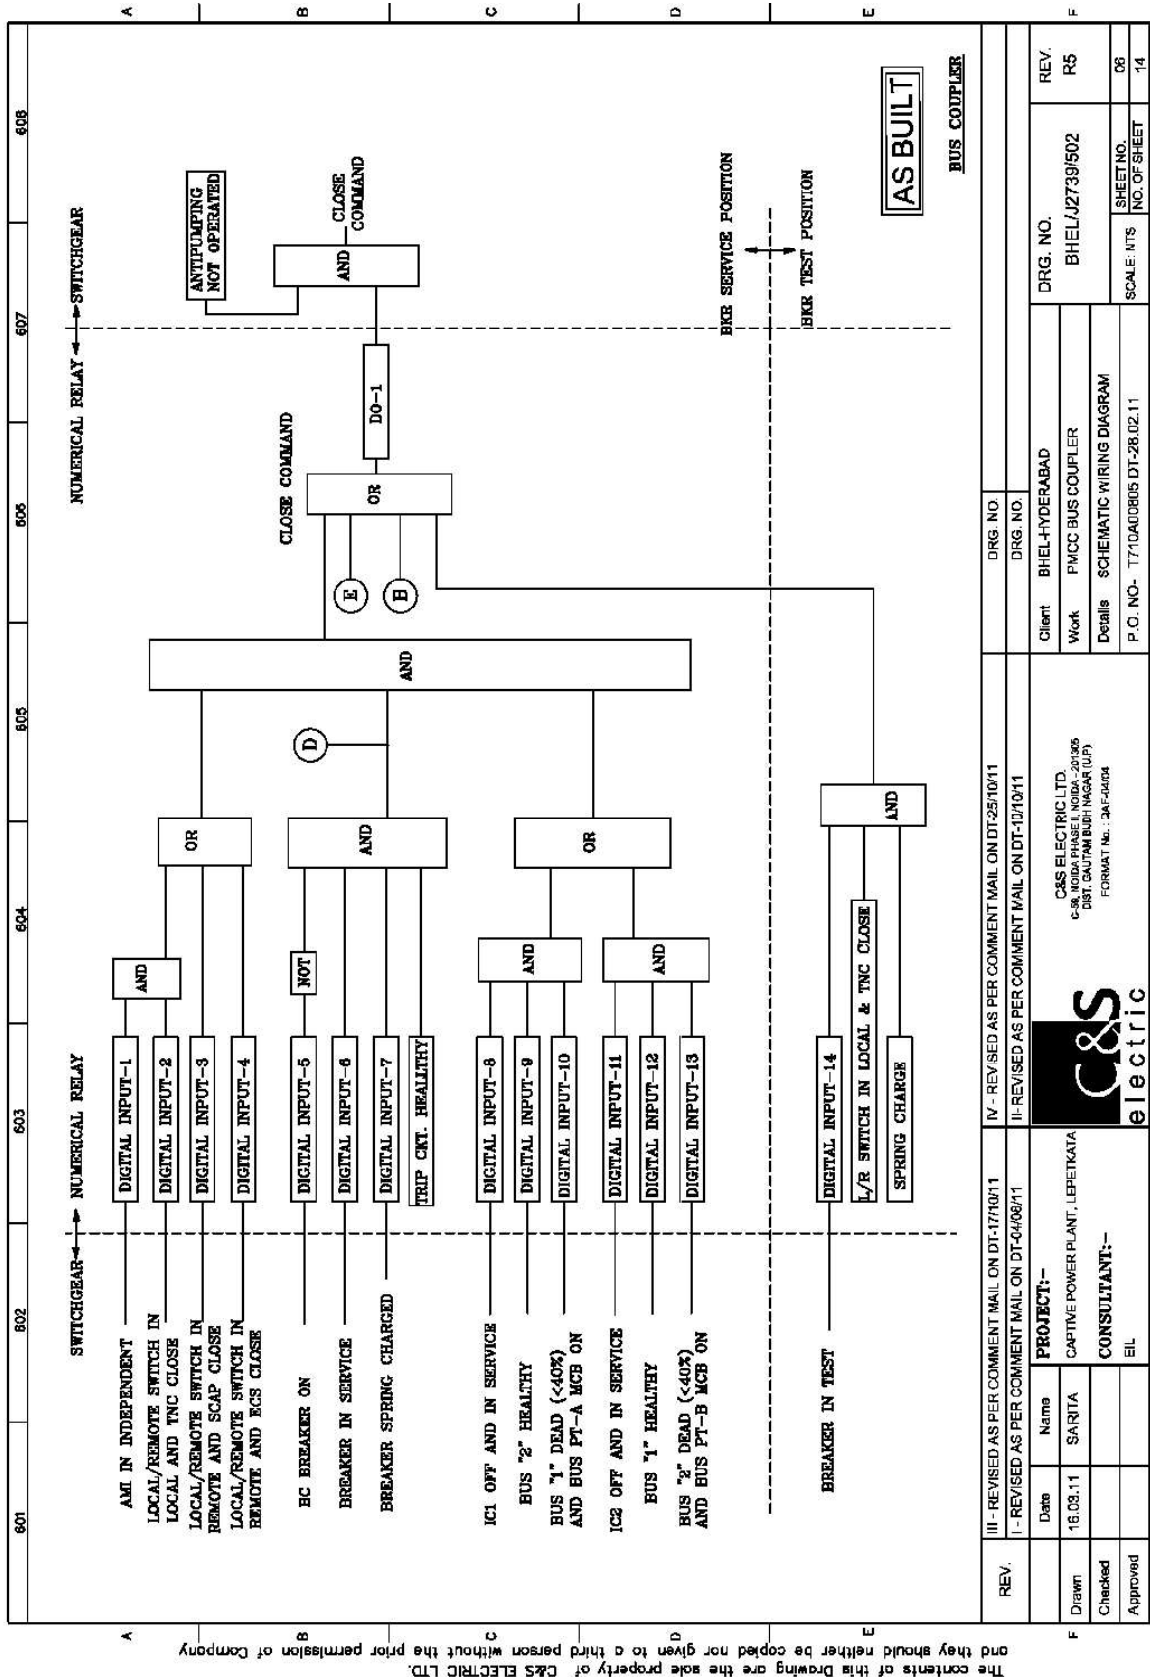

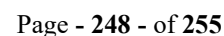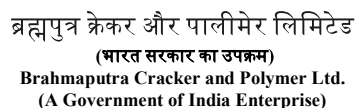



ब्रह्मपुत्र क्रेकर और पालीमेर लिमिटेड
(भारत सरकार का उपक्रम)
Brahmaputra Cracker and Polymer Ltd.
(A Government of India Enterprise)

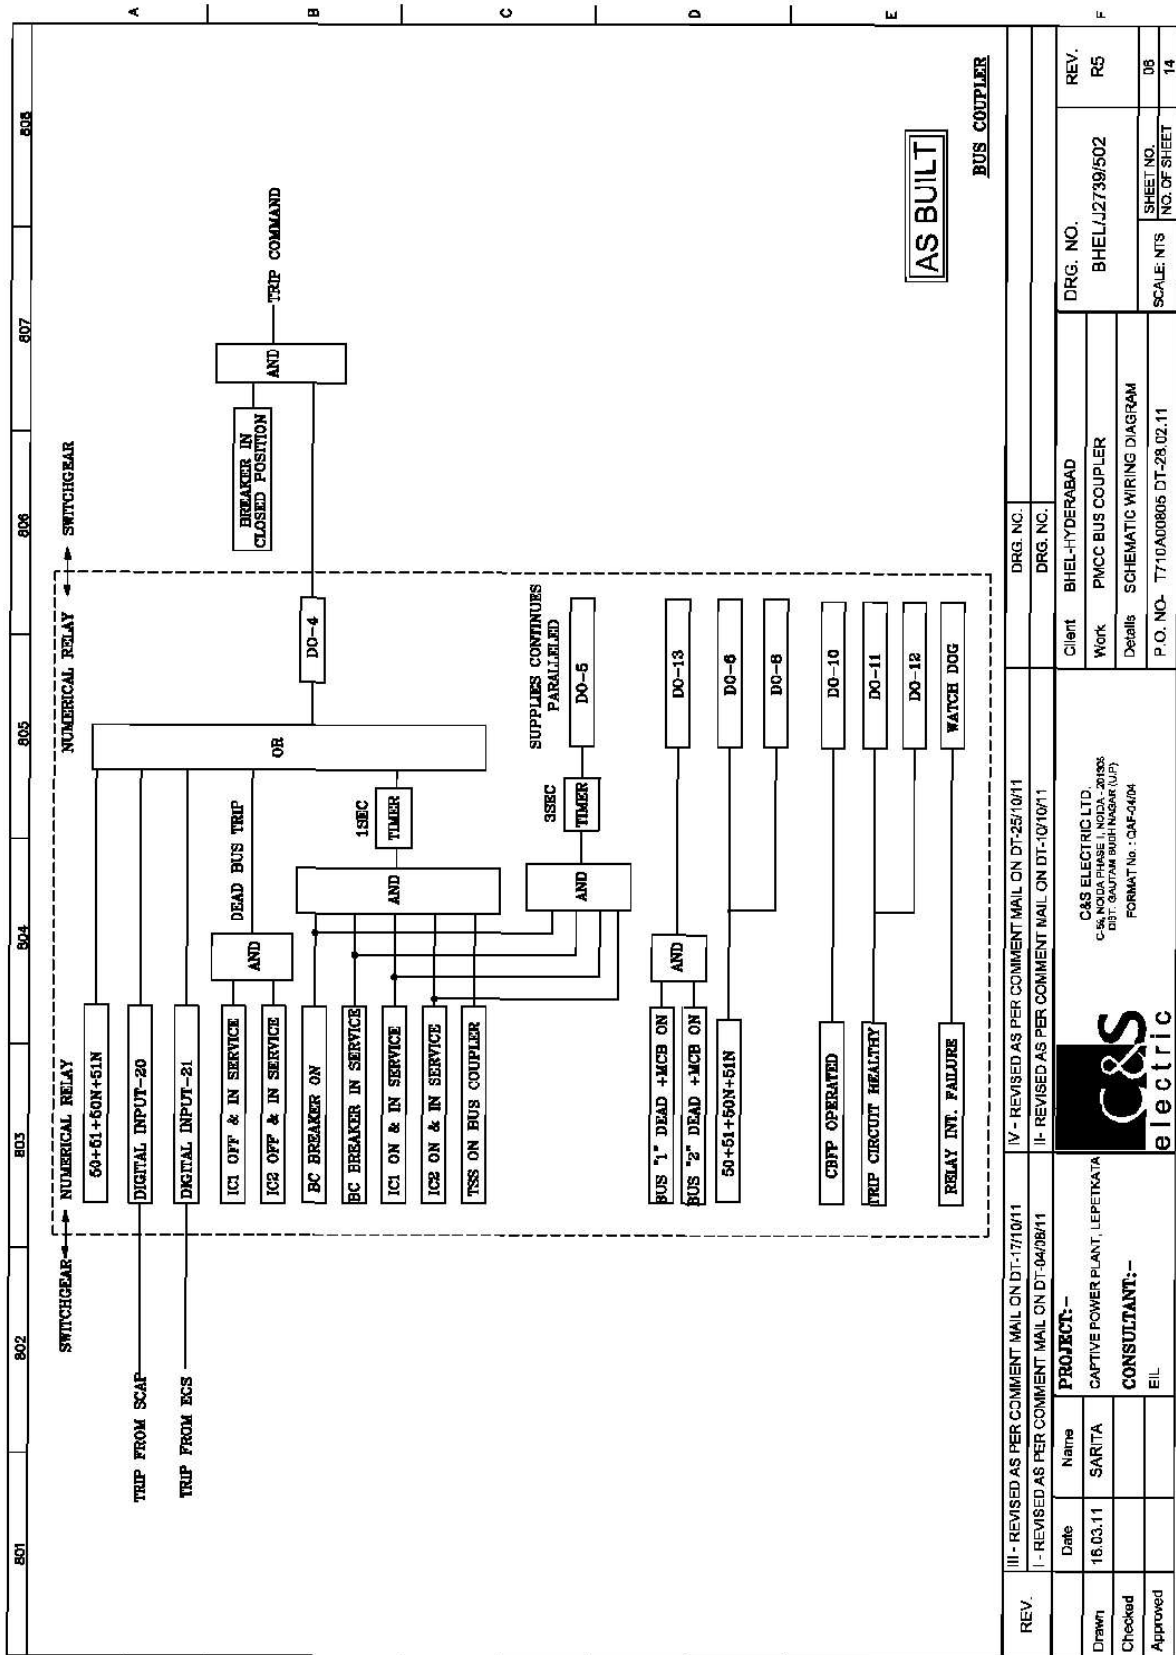



The contents of this Drawing are the sole property of C&S ELECTRIC LTD. and they should neither be copied nor given to a third person without the prior permission of Company



ब्रह्मपुत्र क्रेकर और पालीमेर लिमिटेड
(भारत सरकार का उपक्रम)
Brahmaputra Cracker and Polymer Ltd.
(A Government of India Enterprise)


901		902		903		904		905		906		907		908	
PROTECTION FUNCTIONS	
<table border="1"><thead><tr><th>NO.</th><th>FUNCTION</th></tr></thead><tbody><tr><td>5</td><td>3-PH IMT/DMT O/C PROTECTION</td></tr><tr><td>6</td><td>3-PH INST/DMT O/C PROTECTION</td></tr><tr><td>7</td><td>DMT/DMT E/F PROTECTION</td></tr><tr><td>8</td><td>INST/DMT E/F PROTECTION</td></tr><tr><td>9</td><td>CHECK SYNCHRONISM</td></tr><tr><td>10</td><td>CIRCUIT BREAKER FAILURE</td></tr></tbody></table>																NO.	FUNCTION	5	3-PH IMT/DMT O/C PROTECTION	6	3-PH INST/DMT O/C PROTECTION	7	DMT/DMT E/F PROTECTION	8	INST/DMT E/F PROTECTION	9	CHECK SYNCHRONISM	10	CIRCUIT BREAKER FAILURE																																		
NO.	FUNCTION	
5	3-PH IMT/DMT O/C PROTECTION	
6	3-PH INST/DMT O/C PROTECTION	
7	DMT/DMT E/F PROTECTION	
8	INST/DMT E/F PROTECTION	
9	CHECK SYNCHRONISM	
10	CIRCUIT BREAKER FAILURE	
OTHER FUNCTIONS AVAILABLE IN RELAY	
<table border="1"><thead><tr><th>NO.</th><th>FUNCTION</th></tr></thead><tbody><tr><td>11</td><td>CIRCUIT BREAKER CONTROL</td></tr><tr><td>12</td><td>INTERLOCKING RECORDING</td></tr><tr><td>13</td><td>FAULT RECORDING</td></tr><tr><td>14</td><td>EVENT RECORDING</td></tr><tr><td>15</td><td>DOUBLING FEATURE DURING STARTING</td></tr></tbody></table>																NO.	FUNCTION	11	CIRCUIT BREAKER CONTROL	12	INTERLOCKING RECORDING	13	FAULT RECORDING	14	EVENT RECORDING	15	DOUBLING FEATURE DURING STARTING																																				
NO.	FUNCTION	
11	CIRCUIT BREAKER CONTROL	
12	INTERLOCKING RECORDING	
13	FAULT RECORDING	
14	EVENT RECORDING	
15	DOUBLING FEATURE DURING STARTING	
LED INDICATION ON RELAY	
<table border="1"><thead><tr><th>LED</th><th>DESCRIPTION</th></tr></thead><tbody><tr><td>1</td><td>DMT OVER CURRENT TRIP</td></tr><tr><td>2</td><td>INST. OVER CURRENT TRIP</td></tr><tr><td>3</td><td>DMT EARTH FAULT TRIP</td></tr><tr><td>4</td><td>INST. EARTH FAULT TRIP</td></tr><tr><td>5</td><td>CIRCUIT BREAKER FAILURE</td></tr><tr><td>6</td><td>TRIP CIRCUIT UNHEALTHY</td></tr><tr><td>7</td><td>CB SPRING NOT CHARGED</td></tr><tr><td>8</td><td>LOCKOUT OPERATED (BO)</td></tr><tr><td>9</td><td>CB CONDITION MONITORING ALARM</td></tr><tr><td>10</td><td>SYNCHROCHECK OK</td></tr><tr><td>11</td><td>SPARE</td></tr></tbody></table>																LED	DESCRIPTION	1	DMT OVER CURRENT TRIP	2	INST. OVER CURRENT TRIP	3	DMT EARTH FAULT TRIP	4	INST. EARTH FAULT TRIP	5	CIRCUIT BREAKER FAILURE	6	TRIP CIRCUIT UNHEALTHY	7	CB SPRING NOT CHARGED	8	LOCKOUT OPERATED (BO)	9	CB CONDITION MONITORING ALARM	10	SYNCHROCHECK OK	11	SPARE																								
LED	DESCRIPTION	
1	DMT OVER CURRENT TRIP	
2	INST. OVER CURRENT TRIP	
3	DMT EARTH FAULT TRIP	
4	INST. EARTH FAULT TRIP	
5	CIRCUIT BREAKER FAILURE	
6	TRIP CIRCUIT UNHEALTHY	
7	CB SPRING NOT CHARGED	
8	LOCKOUT OPERATED (BO)	
9	CB CONDITION MONITORING ALARM	
10	SYNCHROCHECK OK	
11	SPARE	
MEASUREMENT FUNCTIONS	
<table border="1"><thead><tr><th>NO.</th><th>FUNCTION</th></tr></thead><tbody><tr><td>1</td><td>3-PHASE CURRENT MEASUREMENT</td></tr><tr><td>2</td><td>NEUTRAL CURRENT MEASUREMENT</td></tr><tr><td>3</td><td>ACTIVE POWER MEASUREMENT</td></tr><tr><td>4</td><td>REACTIVE POWER MEASUREMENT</td></tr><tr><td>5</td><td>ENERGY MEASUREMENT</td></tr><tr><td>6</td><td>POWER FACTOR MEASUREMENT</td></tr></tbody></table>																NO.	FUNCTION	1	3-PHASE CURRENT MEASUREMENT	2	NEUTRAL CURRENT MEASUREMENT	3	ACTIVE POWER MEASUREMENT	4	REACTIVE POWER MEASUREMENT	5	ENERGY MEASUREMENT	6	POWER FACTOR MEASUREMENT																																		
NO.	FUNCTION	
1	3-PHASE CURRENT MEASUREMENT	
2	NEUTRAL CURRENT MEASUREMENT	
3	ACTIVE POWER MEASUREMENT	
4	REACTIVE POWER MEASUREMENT	
5	ENERGY MEASUREMENT	
6	POWER FACTOR MEASUREMENT	
CONDITION MONITORING FEATURES	
<table border="1"><thead><tr><th>NO.</th><th>FUNCTION</th></tr></thead><tbody><tr><td>1</td><td>RELAY INTERNAL SELF SUPERVISION</td></tr><tr><td>2</td><td>TRIP CIRCUIT SUPERVISION</td></tr><tr><td>3</td><td>BREAKER CONDITION MONITORING</td></tr></tbody></table>																NO.	FUNCTION	1	RELAY INTERNAL SELF SUPERVISION	2	TRIP CIRCUIT SUPERVISION	3	BREAKER CONDITION MONITORING	
NO.	FUNCTION	
1	RELAY INTERNAL SELF SUPERVISION	
2	TRIP CIRCUIT SUPERVISION	
3	BREAKER CONDITION MONITORING	
RELAY COMMUNICATION DETAILS	
<table border="1"><thead><tr><th>PORT</th><th>PROTOCOL</th></tr></thead><tbody><tr><td>FRONT COMMUNICATION PORT</td><td>RS232</td></tr><tr><td>REAR COMMUNICATION PORT</td><td>RS485</td></tr><tr><td>COMMUNICATION PROTOCOL</td><td>IEC-61850</td></tr></tbody></table>																PORT	PROTOCOL	FRONT COMMUNICATION PORT	RS232	REAR COMMUNICATION PORT	RS485	COMMUNICATION PROTOCOL	IEC-61850	
PORT	PROTOCOL	
FRONT COMMUNICATION PORT	RS232	
REAR COMMUNICATION PORT	RS485	
COMMUNICATION PROTOCOL	IEC-61850	
OUTPUT CONTACT OF RELAY	
<table border="1"><thead><tr><th>OUTPUT NO.</th><th>SIGNAL DESCRIPTION</th></tr></thead><tbody><tr><td>J13, J14</td><td>WATCH DOG</td></tr><tr><td>H1, H2</td><td>TRIP CIRCUIT MONITORING</td></tr><tr><td>H3, H4</td><td>FAULT TRIP</td></tr><tr><td>H5, H6</td><td>TRIP COMMAND</td></tr><tr><td>H8, H9</td><td>CB CLOSE COMMAND</td></tr><tr><td>H11, H12</td><td>BO OPERATED F/F TO EDS</td></tr><tr><td>H14, H15</td><td>CONTINUES PARALLELING</td></tr><tr><td>H17, H18</td><td>TTS HEALTHY</td></tr><tr><td>G1, G2</td><td>SPARE CONTACT</td></tr><tr><td>G3, G4</td><td>SPARE CONTACT</td></tr><tr><td>G5, G6</td><td>AUTO CHARGE OVER BLOCKED</td></tr><tr><td>G8, G9</td><td>AUTO CHARGE OVER COMPLETED</td></tr><tr><td>G11, G12</td><td>SPARE CONTACT</td></tr><tr><td>G14, G15</td><td>PMCC BOTH DEAD BUS TO DOUBLER I/C</td></tr><tr><td>G17, G18</td><td>TRIP Ckt. UNHEALTHY</td></tr><tr><td>B1, B2</td><td>SPARE CONTACT</td></tr><tr><td>B3, B4</td><td>SPARE CONTACT</td></tr><tr><td>B5, B6</td><td>SPARE CONTACT</td></tr><tr><td>B7, B8</td><td>SPARE CONTACT</td></tr><tr><td>B9, B10</td><td>SPARE CONTACT</td></tr><tr><td>B11, B12</td><td>SPARE CONTACT</td></tr><tr><td>B14, B15</td><td>SPARE CONTACT</td></tr><tr><td>B17, B18</td><td>SPARE CONTACT</td></tr></tbody></table>																OUTPUT NO.	SIGNAL DESCRIPTION	J13, J14	WATCH DOG	H1, H2	TRIP CIRCUIT MONITORING	H3, H4	FAULT TRIP	H5, H6	TRIP COMMAND	H8, H9	CB CLOSE COMMAND	H11, H12	BO OPERATED F/F TO EDS	H14, H15	CONTINUES PARALLELING	H17, H18	TTS HEALTHY	G1, G2	SPARE CONTACT	G3, G4	SPARE CONTACT	G5, G6	AUTO CHARGE OVER BLOCKED	G8, G9	AUTO CHARGE OVER COMPLETED	G11, G12	SPARE CONTACT	G14, G15	PMCC BOTH DEAD BUS TO DOUBLER I/C	G17, G18	TRIP Ckt. UNHEALTHY	B1, B2	SPARE CONTACT	B3, B4	SPARE CONTACT	B5, B6	SPARE CONTACT	B7, B8	SPARE CONTACT	B9, B10	SPARE CONTACT	B11, B12	SPARE CONTACT	B14, B15	SPARE CONTACT	B17, B18	SPARE CONTACT
OUTPUT NO.	SIGNAL DESCRIPTION	
J13, J14	WATCH DOG	
H1, H2	TRIP CIRCUIT MONITORING	
H3, H4	FAULT TRIP	
H5, H6	TRIP COMMAND	
H8, H9	CB CLOSE COMMAND	
H11, H12	BO OPERATED F/F TO EDS	
H14, H15	CONTINUES PARALLELING	
H17, H18	TTS HEALTHY	
G1, G2	SPARE CONTACT	
G3, G4	SPARE CONTACT	
G5, G6	AUTO CHARGE OVER BLOCKED	
G8, G9	AUTO CHARGE OVER COMPLETED	
G11, G12	SPARE CONTACT	
G14, G15	PMCC BOTH DEAD BUS TO DOUBLER I/C	
G17, G18	TRIP Ckt. UNHEALTHY	
B1, B2	SPARE CONTACT	
B3, B4	SPARE CONTACT	
B5, B6	SPARE CONTACT	
B7, B8	SPARE CONTACT	
B9, B10	SPARE CONTACT	
B11, B12	SPARE CONTACT	
B14, B15	SPARE CONTACT	
B17, B18	SPARE CONTACT	
SIGNALS WIRED TO DI OF RELAY	
<table border="1"><thead><tr><th>INPUT NO.</th><th>SIGNAL DESCRIPTION</th></tr></thead><tbody><tr><td>D1-1</td><td>AM IN INDEPENDENT</td></tr><tr><td>D1-2</td><td>SW IN LOCAL & TNC CLOSE</td></tr><tr><td>D1-3</td><td>SW IN REMOTE & SOF CLOSE</td></tr><tr><td>D1-4</td><td>SW IN REMOTE & EDS CLOSE</td></tr><tr><td>D1-5</td><td>BUSCHARGER ON</td></tr><tr><td>D1-6</td><td>BUSCHARGER IN SERVICE</td></tr><tr><td>D1-7</td><td>BREAKER SPRING CHARGED</td></tr><tr><td>D1-8</td><td>I/C-1 OFF AND IN SERVICE</td></tr><tr><td>D1-9</td><td>BUS-2 HEALTHY</td></tr><tr><td>D1-10</td><td>BUS "1" DEAD (<40%) AND BUS PT-4 MCS ON</td></tr><tr><td>D1-11</td><td>I/C-2 OFF AND IN SERVICE</td></tr><tr><td>D1-12</td><td>BUS-1 HEALTHY</td></tr><tr><td>D1-13</td><td>BUS "2" DEAD (<40%) AND BUS PT-8 MCS ON</td></tr><tr><td>D1-14</td><td>BREAKER IN TEST</td></tr><tr><td>D1-15</td><td>AM IN AUTO</td></tr><tr><td>D1-16</td><td>I/C-1 ON AND IN SERVICE</td></tr><tr><td>D1-17</td><td>I/C-2 ON AND IN SERVICE</td></tr><tr><td>D1-18</td><td>AM IN MANUAL</td></tr><tr><td>D1-19</td><td>TTS ON BUSCOUPLER</td></tr><tr><td>D1-20</td><td>TRIP FROM SOF</td></tr><tr><td>D1-21</td><td>TRIP FROM EDS</td></tr></tbody></table>																INPUT NO.	SIGNAL DESCRIPTION	D1-1	AM IN INDEPENDENT	D1-2	SW IN LOCAL & TNC CLOSE	D1-3	SW IN REMOTE & SOF CLOSE	D1-4	SW IN REMOTE & EDS CLOSE	D1-5	BUSCHARGER ON	D1-6	BUSCHARGER IN SERVICE	D1-7	BREAKER SPRING CHARGED	D1-8	I/C-1 OFF AND IN SERVICE	D1-9	BUS-2 HEALTHY	D1-10	BUS "1" DEAD (<40%) AND BUS PT-4 MCS ON	D1-11	I/C-2 OFF AND IN SERVICE	D1-12	BUS-1 HEALTHY	D1-13	BUS "2" DEAD (<40%) AND BUS PT-8 MCS ON	D1-14	BREAKER IN TEST	D1-15	AM IN AUTO	D1-16	I/C-1 ON AND IN SERVICE	D1-17	I/C-2 ON AND IN SERVICE	D1-18	AM IN MANUAL	D1-19	TTS ON BUSCOUPLER	D1-20	TRIP FROM SOF	D1-21	TRIP FROM EDS				
INPUT NO.	SIGNAL DESCRIPTION	
D1-1	AM IN INDEPENDENT	
D1-2	SW IN LOCAL & TNC CLOSE	
D1-3	SW IN REMOTE & SOF CLOSE	
D1-4	SW IN REMOTE & EDS CLOSE	
D1-5	BUSCHARGER ON	
D1-6	BUSCHARGER IN SERVICE	
D1-7	BREAKER SPRING CHARGED	
D1-8	I/C-1 OFF AND IN SERVICE	
D1-9	BUS-2 HEALTHY	
D1-10	BUS "1" DEAD (<40%) AND BUS PT-4 MCS ON	
D1-11	I/C-2 OFF AND IN SERVICE	
D1-12	BUS-1 HEALTHY	
D1-13	BUS "2" DEAD (<40%) AND BUS PT-8 MCS ON	
D1-14	BREAKER IN TEST	
D1-15	AM IN AUTO	
D1-16	I/C-1 ON AND IN SERVICE	
D1-17	I/C-2 ON AND IN SERVICE	
D1-18	AM IN MANUAL	
D1-19	TTS ON BUSCOUPLER	
D1-20	TRIP FROM SOF	
D1-21	TRIP FROM EDS	
AS BUILT	
BUS COUPLER	
<table border="1"><thead><tr><th>REV.</th><th>DESCRIPTION</th><th>DATE</th><th>BY</th><th>CHKD</th><th>APPD</th></tr></thead><tbody><tr><td>1</td><td>REVISED AS PER COMMENT MAIL ON DT-17/10/11</td><td></td><td></td><td></td><td></td></tr><tr><td>2</td><td>REVISED AS PER COMMENT MAIL ON DT-04/08/11</td><td></td><td></td><td></td><td></td></tr><tr><td>3</td><td>REVISED AS PER COMMENT MAIL ON DT-25/10/11</td><td></td><td></td><td></td><td></td></tr></tbody></table>																REV.	DESCRIPTION	DATE	BY	CHKD	APPD	1	REVISED AS PER COMMENT MAIL ON DT-17/10/11					2	REVISED AS PER COMMENT MAIL ON DT-04/08/11					3	REVISED AS PER COMMENT MAIL ON DT-25/10/11																												
REV.	DESCRIPTION	DATE	BY	CHKD	APPD	
1	REVISED AS PER COMMENT MAIL ON DT-17/10/11	
2	REVISED AS PER COMMENT MAIL ON DT-04/08/11	
3	REVISED AS PER COMMENT MAIL ON DT-25/10/11	
<table border="1"><thead><tr><th>REV.</th><th>DRG. NO.</th><th>DRG. NO.</th><th>DRG. NO.</th><th>REV.</th></tr></thead><tbody><tr><td>1</td><td>BHEL HYDERABAD</td><td>BHEL HYDERABAD</td><td>BHEL HYDERABAD</td><td>R5</td></tr><tr><td>2</td><td>Work</td><td>PMCC BUS COUPLER</td><td>PMCC BUS COUPLER</td><td>R5</td></tr><tr><td>3</td><td>Details</td><td>SCHEMATIC WIRING DIAGRAM</td><td>SCHEMATIC WIRING DIAGRAM</td><td>R5</td></tr><tr><td>4</td><td>P.O. NO- T710A0805 DT-28.02.11</td><td>P.O. NO- T710A0805 DT-28.02.11</td><td>P.O. NO- T710A0805 DT-28.02.11</td><td>09</td></tr><tr><td>5</td><td></td><td></td><td></td><td>14</td></tr></tbody></table>																REV.	DRG. NO.	DRG. NO.	DRG. NO.	REV.	1	BHEL HYDERABAD	BHEL HYDERABAD	BHEL HYDERABAD	R5	2	Work	PMCC BUS COUPLER	PMCC BUS COUPLER	R5	3	Details	SCHEMATIC WIRING DIAGRAM	SCHEMATIC WIRING DIAGRAM	R5	4	P.O. NO- T710A0805 DT-28.02.11	P.O. NO- T710A0805 DT-28.02.11	P.O. NO- T710A0805 DT-28.02.11	09	5				14																		
REV.	DRG. NO.	DRG. NO.	DRG. NO.	REV.	
1	BHEL HYDERABAD	BHEL HYDERABAD	BHEL HYDERABAD	R5	
2	Work	PMCC BUS COUPLER	PMCC BUS COUPLER	R5	
3	Details	SCHEMATIC WIRING DIAGRAM	SCHEMATIC WIRING DIAGRAM	R5	
4	P.O. NO- T710A0805 DT-28.02.11	P.O. NO- T710A0805 DT-28.02.11	P.O. NO- T710A0805 DT-28.02.11	09	
5				14	

The contents of this Drawing are the sole property of C&S ELECTRIC LTD. and they should neither be copied nor given to a third person without the prior permission of Company

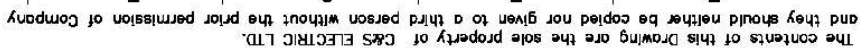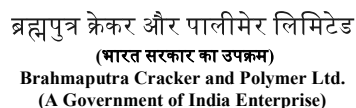






ब्रह्मपुत्र क्रैकर और पालीमेर लिमिटेड
(भारत सरकार का उपक्रम)
Brahmaputra Cracker and Polymer Ltd.
(A Government of India Enterprise)

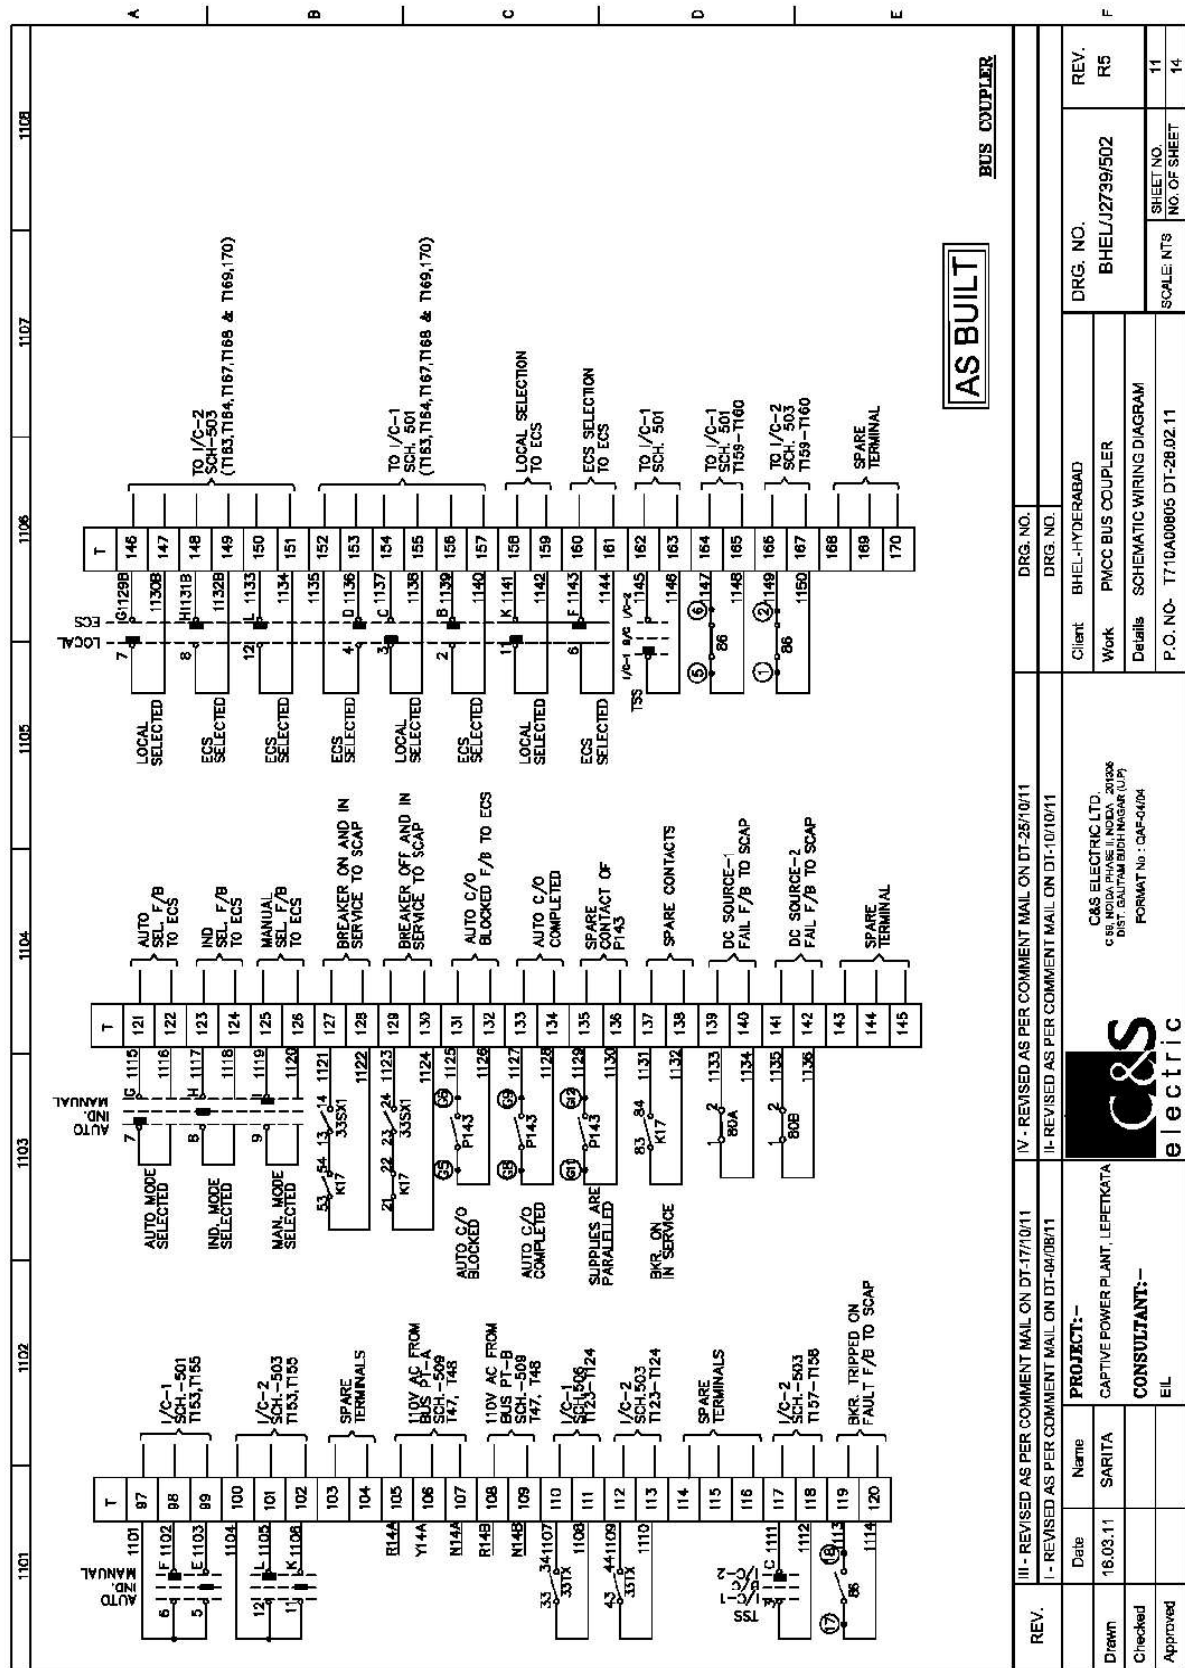




ब्रह्मपुत्र क्रेकर और पालीमेर लिमिटेड
(भारत सरकार का उपक्रम)
Brahmaputra Cracker and Polymer Ltd.
(A Government of India Enterprise)

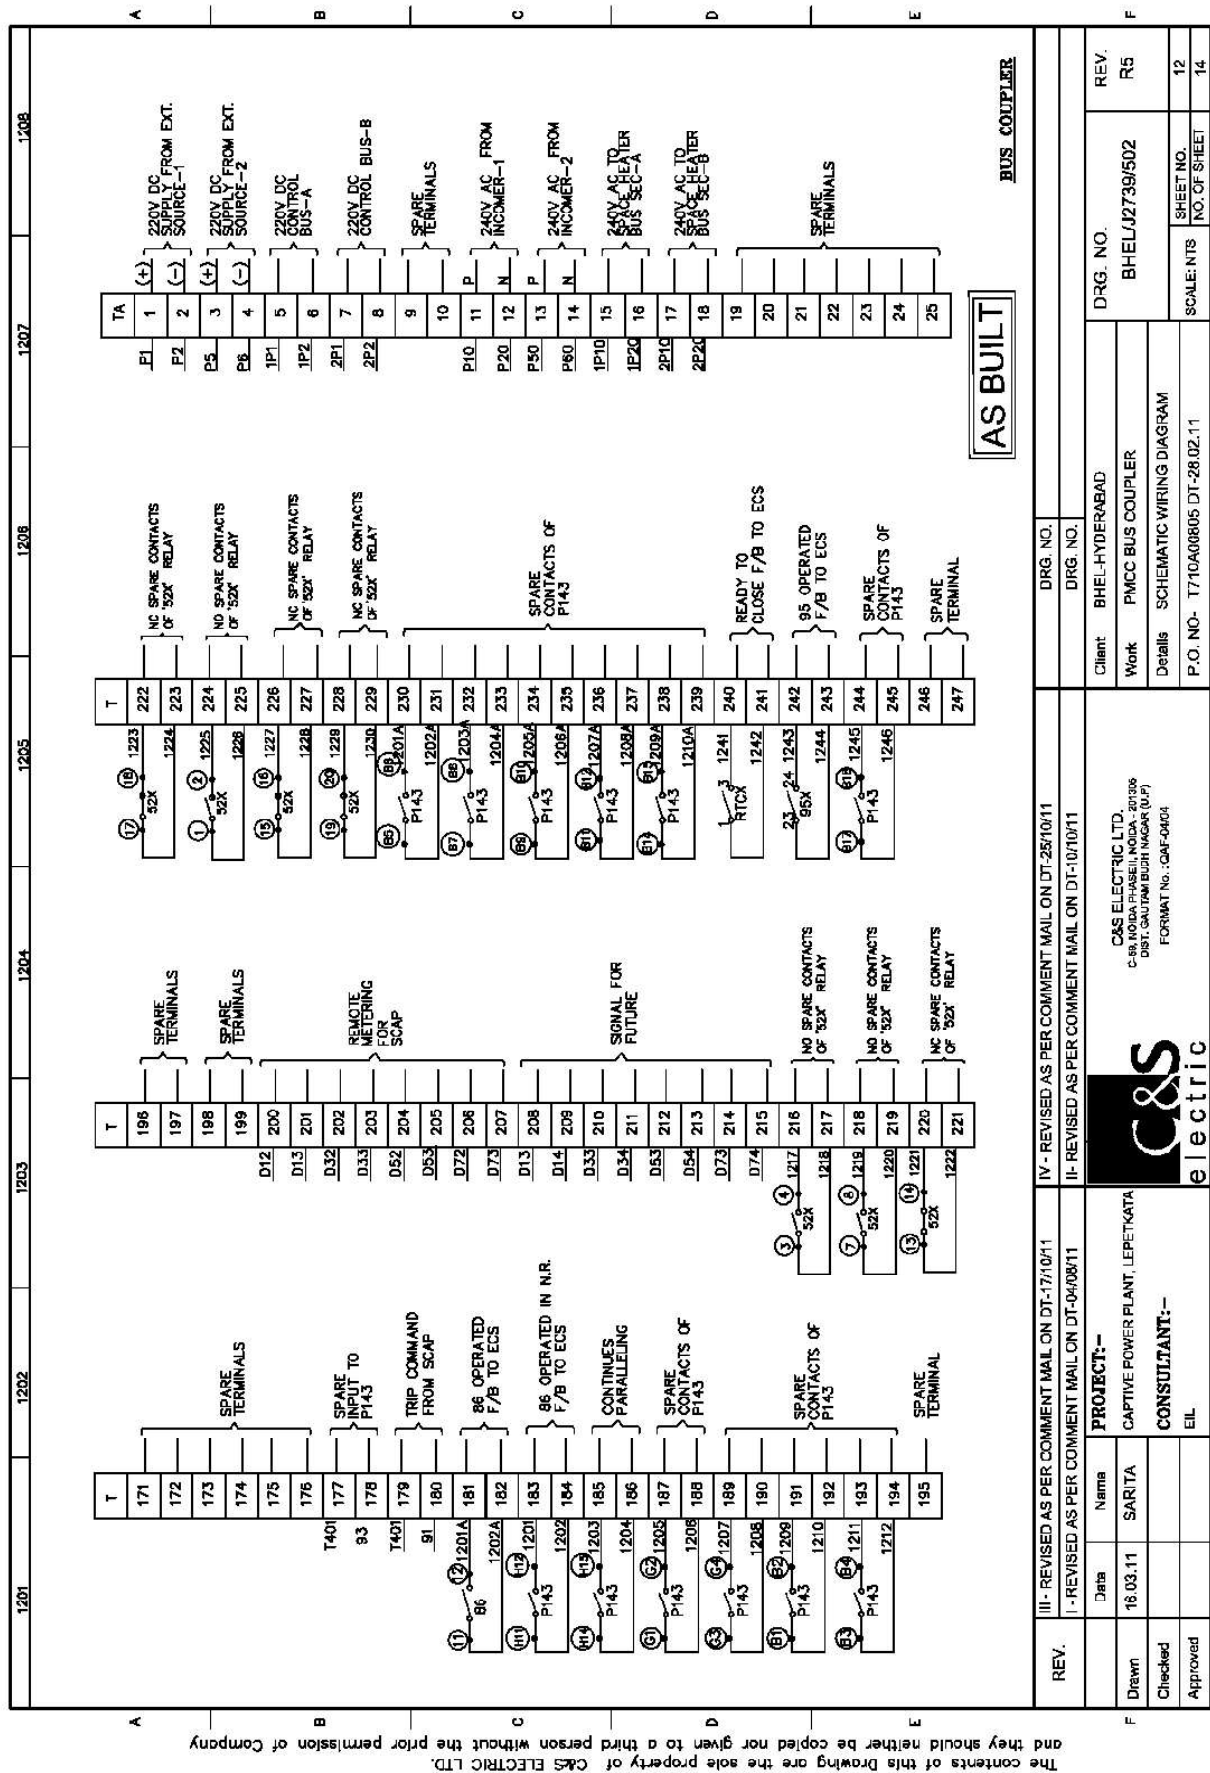

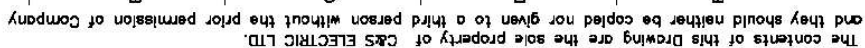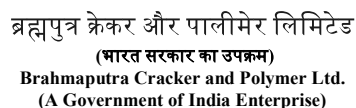



ब्रह्मपुत्र क्रेकर और पालीमेर लिमिटेड
(भारत सरकार का उपक्रम)
Brahmaputra Cracker and Polymer Ltd.
(A Government of India Enterprise)

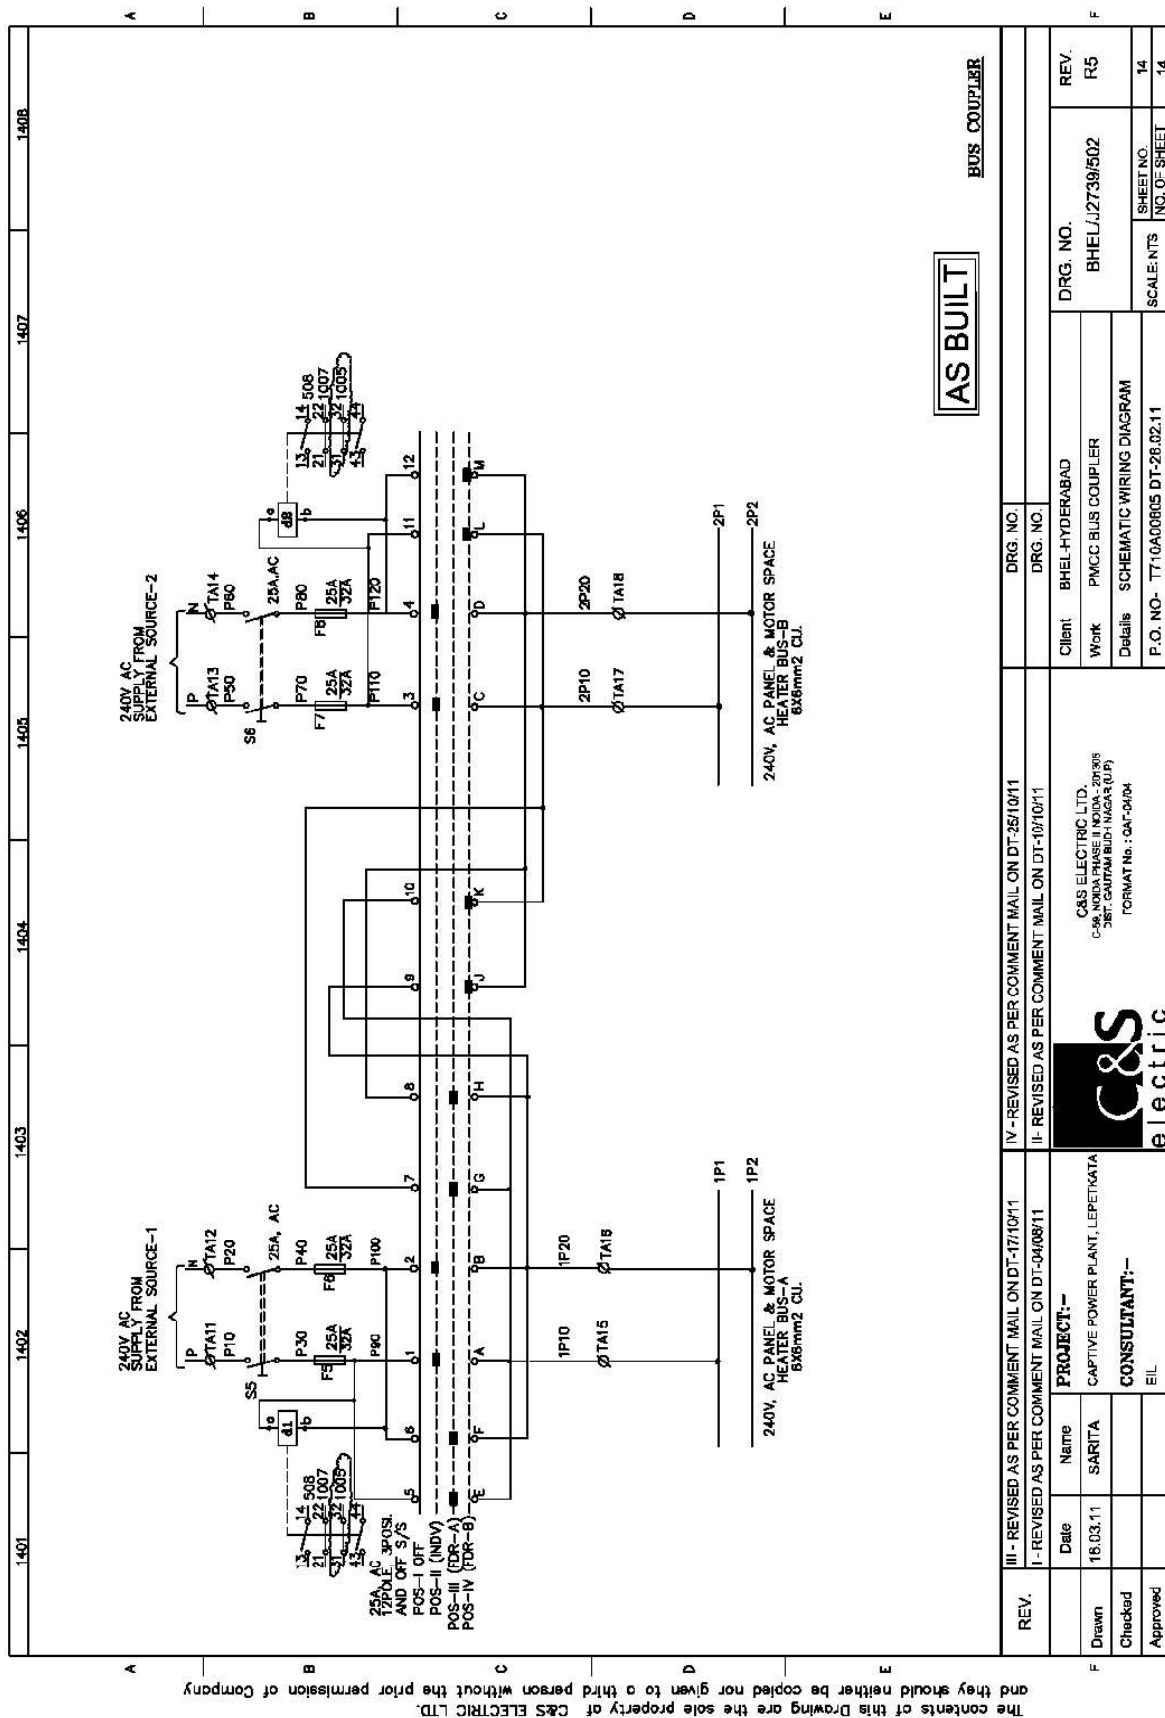

The contents of this Drawing are the sole property of C&S ELECTRIC LTD. and they should neither be copied nor given to a third person without the prior permission of Company