


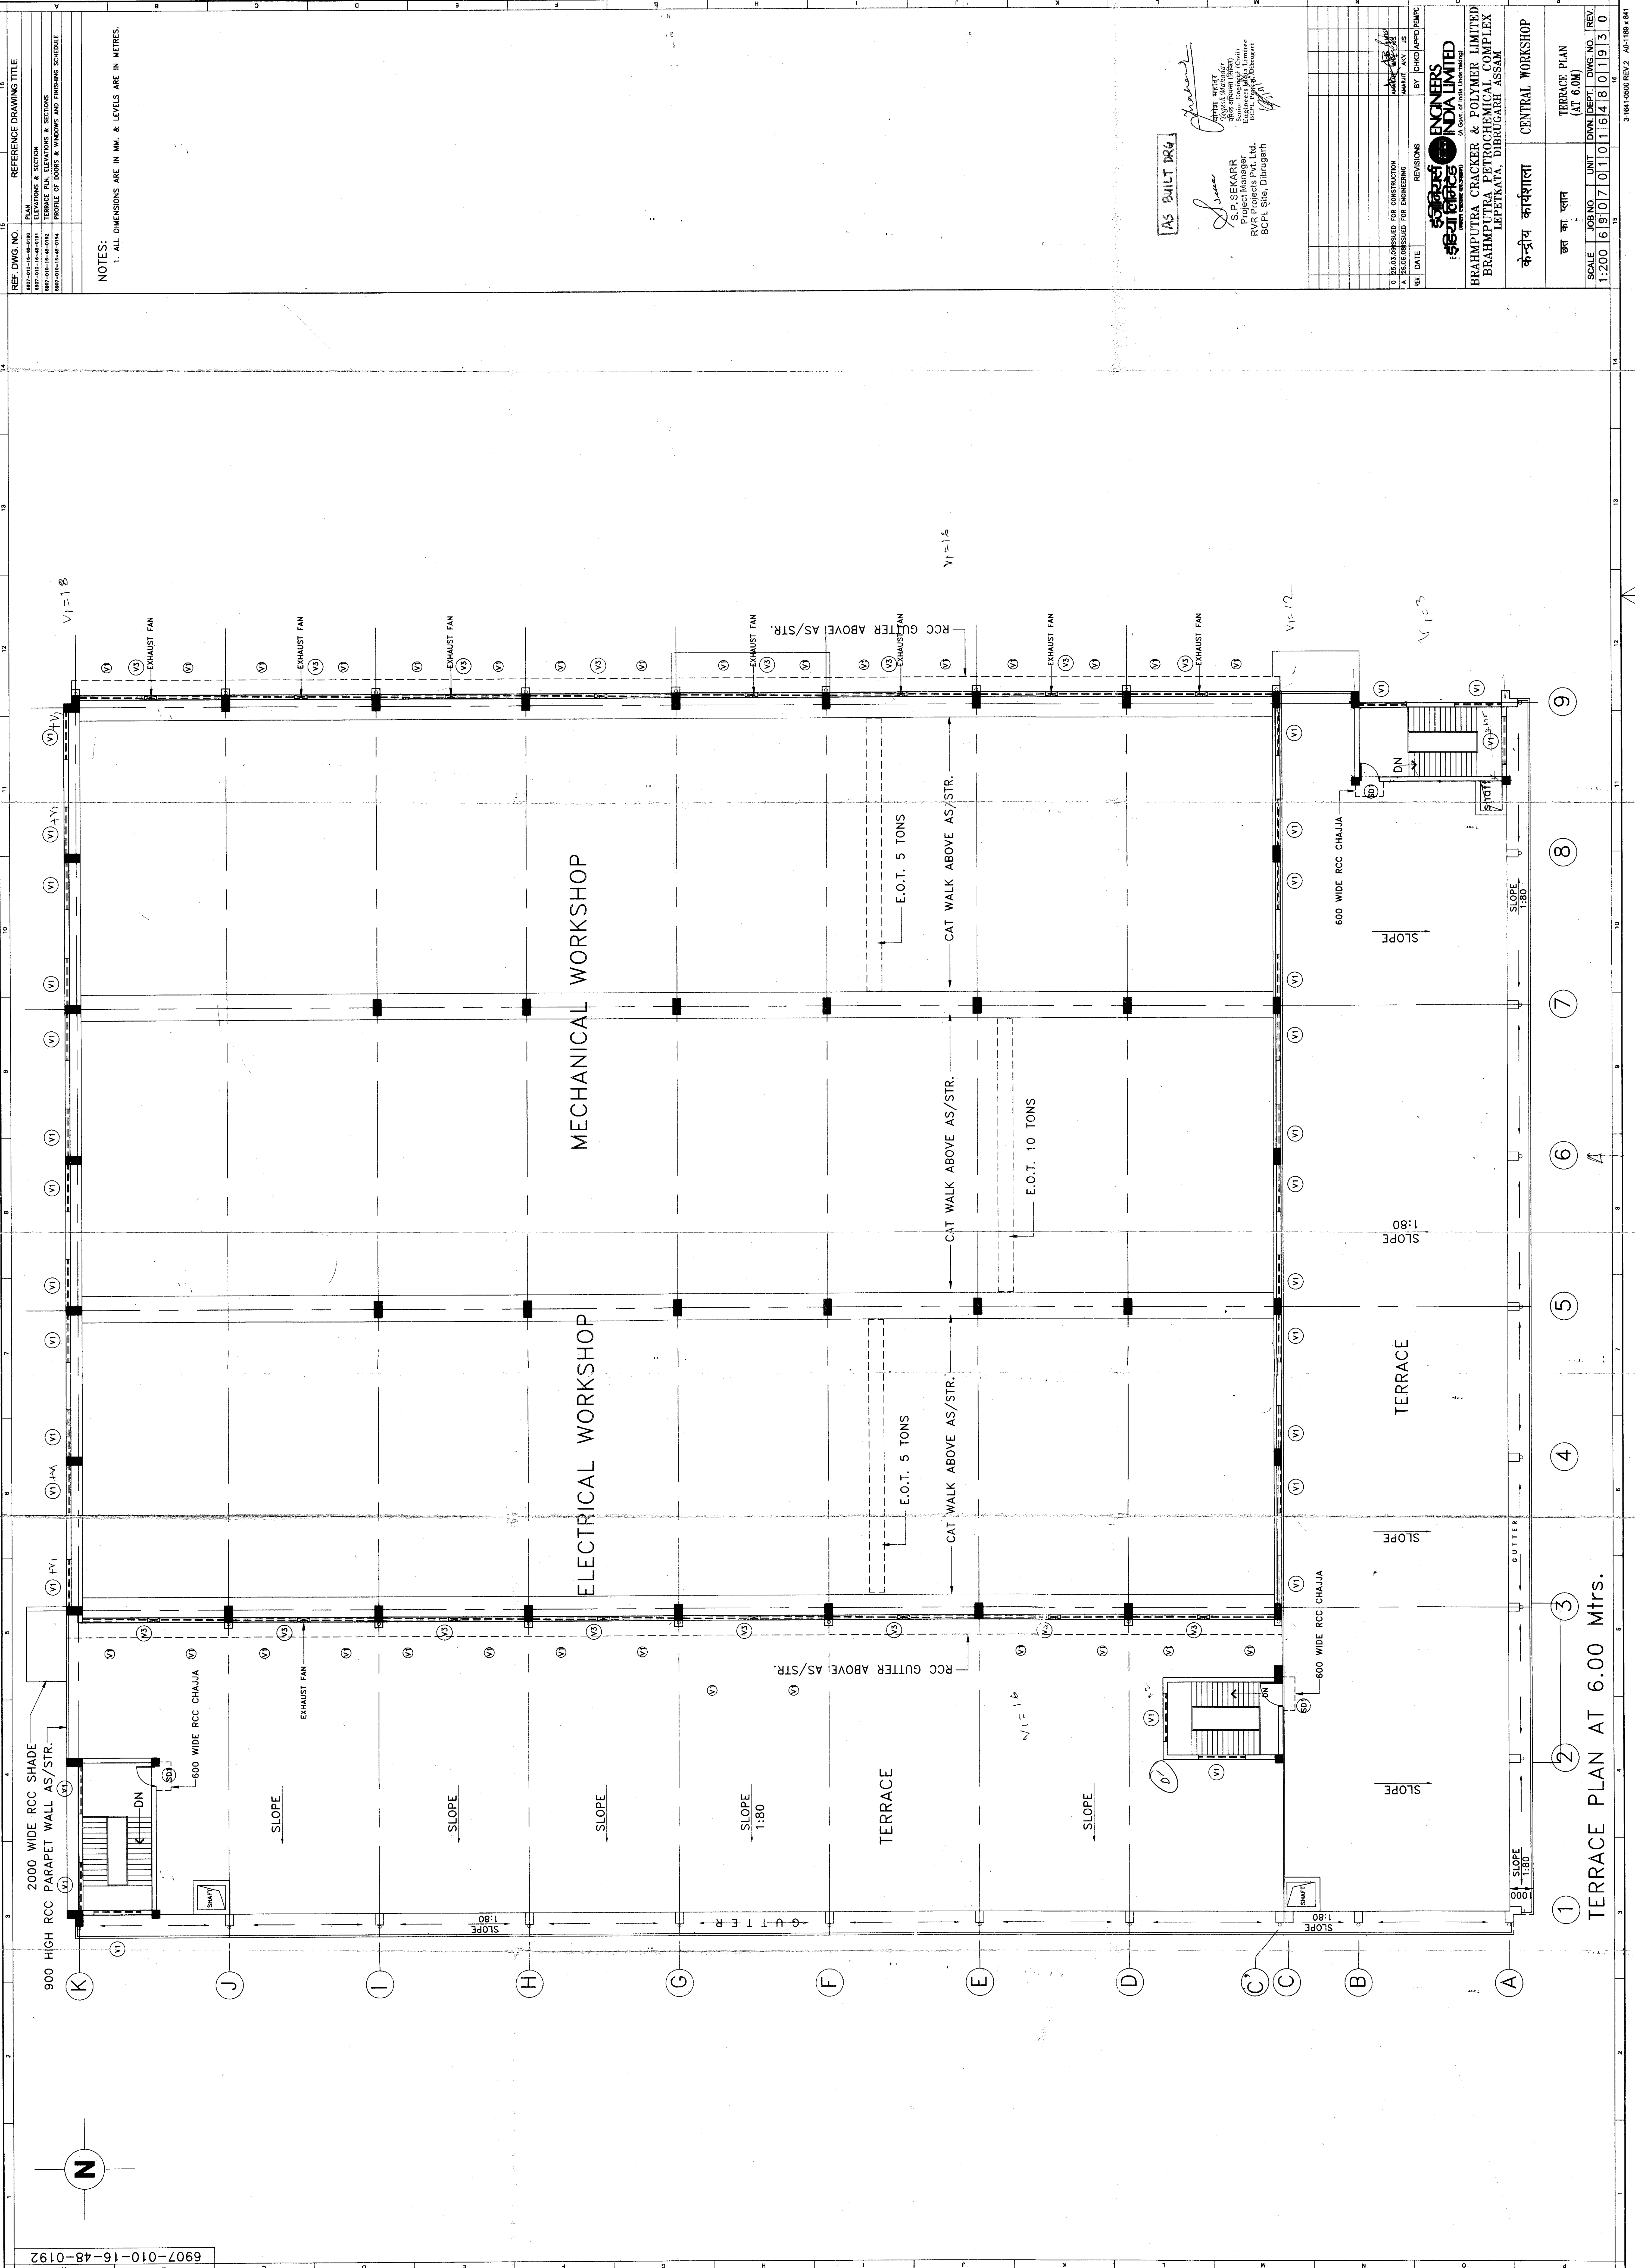

REF. DWG. NO. 6907-010-16-48-0192

PROJECT TITLE
BRAHMPUTRA CRACKER & POLYMER LIMITED
BRAHMPUTRA PETROCHEMICAL COMPLEX
LEPTEKATA, DIBRUGARH ASSAM


BY (CHKD) APPRO. REMARKS

NOTES:
1. ALL DIMENSIONS ARE IN MM. & LEVELS ARE IN METRES.

AS BUILT DRG

PROJECT MANAGER
RVA Projects Pvt. Ltd.
BCPL Site, Dibrugarh




ENGINEERS INDIA LIMITED




SCALE	JOB NO.	UNIT	DWN. DEPT.	DWG. NO.	REV.
1:200	6907	01	01	1648	01930


CENTRAL WORKSHOP

TERACE PLAN (AT 6.0M)

The drawing design and details given on this format are the property of ENGINEERS INDIA LIMITED. They are merely loaned on the borrower's express agreement that they will not be reproduced, copied, exhibited or used, except in the limited way permitted by a written consent given by the lender to the borrower for the intended use.