प्रस्तुत आरेख एवं इसमें निहित डिज़ाइन इंजीनियर्स [illegible] लिमिटेड की संपत्ति है। ये मात्र उधार दिए गए है और उधारकर्ता ने यह स्पष्ट समझौता किया है कि न तो उन्हें पुनः मुद्रित किया जाएगा, न नकल की जाएगी, न उधार दिए जाएंगे, न प्रदर्शित किए जाएंगे और न ही सीमित और निजी प्रयोग के अलावा इनका कोई अन्य प्रयोग होगा और [illegible] लिखित रूप में दी गई सहमति से होगा।

The drawing, design and details given on this format are the property of ENGINEERS INDIA LIMITED. They are merely loaned on the borrower's express agreement that they will not be reproduced, copied, exhibited or used, except in the limited way permitted by a written consent given by the lender to the borrower for the intended use.

6907-010-16-48-0-325

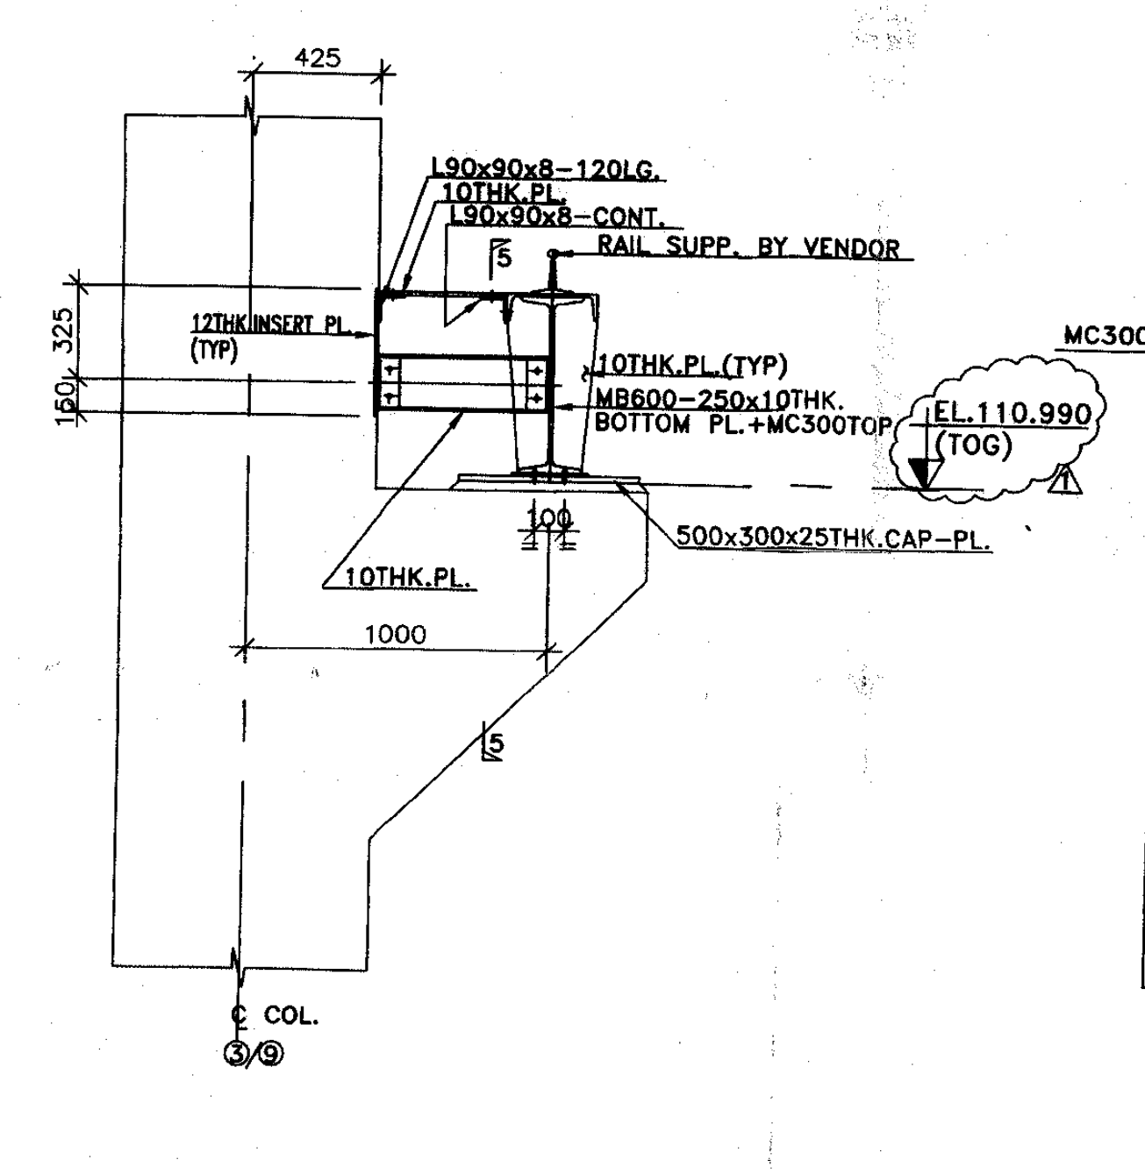

SECTION 1-1

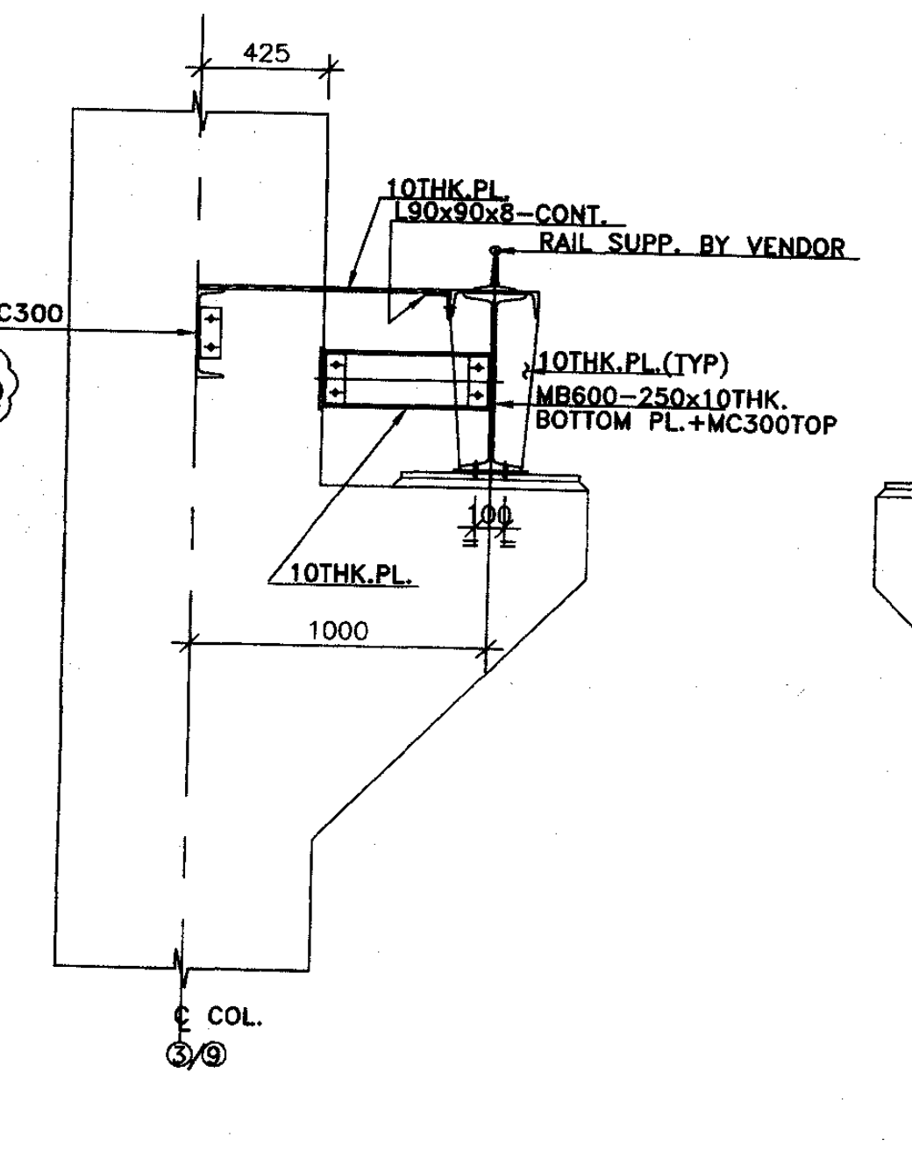

SECTION 2-2

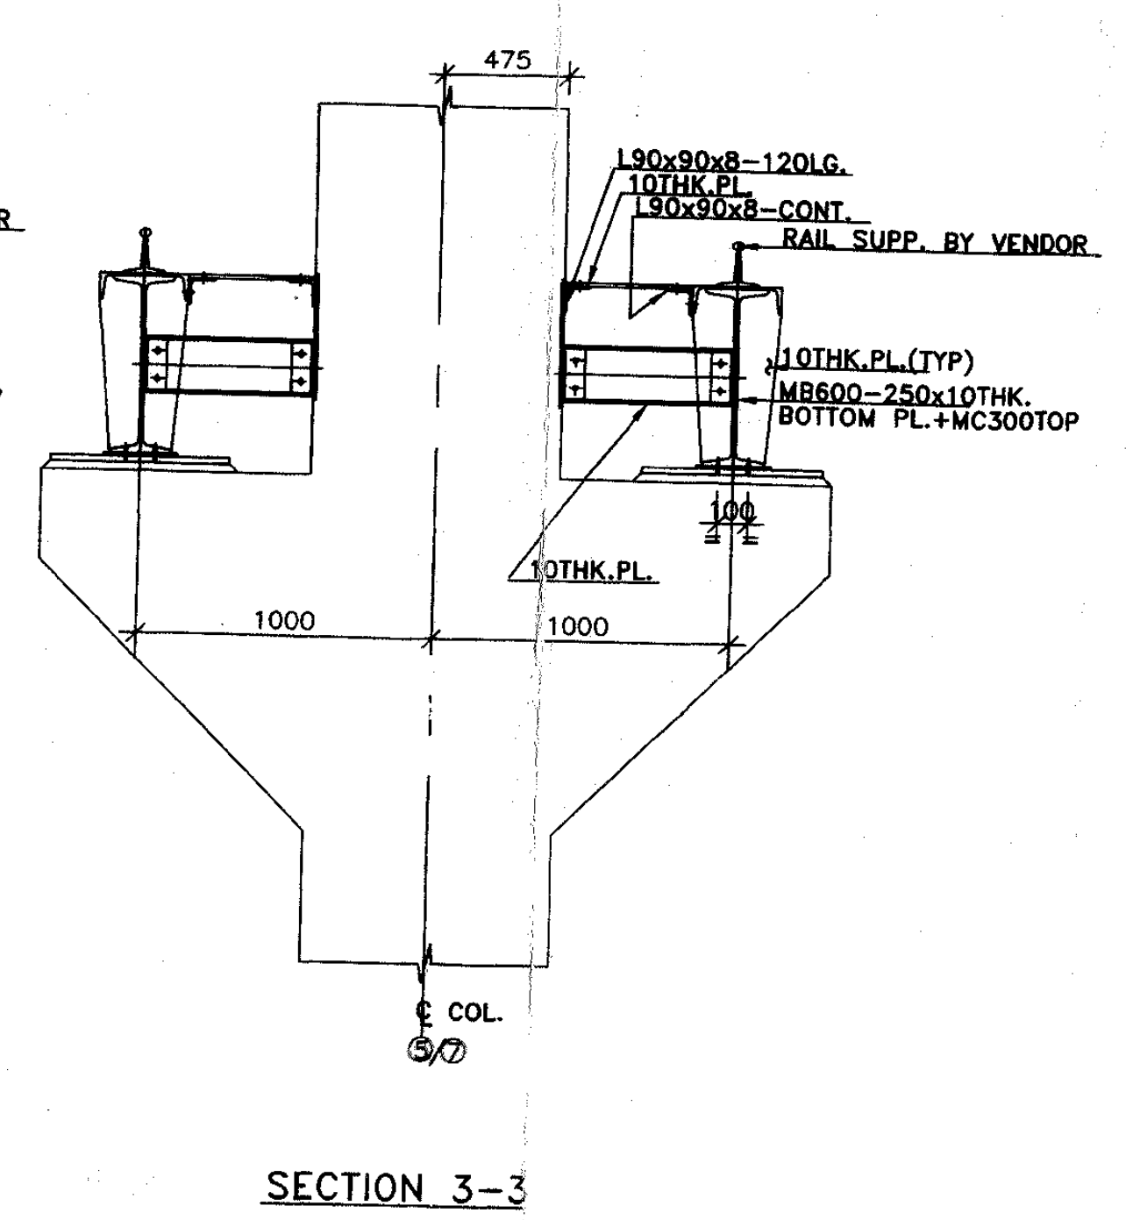

SECTION 3-3

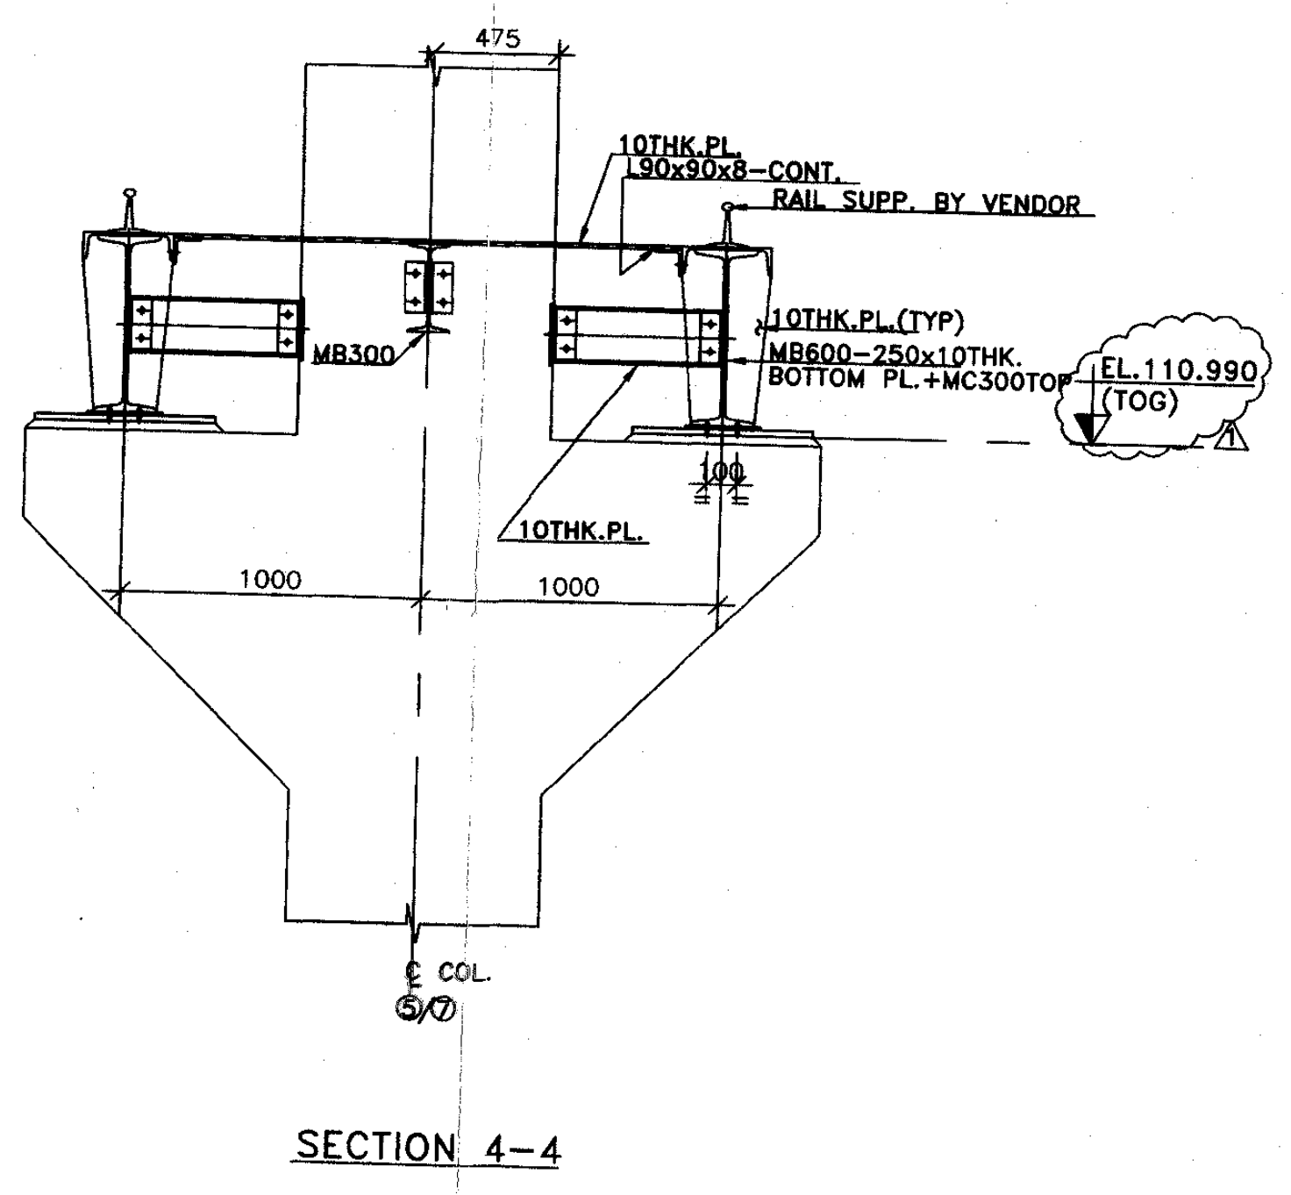

SECTION 4-4

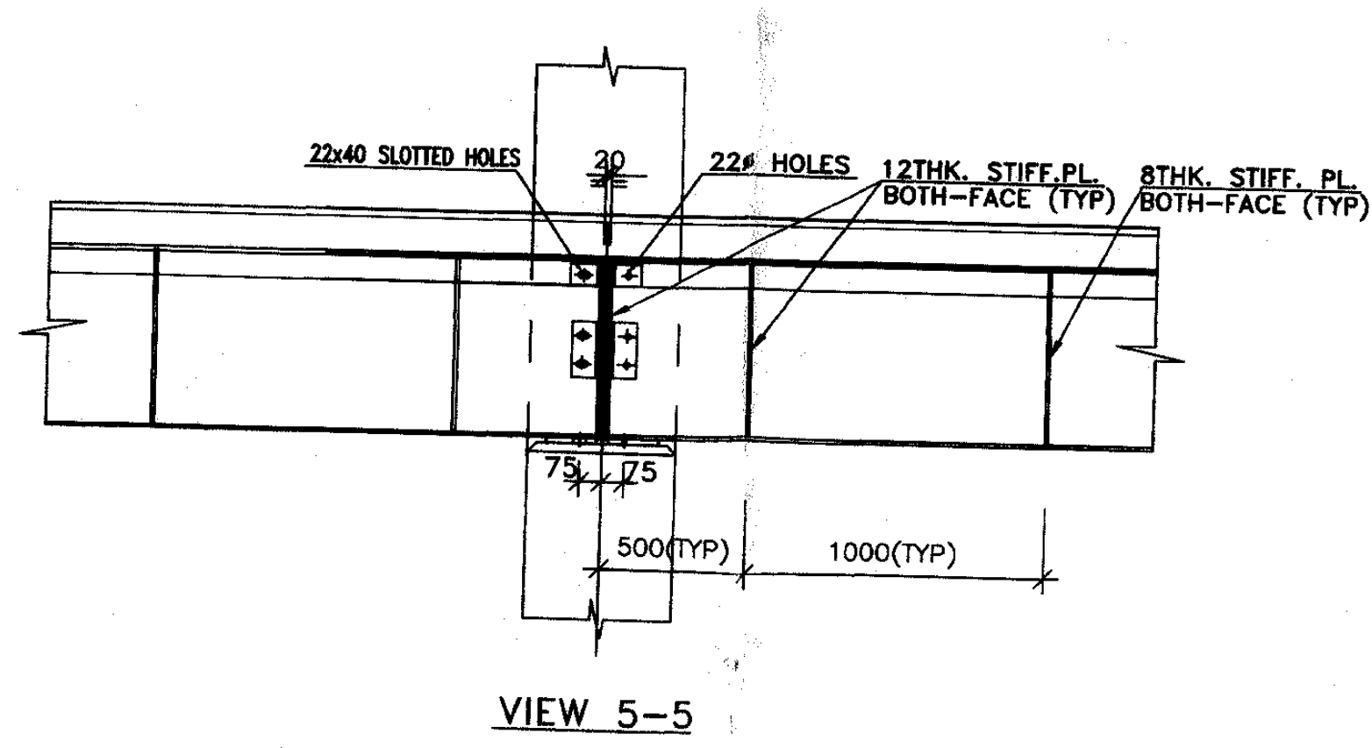
22x40 SLOTTED HOLES
20
22ø HOLES
12THK. STIFF.PL. BOTH-FACE (TYP)
8THK. STIFF. PL. BOTH-FACE (TYP)
75
75
500(TYP)
1000(TYP)

VIEW 5-5

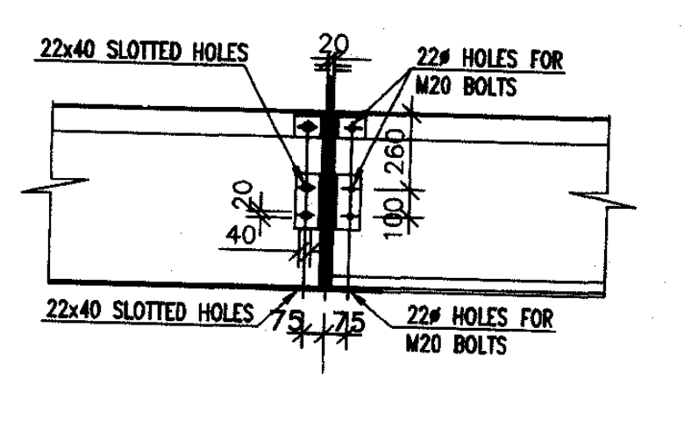

FIXING DET. OF CRANE-GIRDER(TYP)

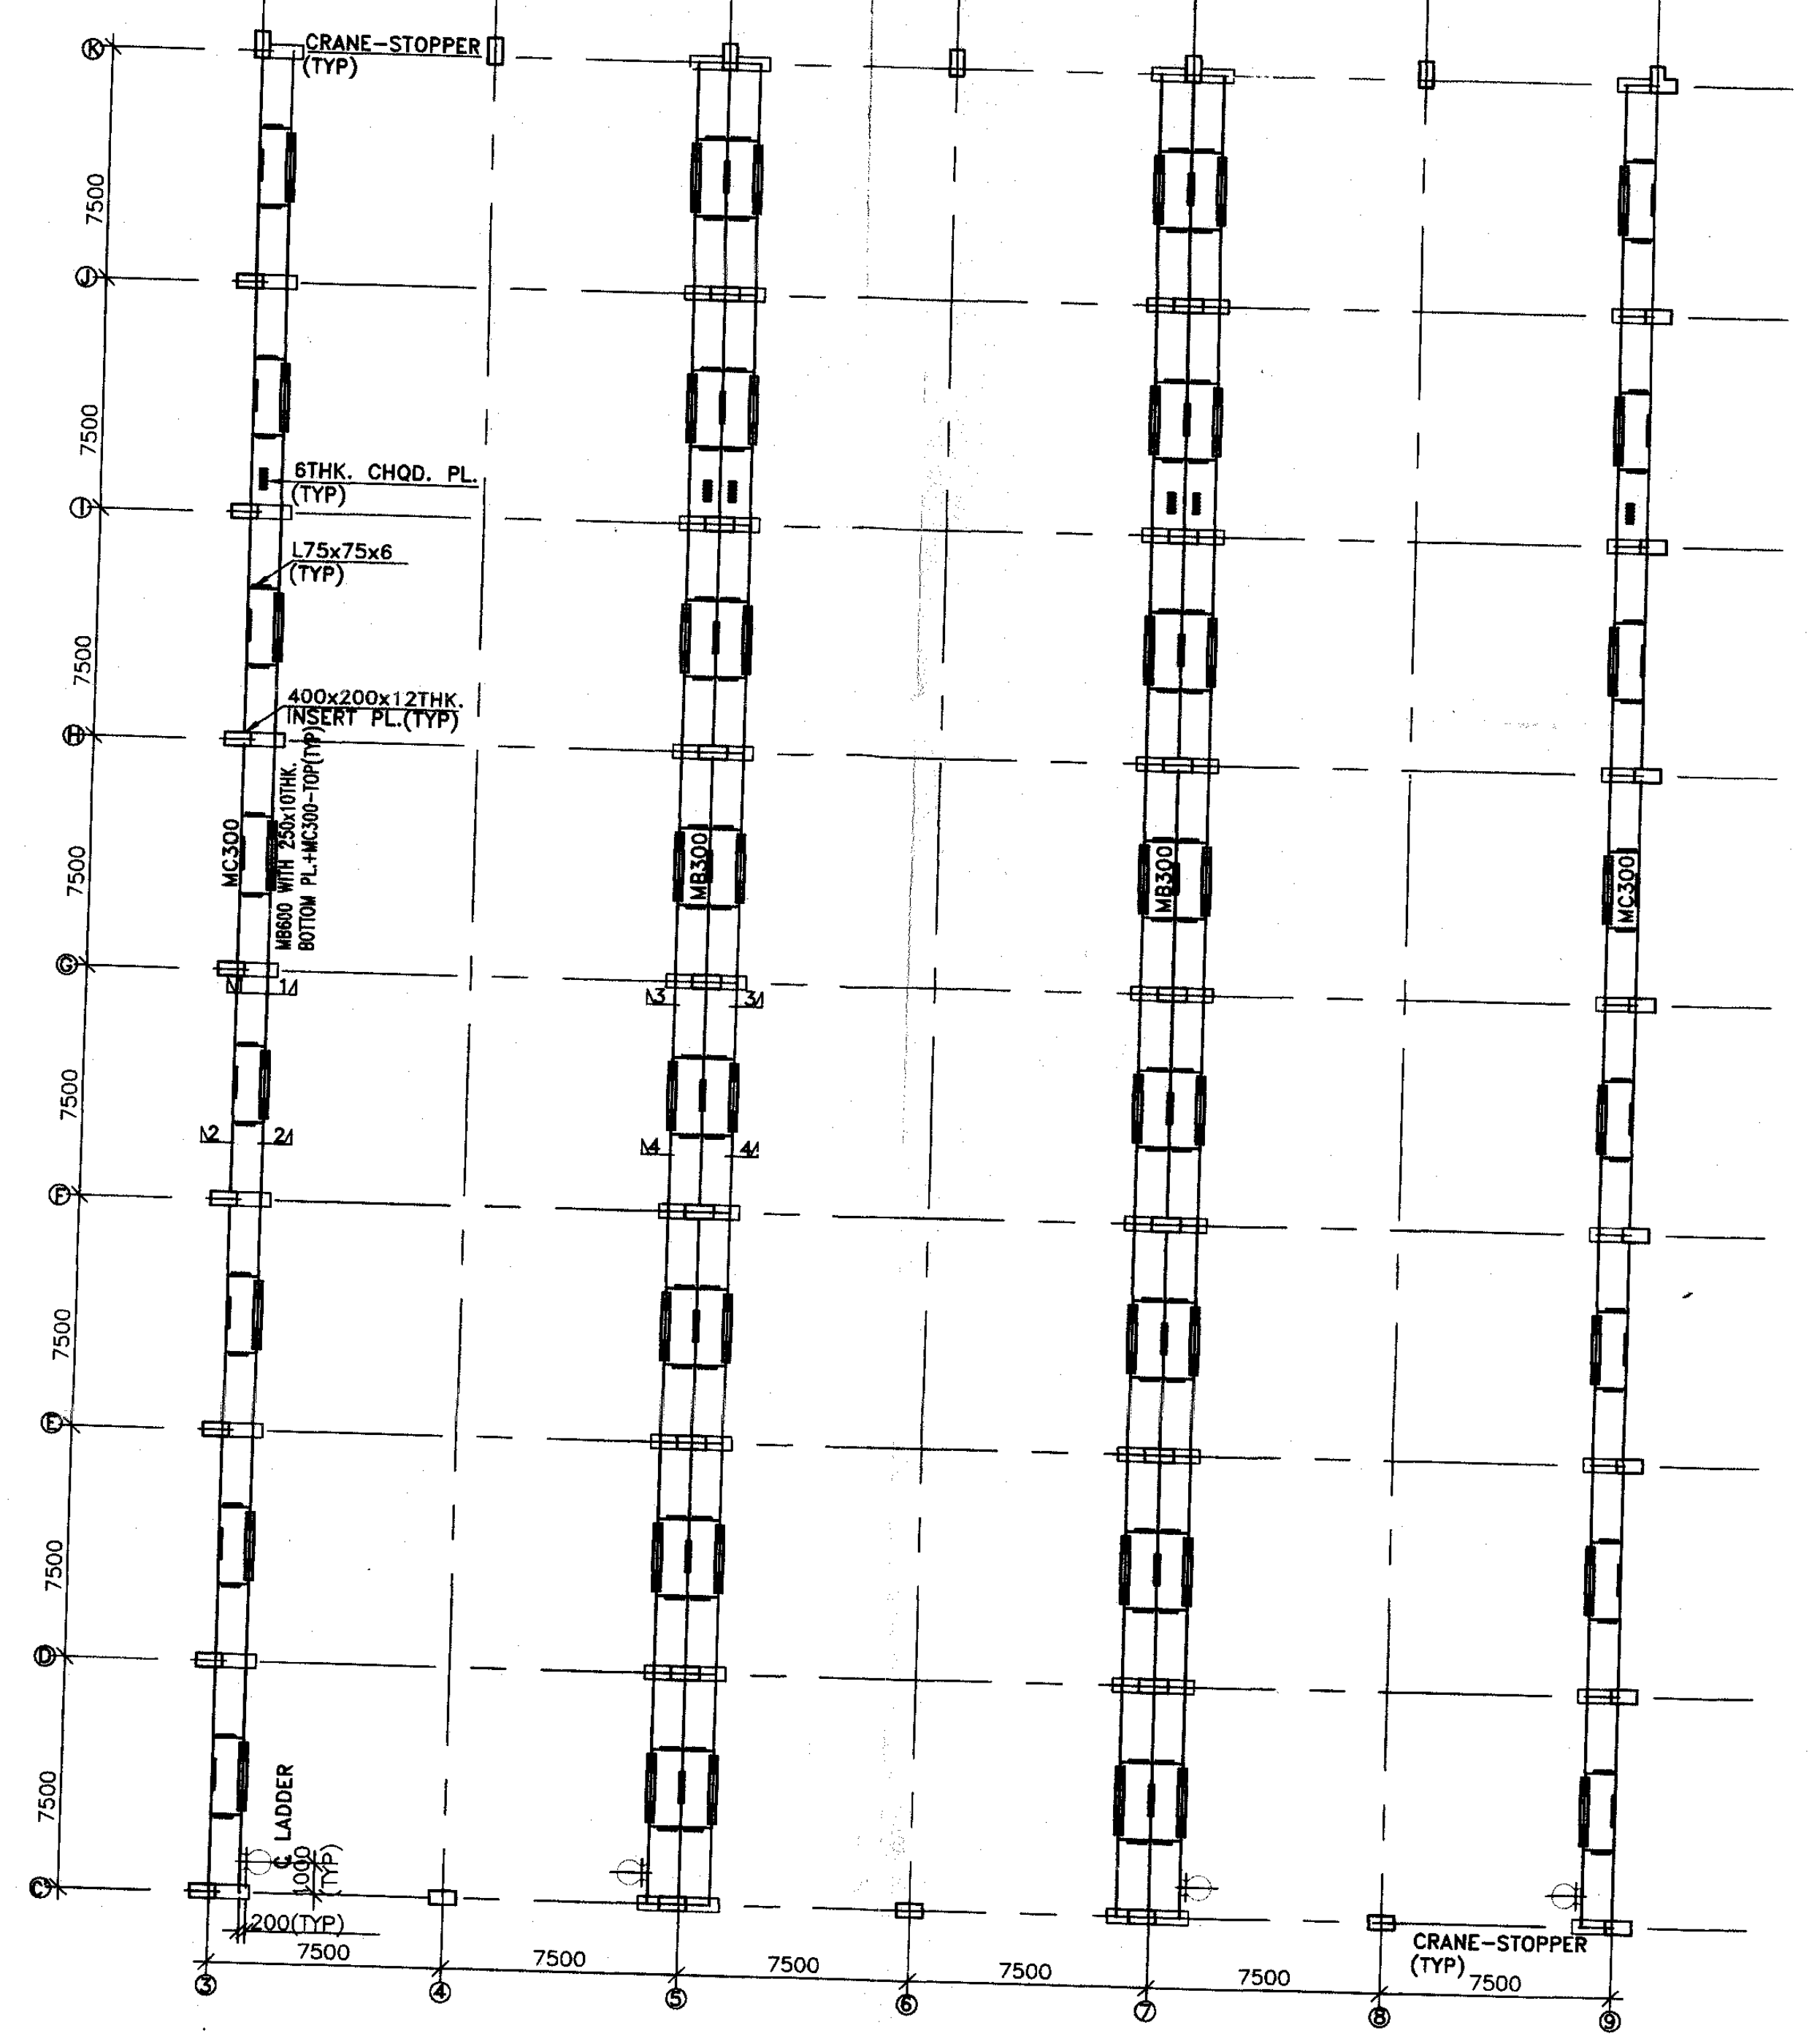

PLAN AT CRANE LEVEL
(CRANE CAPACITY 15.00T)

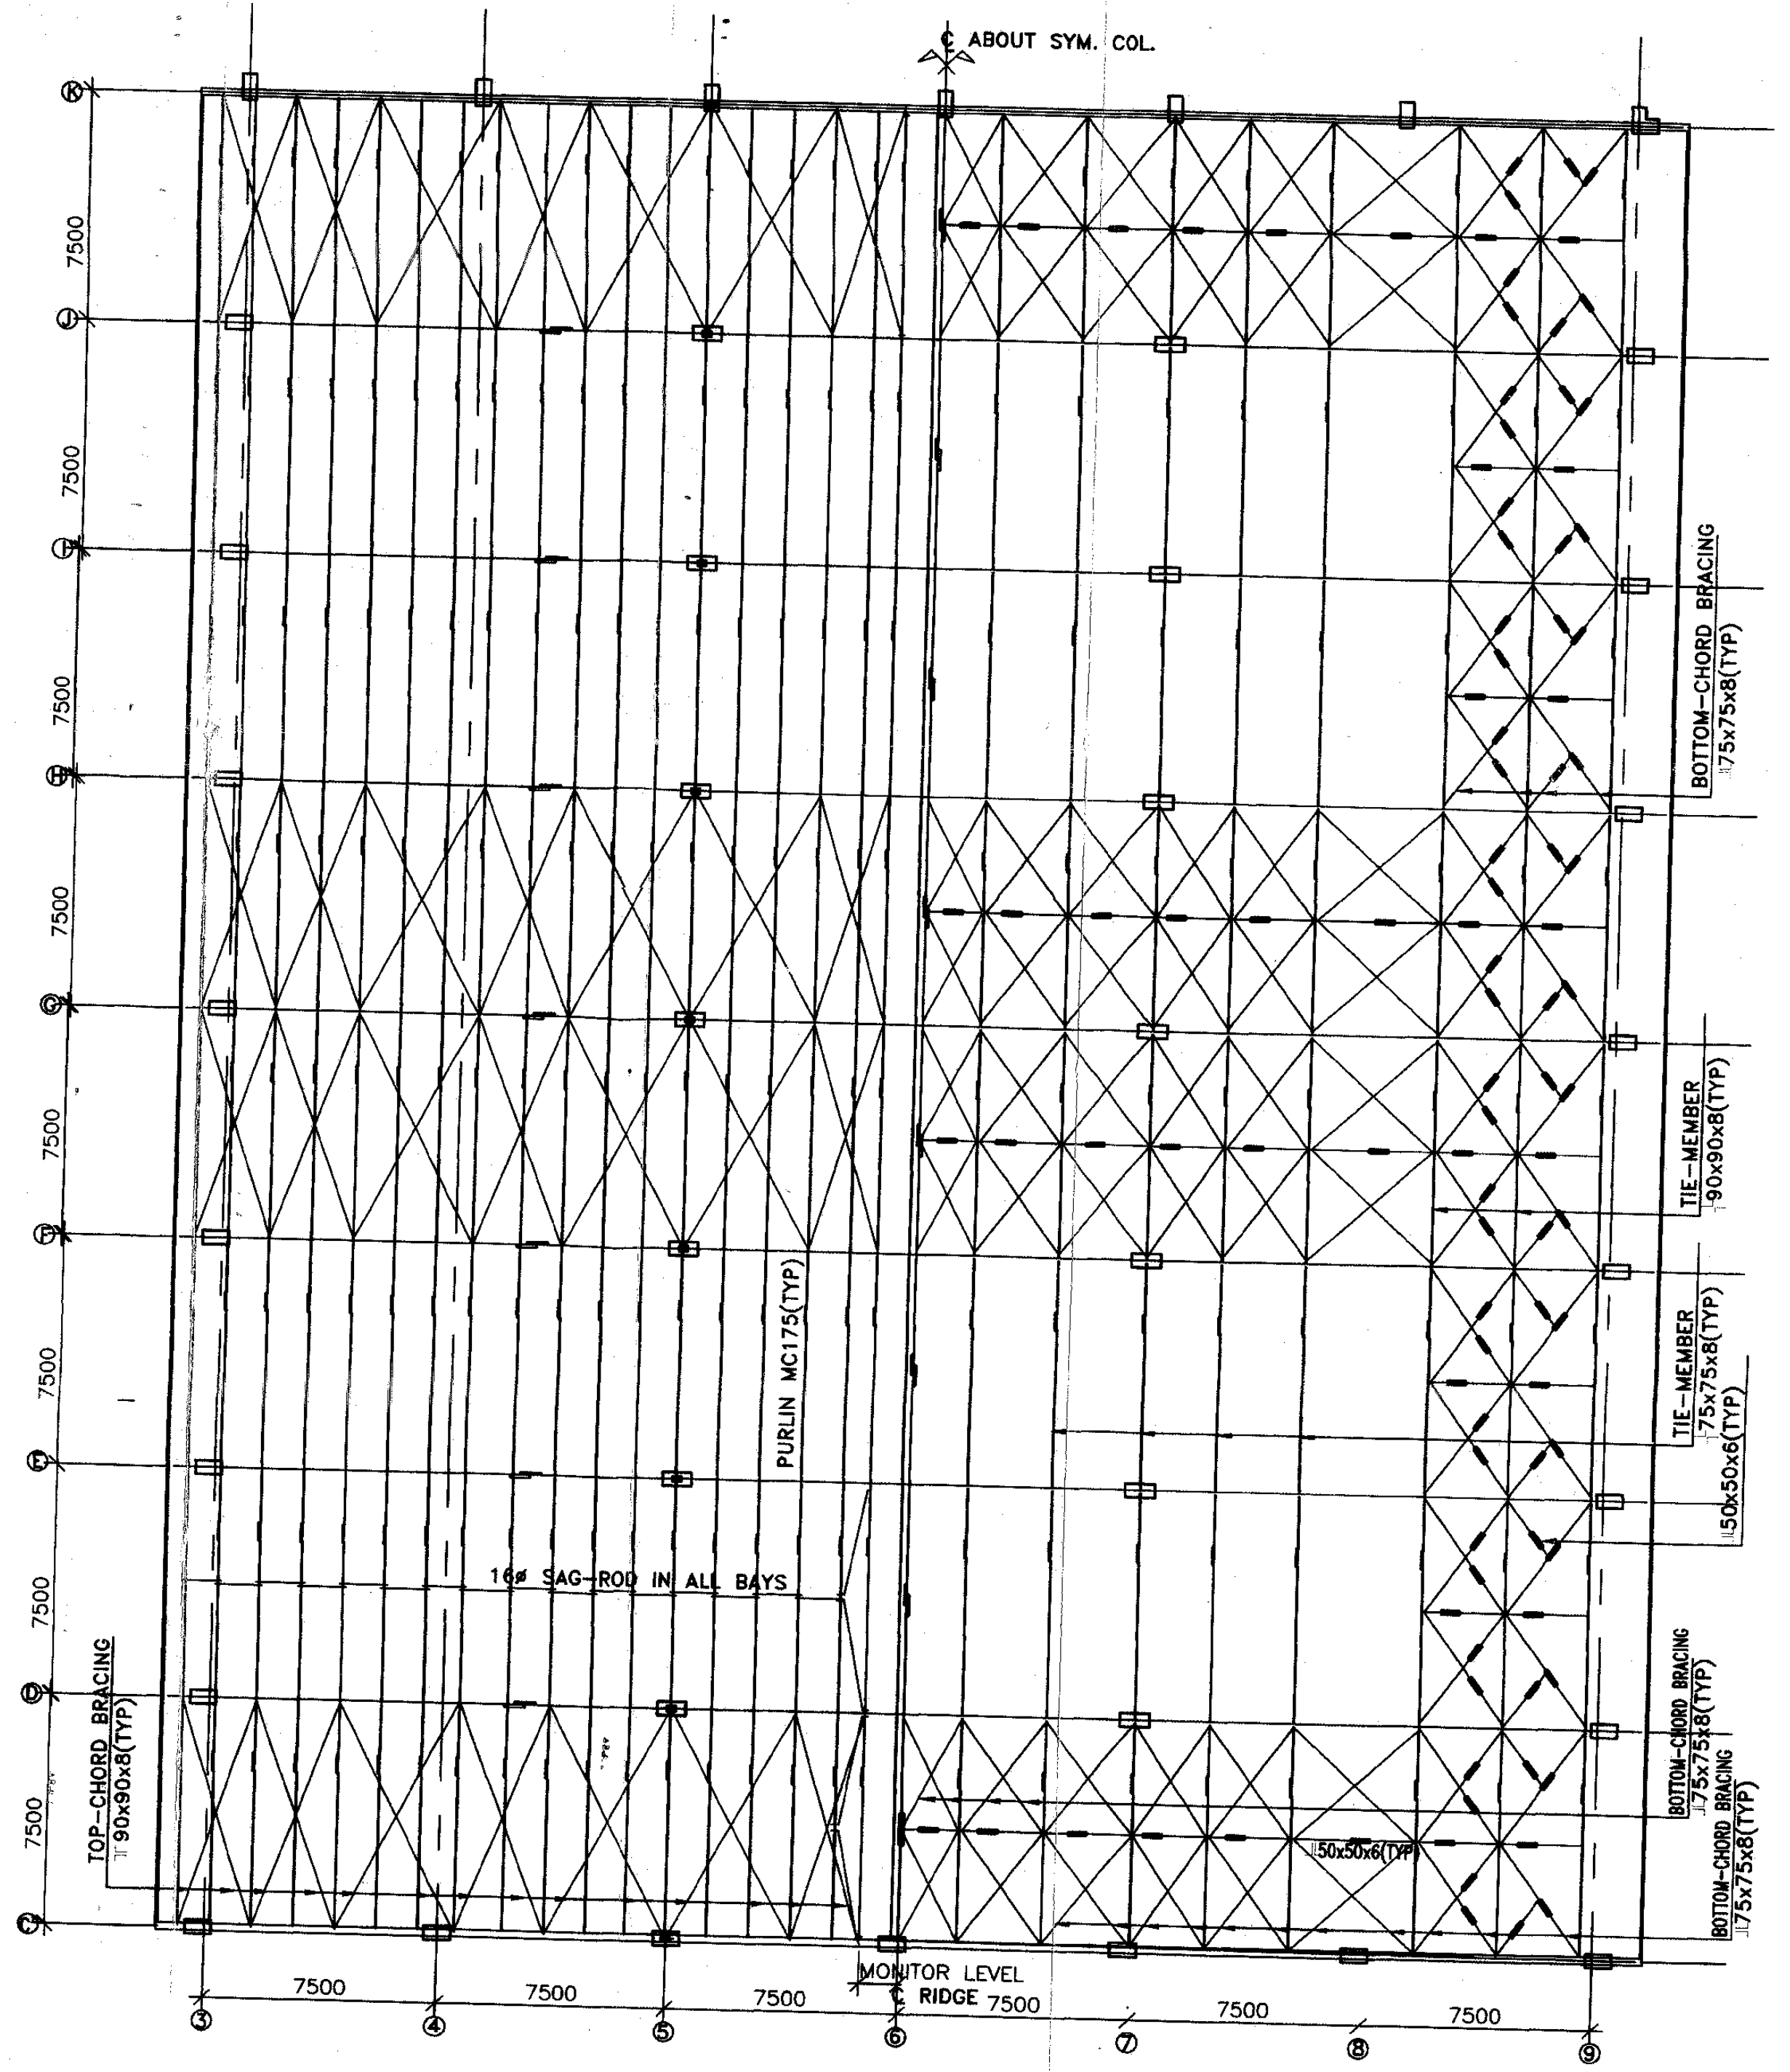

PLAN TOP CHORD BRACING

PLAN BOTTOM CHORD BRACING

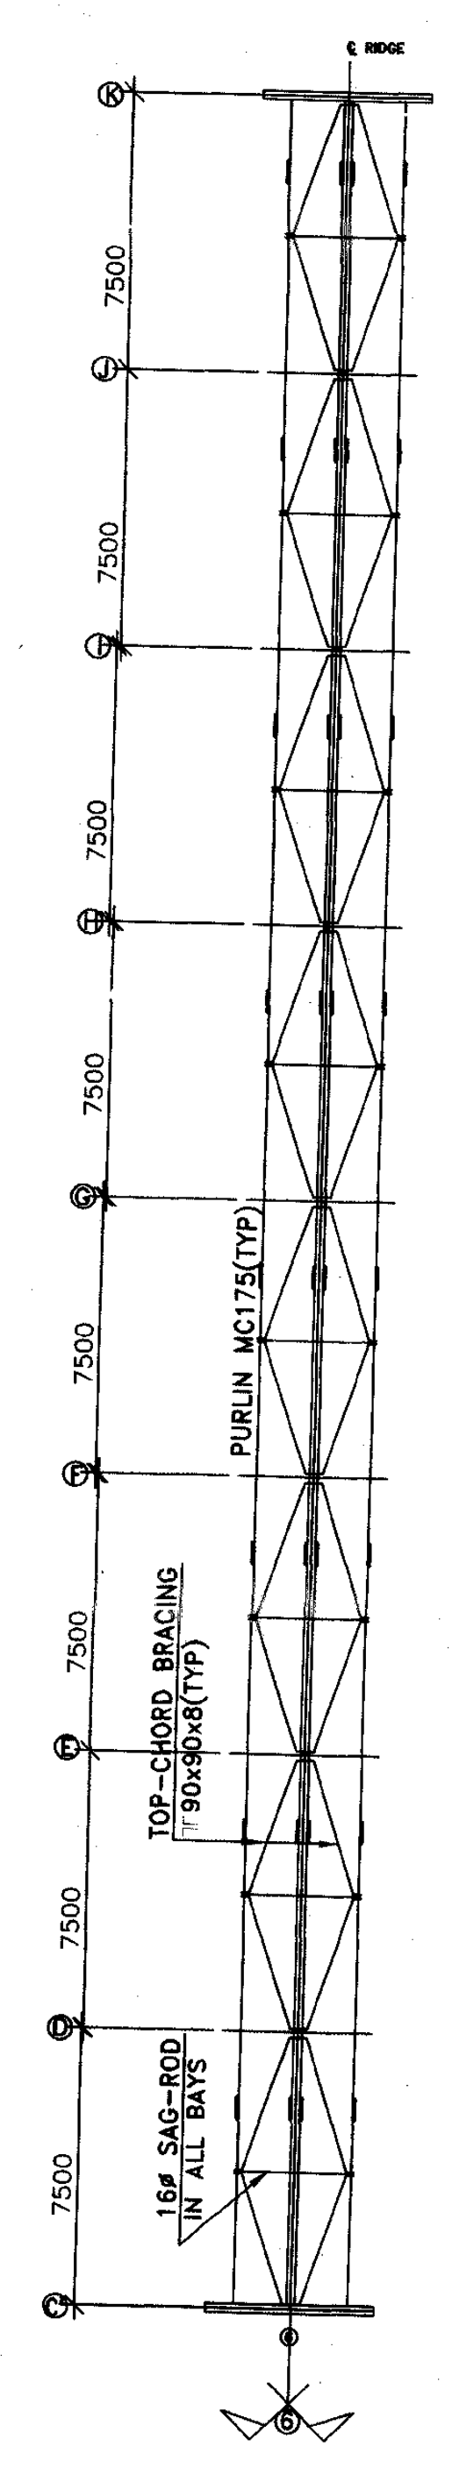

PLAN AT MONITOR
LEVEL (TOP-CHORD)

REF. DWG. NO.	REFERENCE DRAWING TITLE
6907-010-16-48-0-190	CENTRAL WORKSHOP- GROUND FLOOR PLAN
6907-010-16-48-0-191	CENTRAL WORKSHOP -ELEVATIONS & SECTION
6907-010-16-48-0-192	CENTRAL WORKSHOP- TERRACE FLOOR PLAN

NOTES :-

1. ALL DIMENSION ARE IN mm AND LEVELS ARE IN M.
2. FOR GENERAL NOTES REFER DWG. NO. 6907-000-16-48-1-251
3. ALL ELEVATIONS CORRESPOND TO ABSOLUTE RLS.
4. THIS DRG SHALL BE READ IN CONJUNCTION WITH DRG. No. 6907-010-16-48-0-321 & 0-324.

STRL. STEEL QUANTITY

ITEM	QTY.(MT)
ISMB 600	44.00
ISMC 300	20.70
ISMC 250	07.00
ISMC 175	37.00
L 90x90x8	38.20
L 75x75x8	41.20
L 65x65x6	06.60
L 50x50x6	06.70
25THK. PL.	05.00
16THK. PL.	05.00
12THK. PL.	10.00
10THK. PL.	10.00
8THK. PL.	03.00
TOTAL	235.70

AS BUILT DRG

S.P.SEKARR
Project Manager
RVR Projects Pvt. Ltd.
BCPL Site, Dibrugarh

योगेश महादर
Yogesh Mahadar
वरिष्ठ अभियन्ता (सिविल)
Senior Engineer (Civil)
Engineers India Limited
BCPL Project, Dibrugarh

REVISION-1
EL. REVISED AS PER LATEST GEN. CIVIL LAYOUT.

REV.	DATE	REVISIONS	BY	CHKD	APPD	PEM/PC
1	07072009	REVISED AS MKD.-1	Yogesh			
0	04 03 2009	ISSUED FOR CONSTRUCTION	Yogesh	VARA		

CONSULTANT:
इंजीनियर्स इंडिया लिमिटेड (भारत सरकार का उपक्रम)
ENGINEERS INDIA LIMITED (A Govt. of India Undertaking)

ब्रह्मपुत्र क्रैकर एवं पोलिमर लिमिटेड
BCPL BRAHMAPUTRA CRACKER AND POLYMER LIMITED
(A Joint Venture Company of GAIL (India) Ltd., OIL, NRL & Govt. of Assam)

ब्रह्मपुत्र पैट्रोकैमिकल कॉम्पलैस
लेपेटकटा, डिब्रूगढ असाम

BRAHMAPUTRA
PETROCHEMICAL COMPLEX
LEPETKATA, DIBRUGARH ASSAM

सेन्ट्रल वर्कशाप
गैन्टरी गर्डर, बरेसिंग और परलिन का ब्यौरा

CENTRAL WORKSHOP
DETAIL OF GANTRY GIRDER, BRACINGS & PURLINS

SCALE	JOB NO.	UNIT	DEPT.	SECT.	DWG. NO.	REV.
1:100	6907	010	16	48	0325	1

1-1641-0500 REV.0 A0-1189 x 841

RVR PROJECTS PVT. LTD.
RECEIVED DATE 28/7/09