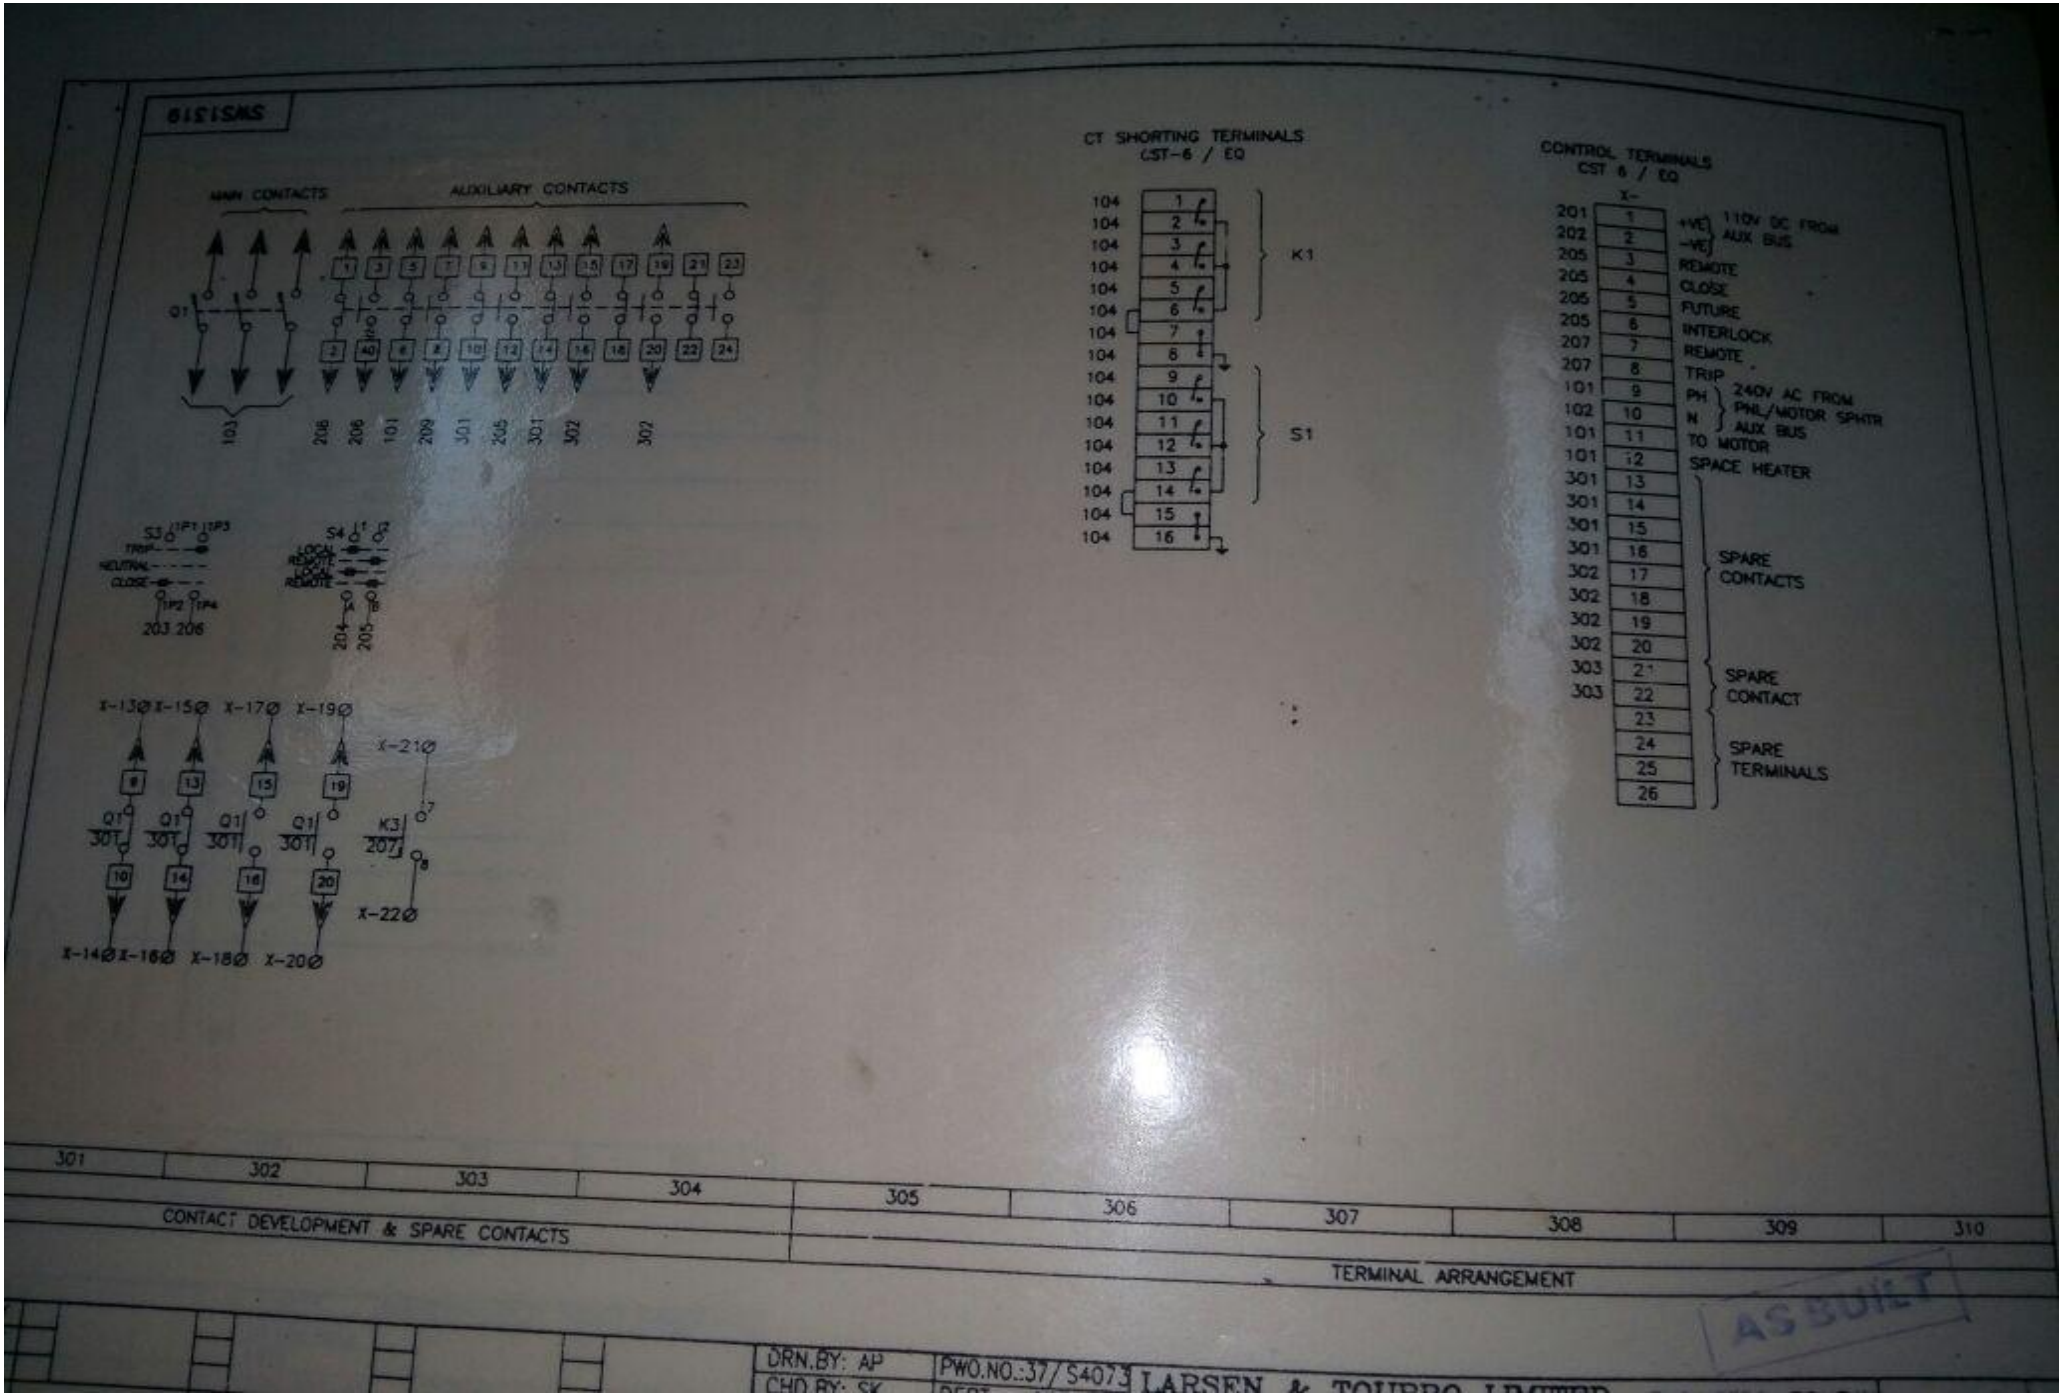


| 301 | 302 | 303 | 304 | 305 | 306 | 307 | 308 | 309 | 310 |
|---|---|---|---|---|---|---|---|---|---|
| CONTACT DEVELOPMENT & SPARE CONTACTS | | | | TERMINAL ARRANGEMENT | | | | | |

AS BUILT

DRN.BY: AP
CHD.BY: SK
PWO.NO.:37/54073
LARSEN & TOUBRO LIMITED

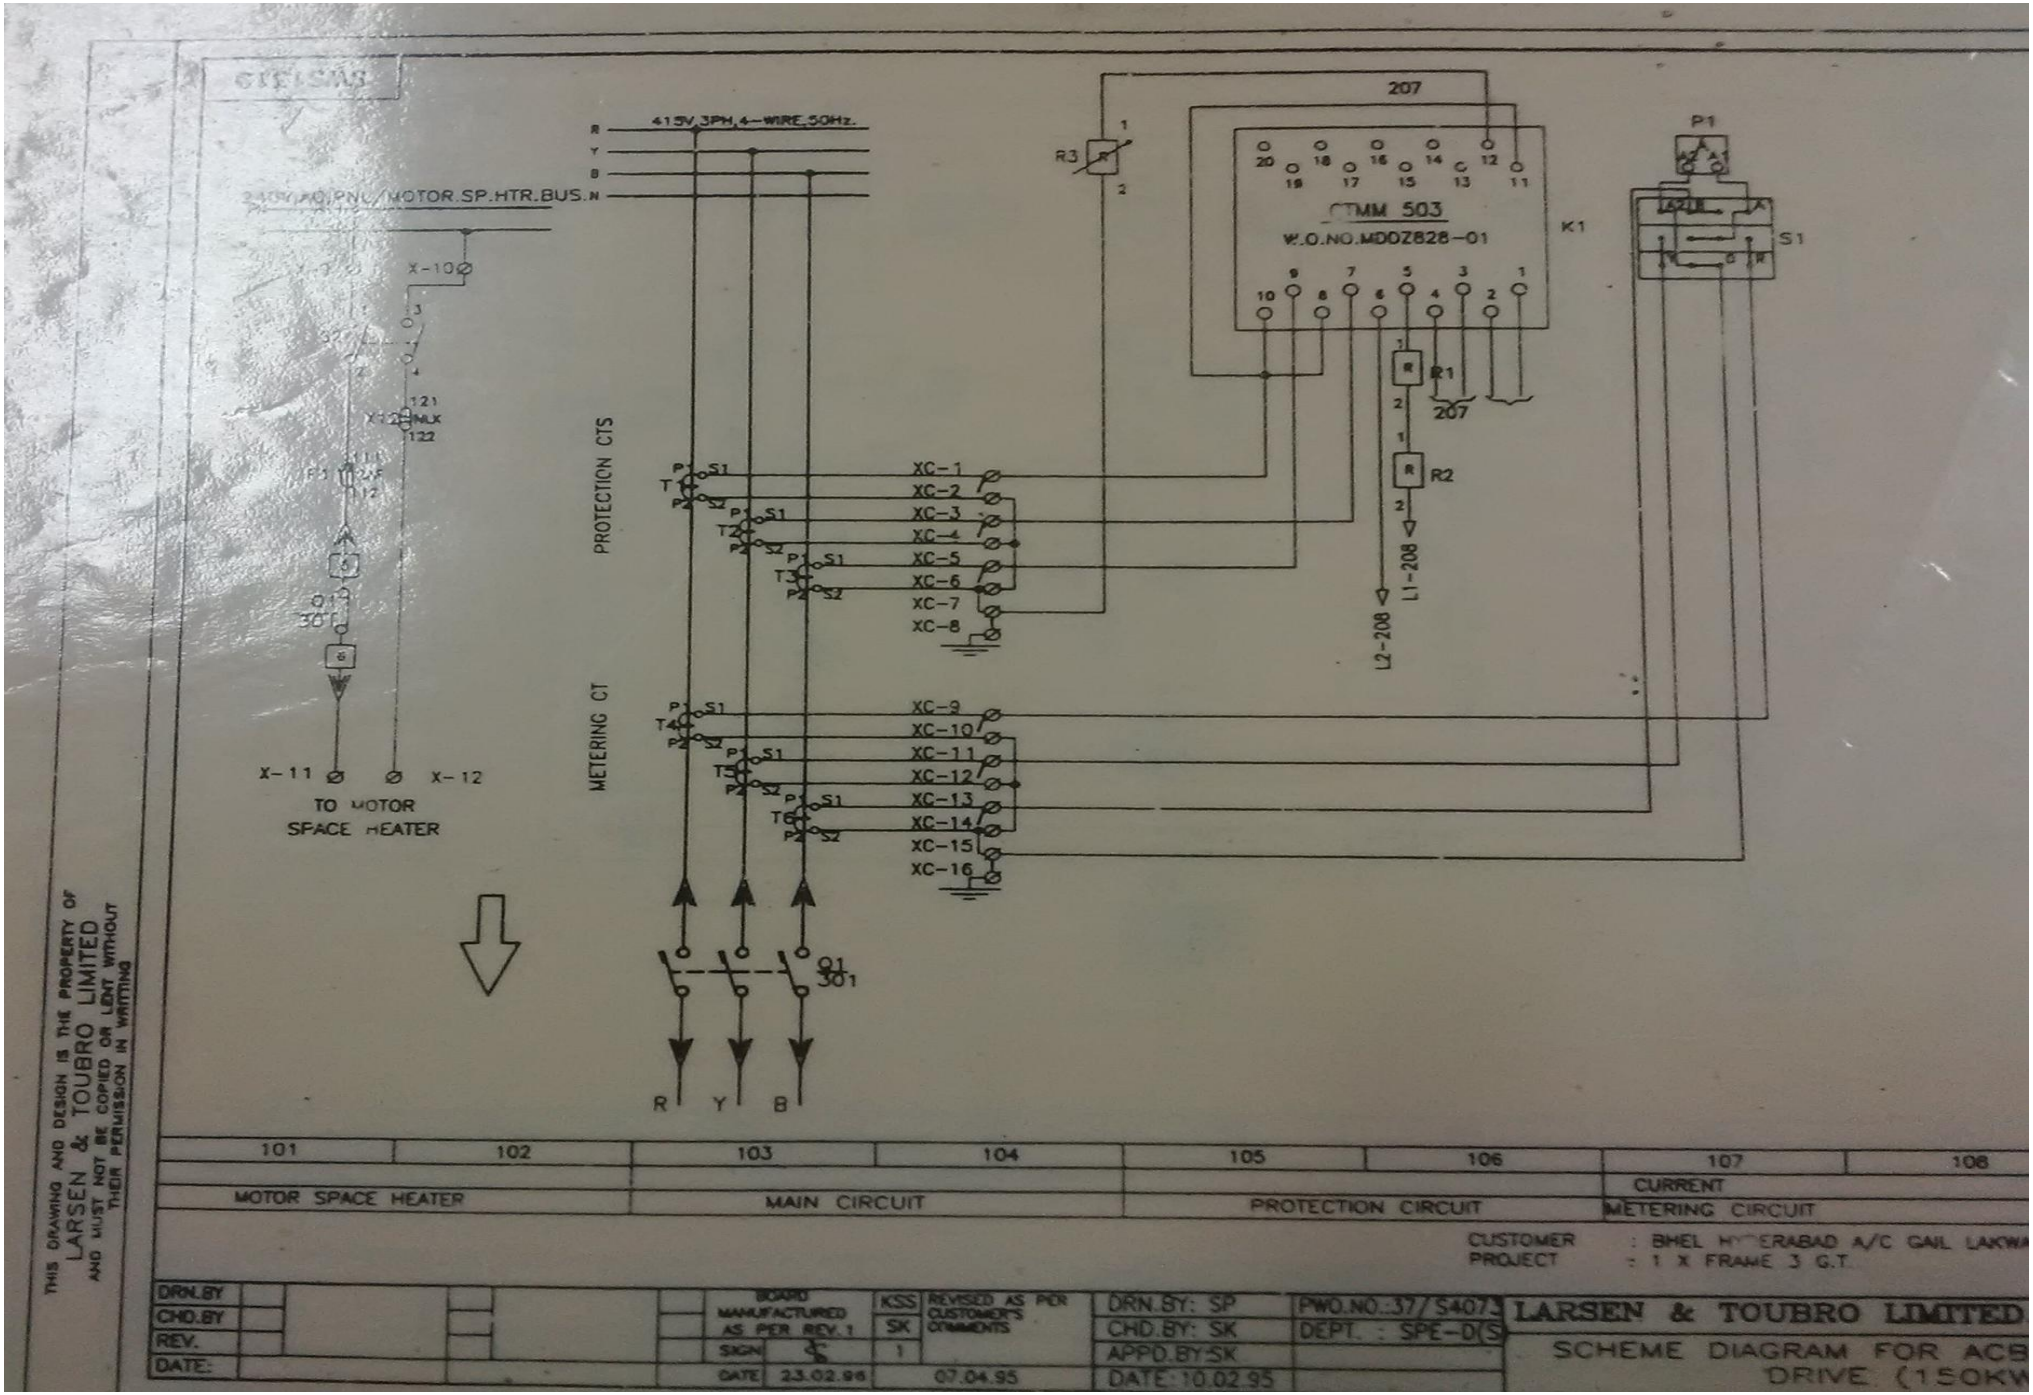
415V,3PH,4-WIRE,50Hz.
R
Y
B
240V,AC,PNL,MOTOR.SP.HTR.BUS.N
X-10
X-11
X-12
TO MOTOR
SPACE HEATER
PROTECTION CTS
METERING CT
XC-1
XC-2
XC-3
XC-4
XC-5
XC-6
XC-7
XC-8
XC-9
XC-10
XC-11
XC-12
XC-13
XC-14
XC-15
XC-16
207
R3
CMM 503
W.O.NO.MDOZ828-01
K1
P1
S1
R1
R2
L1-208
L2-208
Q1
301
THIS DRAWING AND DESIGN IS THE PROPERTY OF
LARSEN & TOUBRO LIMITED
AND MUST NOT BE COPIED OR LENT WITHOUT
THEIR PERMISSION IN WRITING
101
102
103
104
105
106
107
108
MOTOR SPACE HEATER
MAIN CIRCUIT
PROTECTION CIRCUIT
CURRENT
METERING CIRCUIT
CUSTOMER : BHEL HYDERABAD A/C GAIL LAKWA
PROJECT : 1 X FRAME 3 G.T.
DRN.BY
CHD.BY
REV.
DATE:
BOARD MANUFACTURED AS PER REV. 1
SIGN
DATE 23.02.96
KSS
SK
1
REVISED AS PER CUSTOMER'S COMMENTS
07.04.95
DRN.BY: SP
CHD.BY: SK
APPD.BY:SK
DATE:10.02.95
PWO.NO.:37/S4073
DEPT. : SPE-D(S)
LARSEN & TOUBRO LIMITED
SCHEME DIAGRAM FOR ACE
DRIVE (150KW

THIS DRAWING AND DESIGN IS THE PROPERTY OF LARSEN & TOUBRO LIMITED AND MUST NOT BE COPIED OR LENT WITHOUT THEIR PERMISSION IN WRITING

SWS1319

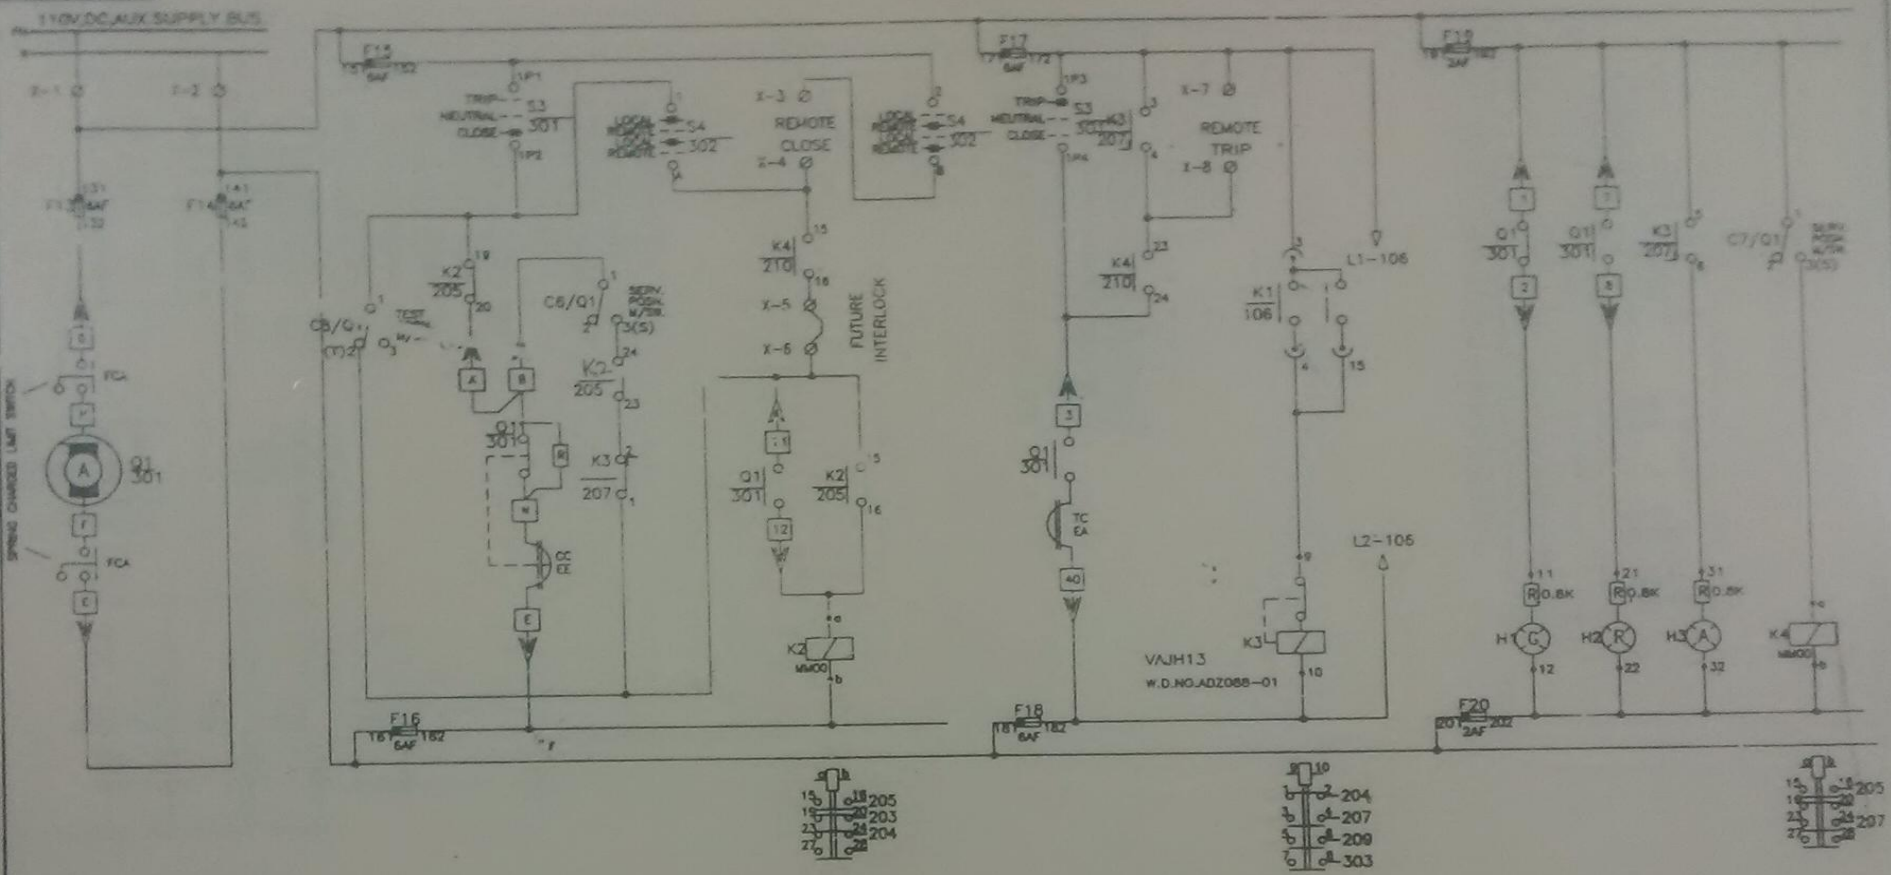


| 201 | 202 | 203 | 204 | 205 | 206 | 207 | 208 | 209 | | 210 |
|---|---|---|---|---|---|---|---|---|---|---|
| | | CLOSING COIL | | ANTIPUMPING | TRIP COIL | TRIP COMMANDS | OFF | ON | AUTO TRIP | SERVICE POS. |
| SPRING CHARGING CIRCUIT | | CLOSING CIRCUIT | | | TRIP CIRCUIT | | INDICATION CIRCUIT | | | MULTIPLIER |

AS BUILT

| | | |